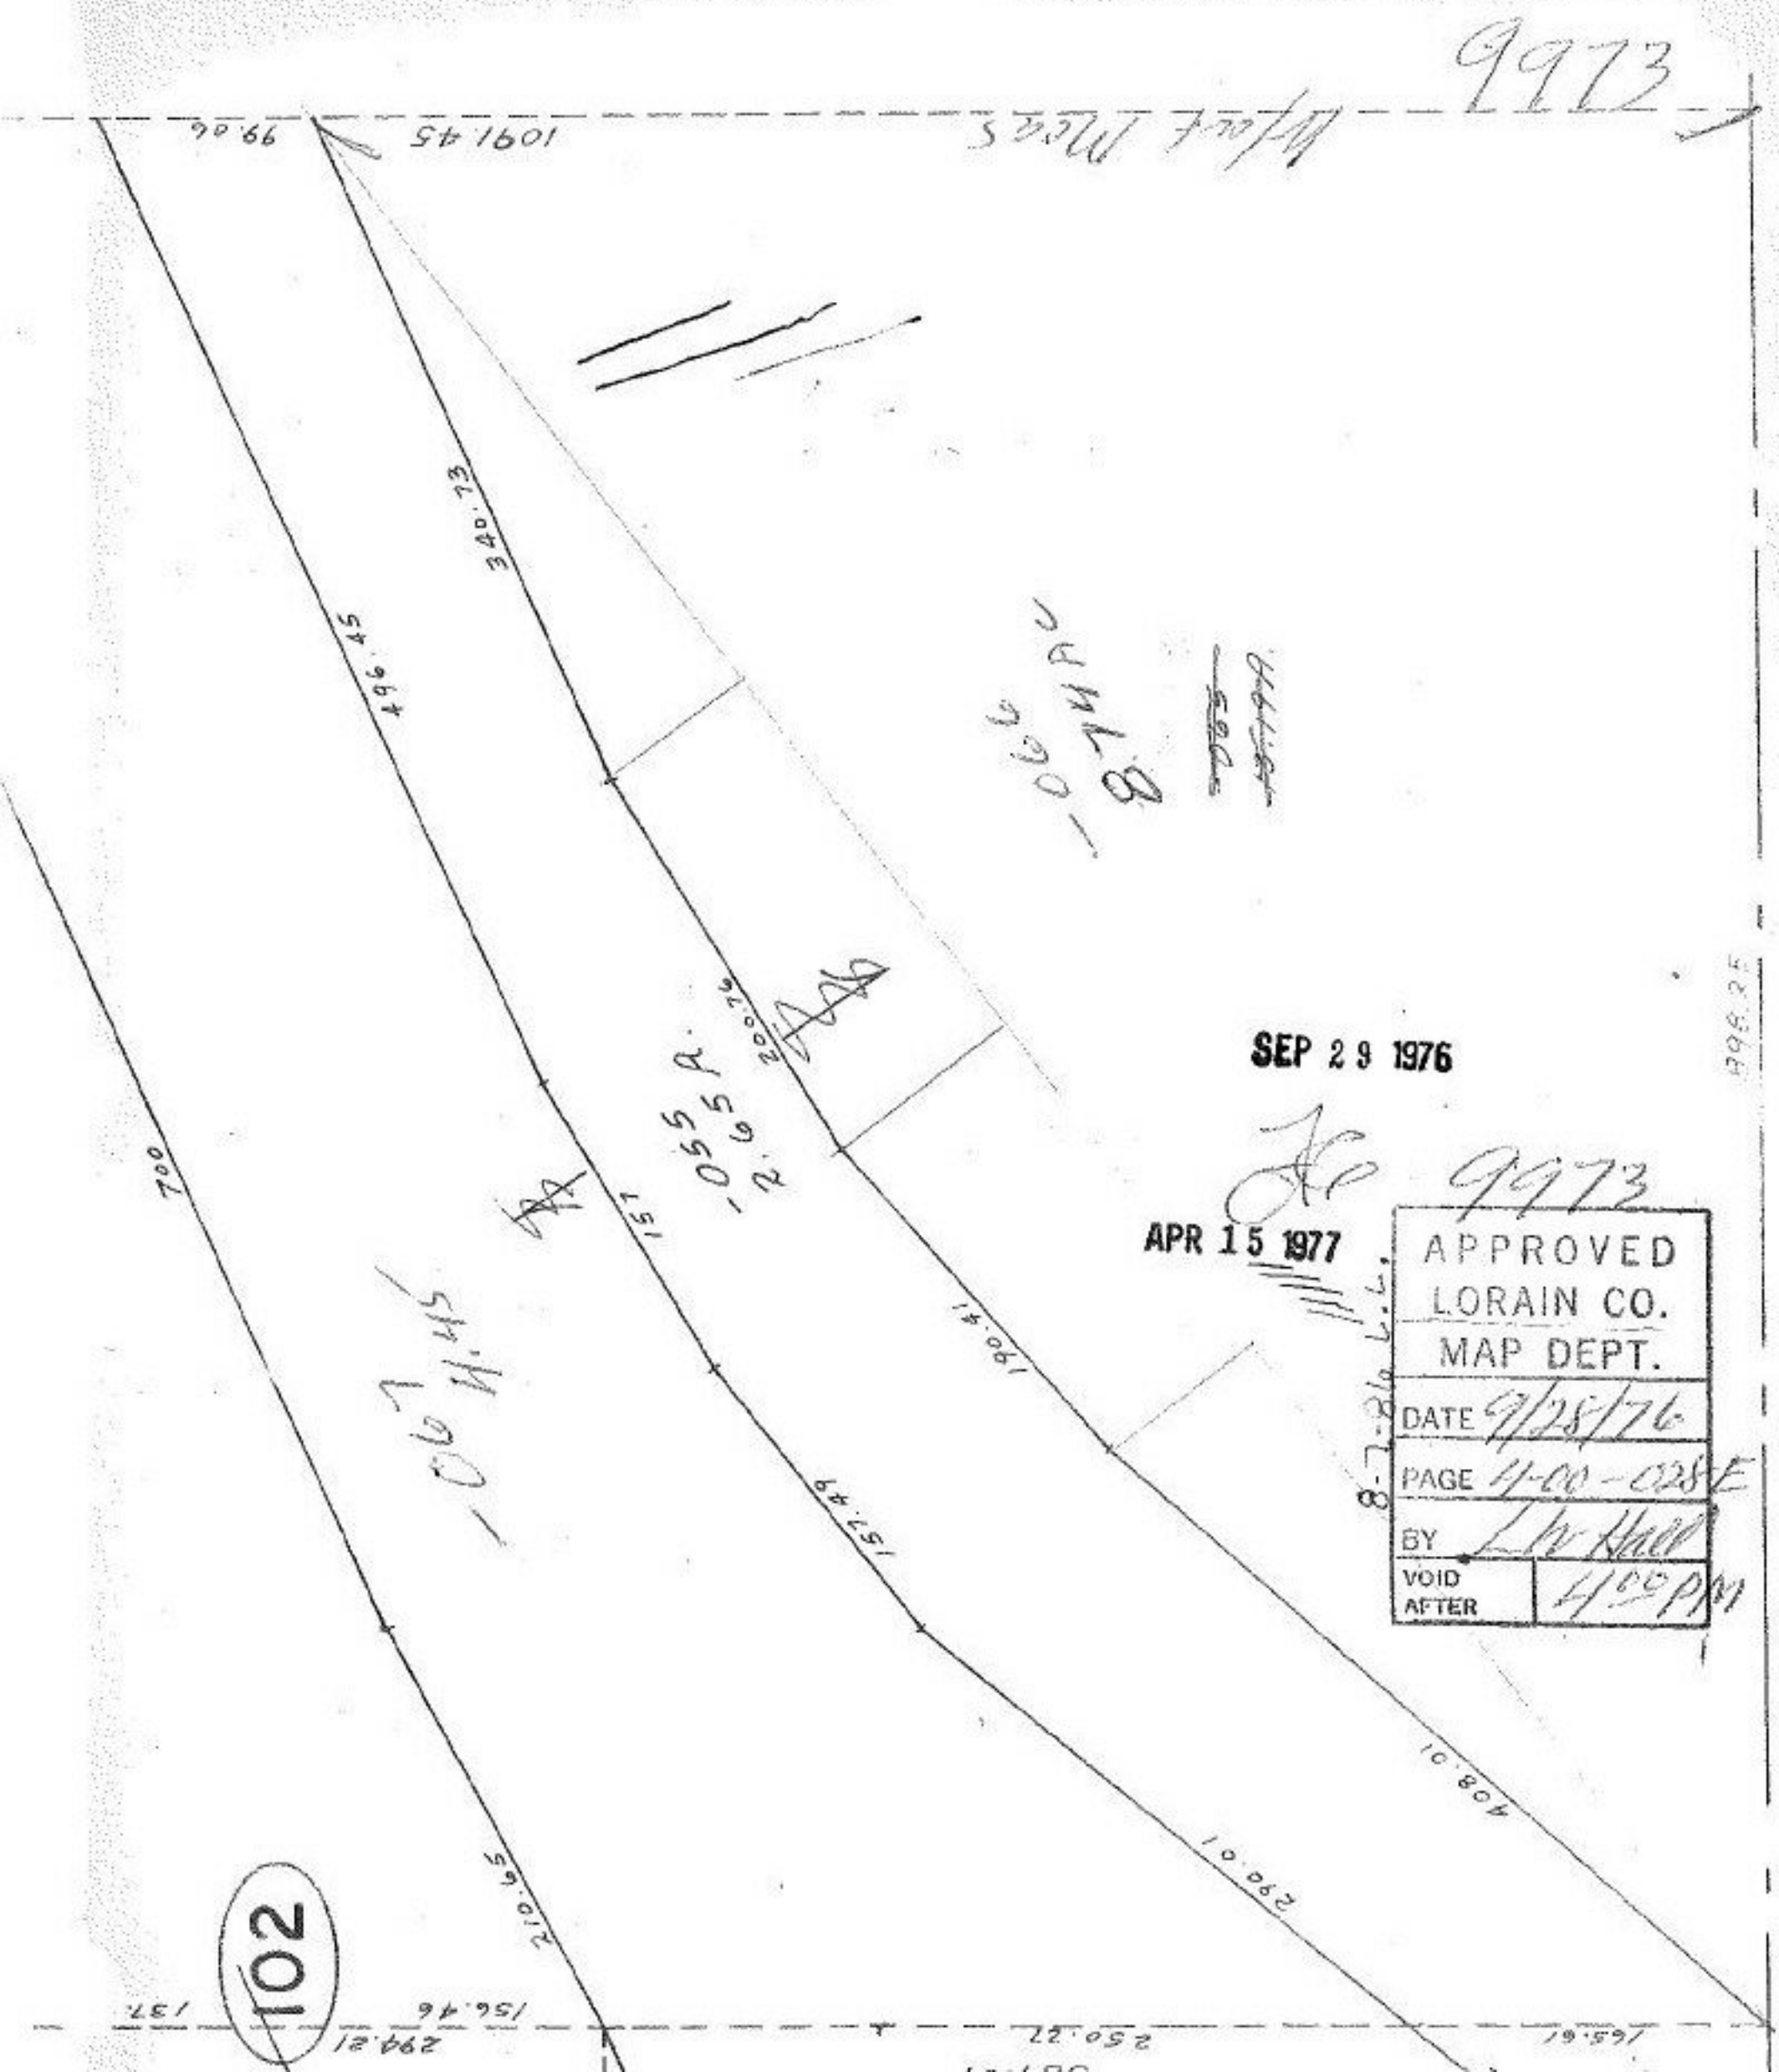
9973
Wfort Meas
1091.45
99.06
340.73
496.45
200.76
157
190.41
157.49
408.01
290.01
210.65
700
-066
8.74 AC
-055 A.
2.65 A.
-067
4.45
SEP 29 1976
APR 15 1977
9973
APPROVED
LORAIN CO.
MAP DEPT.
DATE 9/28/76
PAGE 4-00-028E
BY L.W. Hall
VOID AFTER 4:00 PM
102
137
156.46
294.21
250.27
165.61