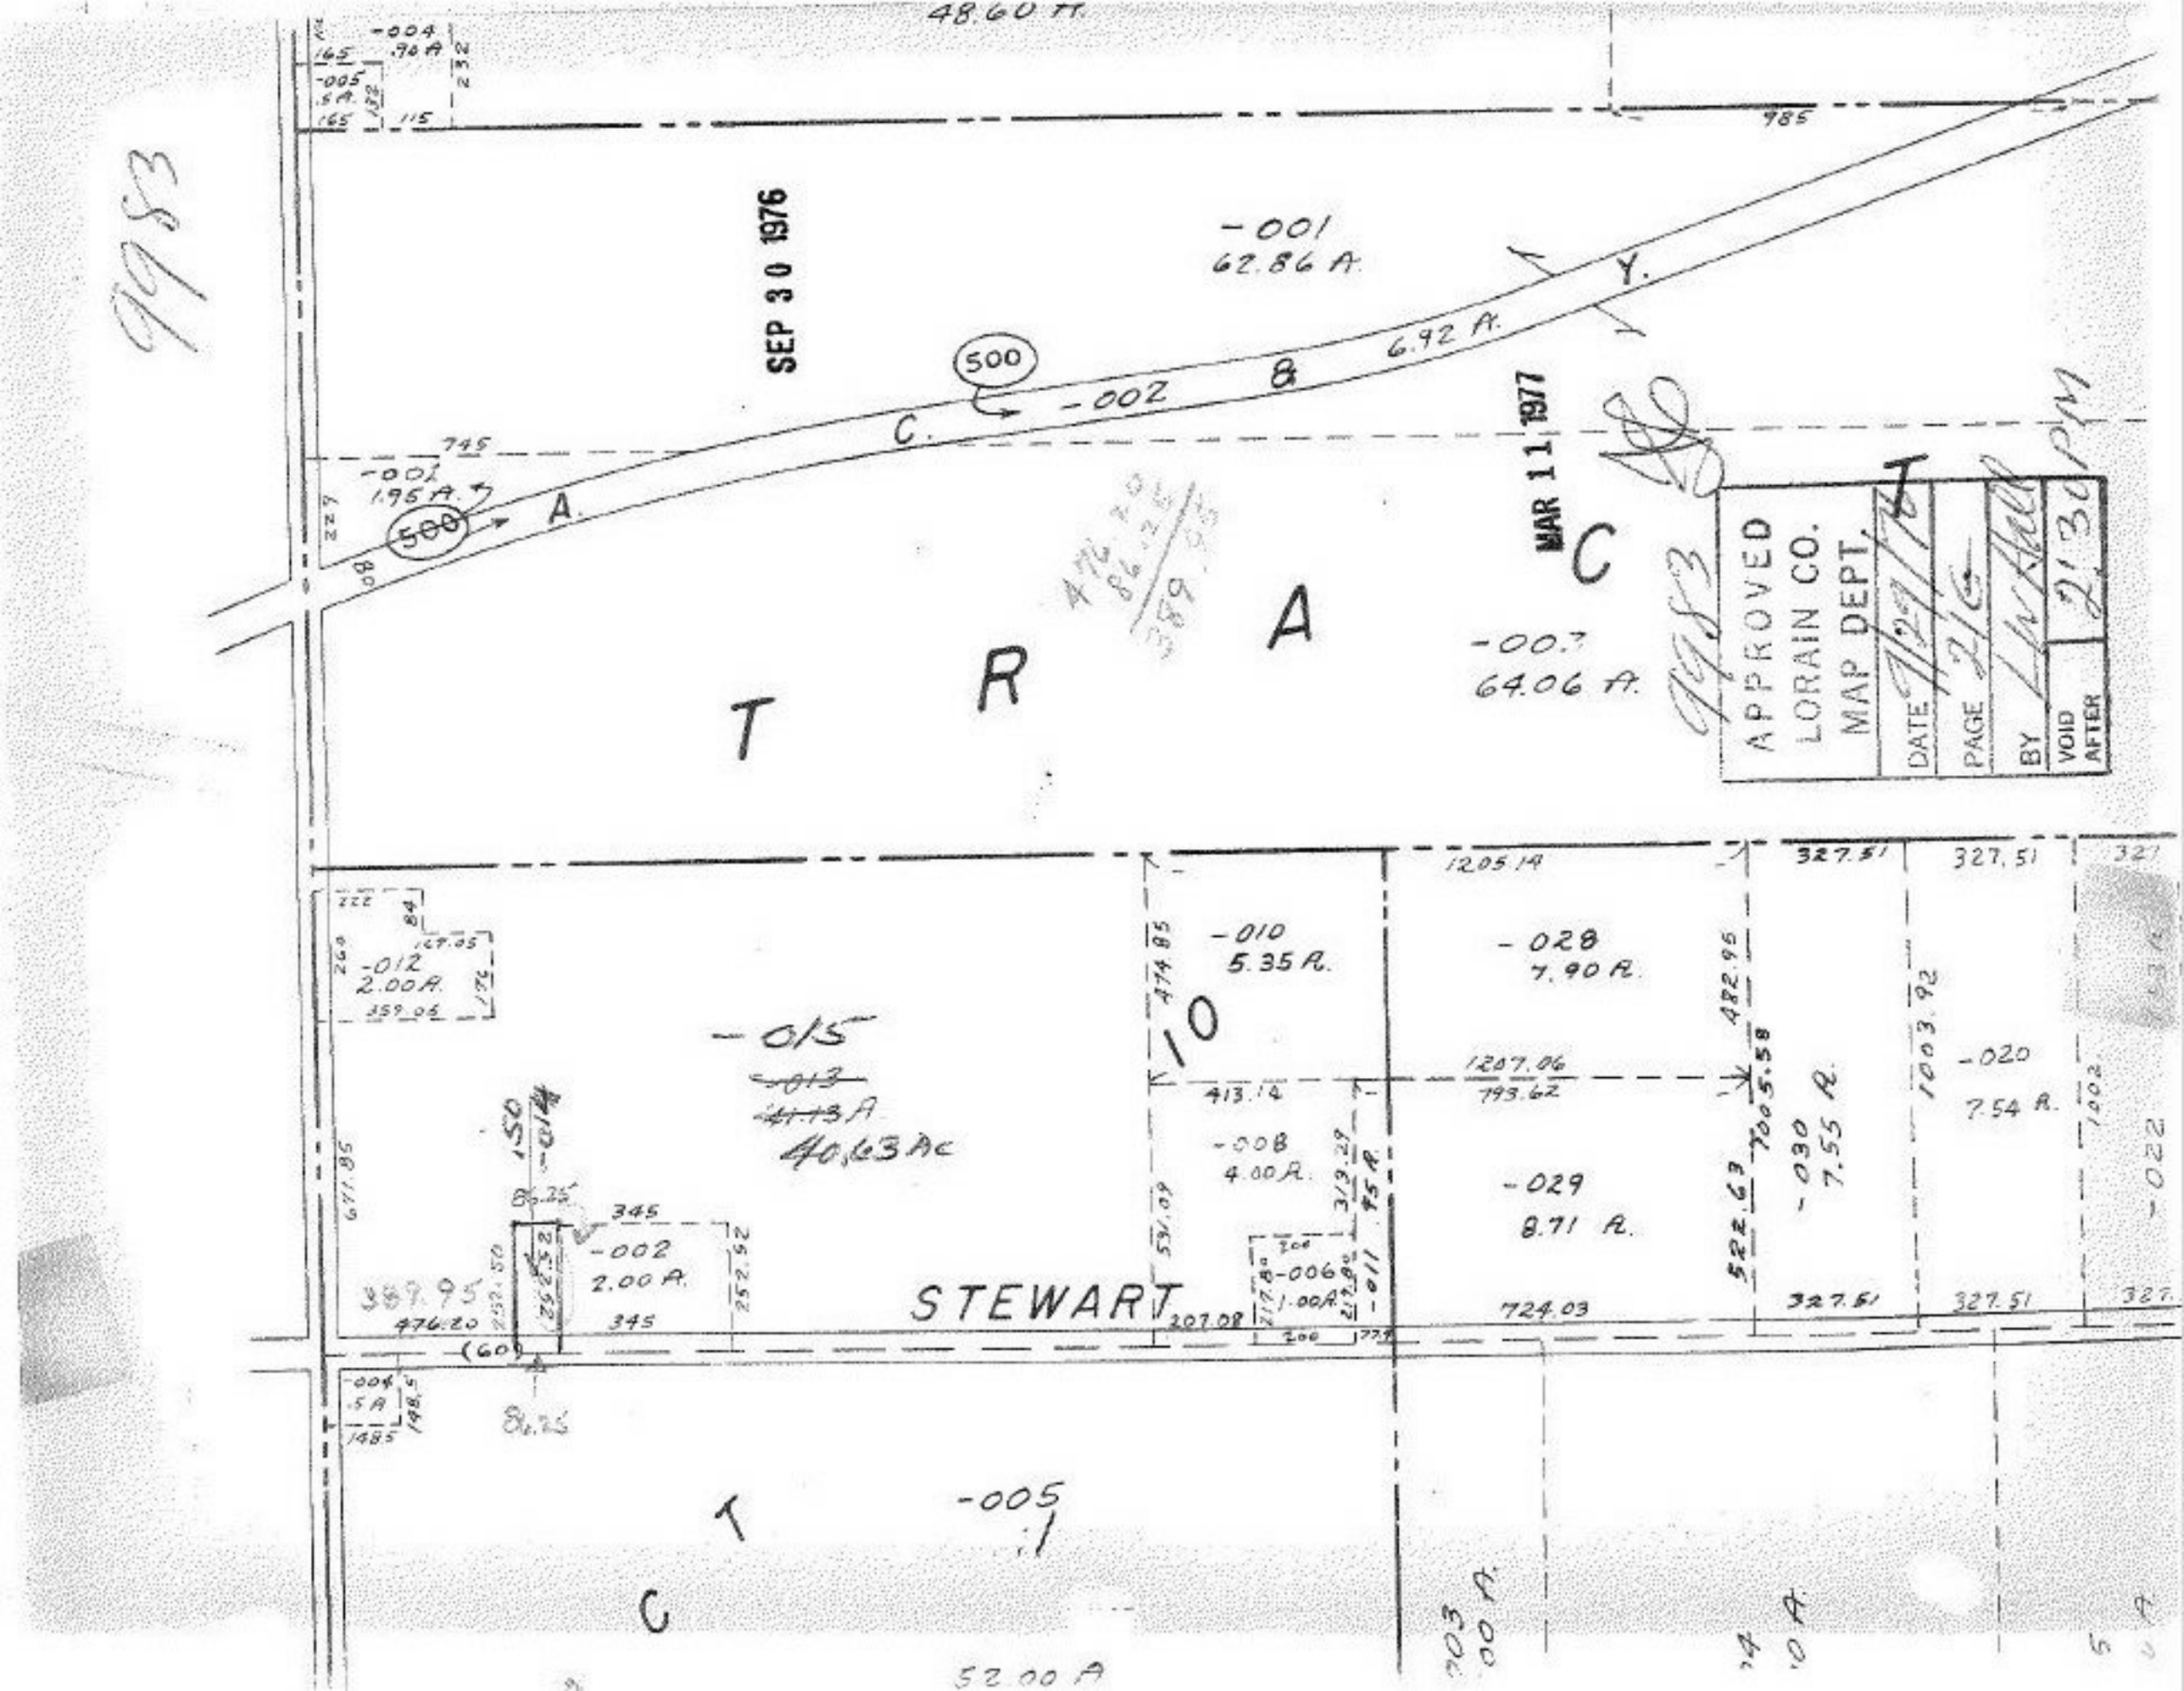

9983
48.60 A.
SEP 30 1976
MAR 11 1977
-001
62.86 A.
6.92 A.
500
-002
-001
1.95 A.
-007
64.06 A.
T R A C T
APPROVED
LORAIN CO.
MAP DEPT.
DATE
PAGE
BY
VOID AFTER
-012
2.00 A.
-015
40.63 Ac
-010
5.35 A.
-028
7.90 A.
-008
4.00 A.
-029
8.71 A.
-030
7.55 A.
-020
7.54 A.
-002
2.00 A.
-006
1.00 A.
STEWART
-005
52.00 A