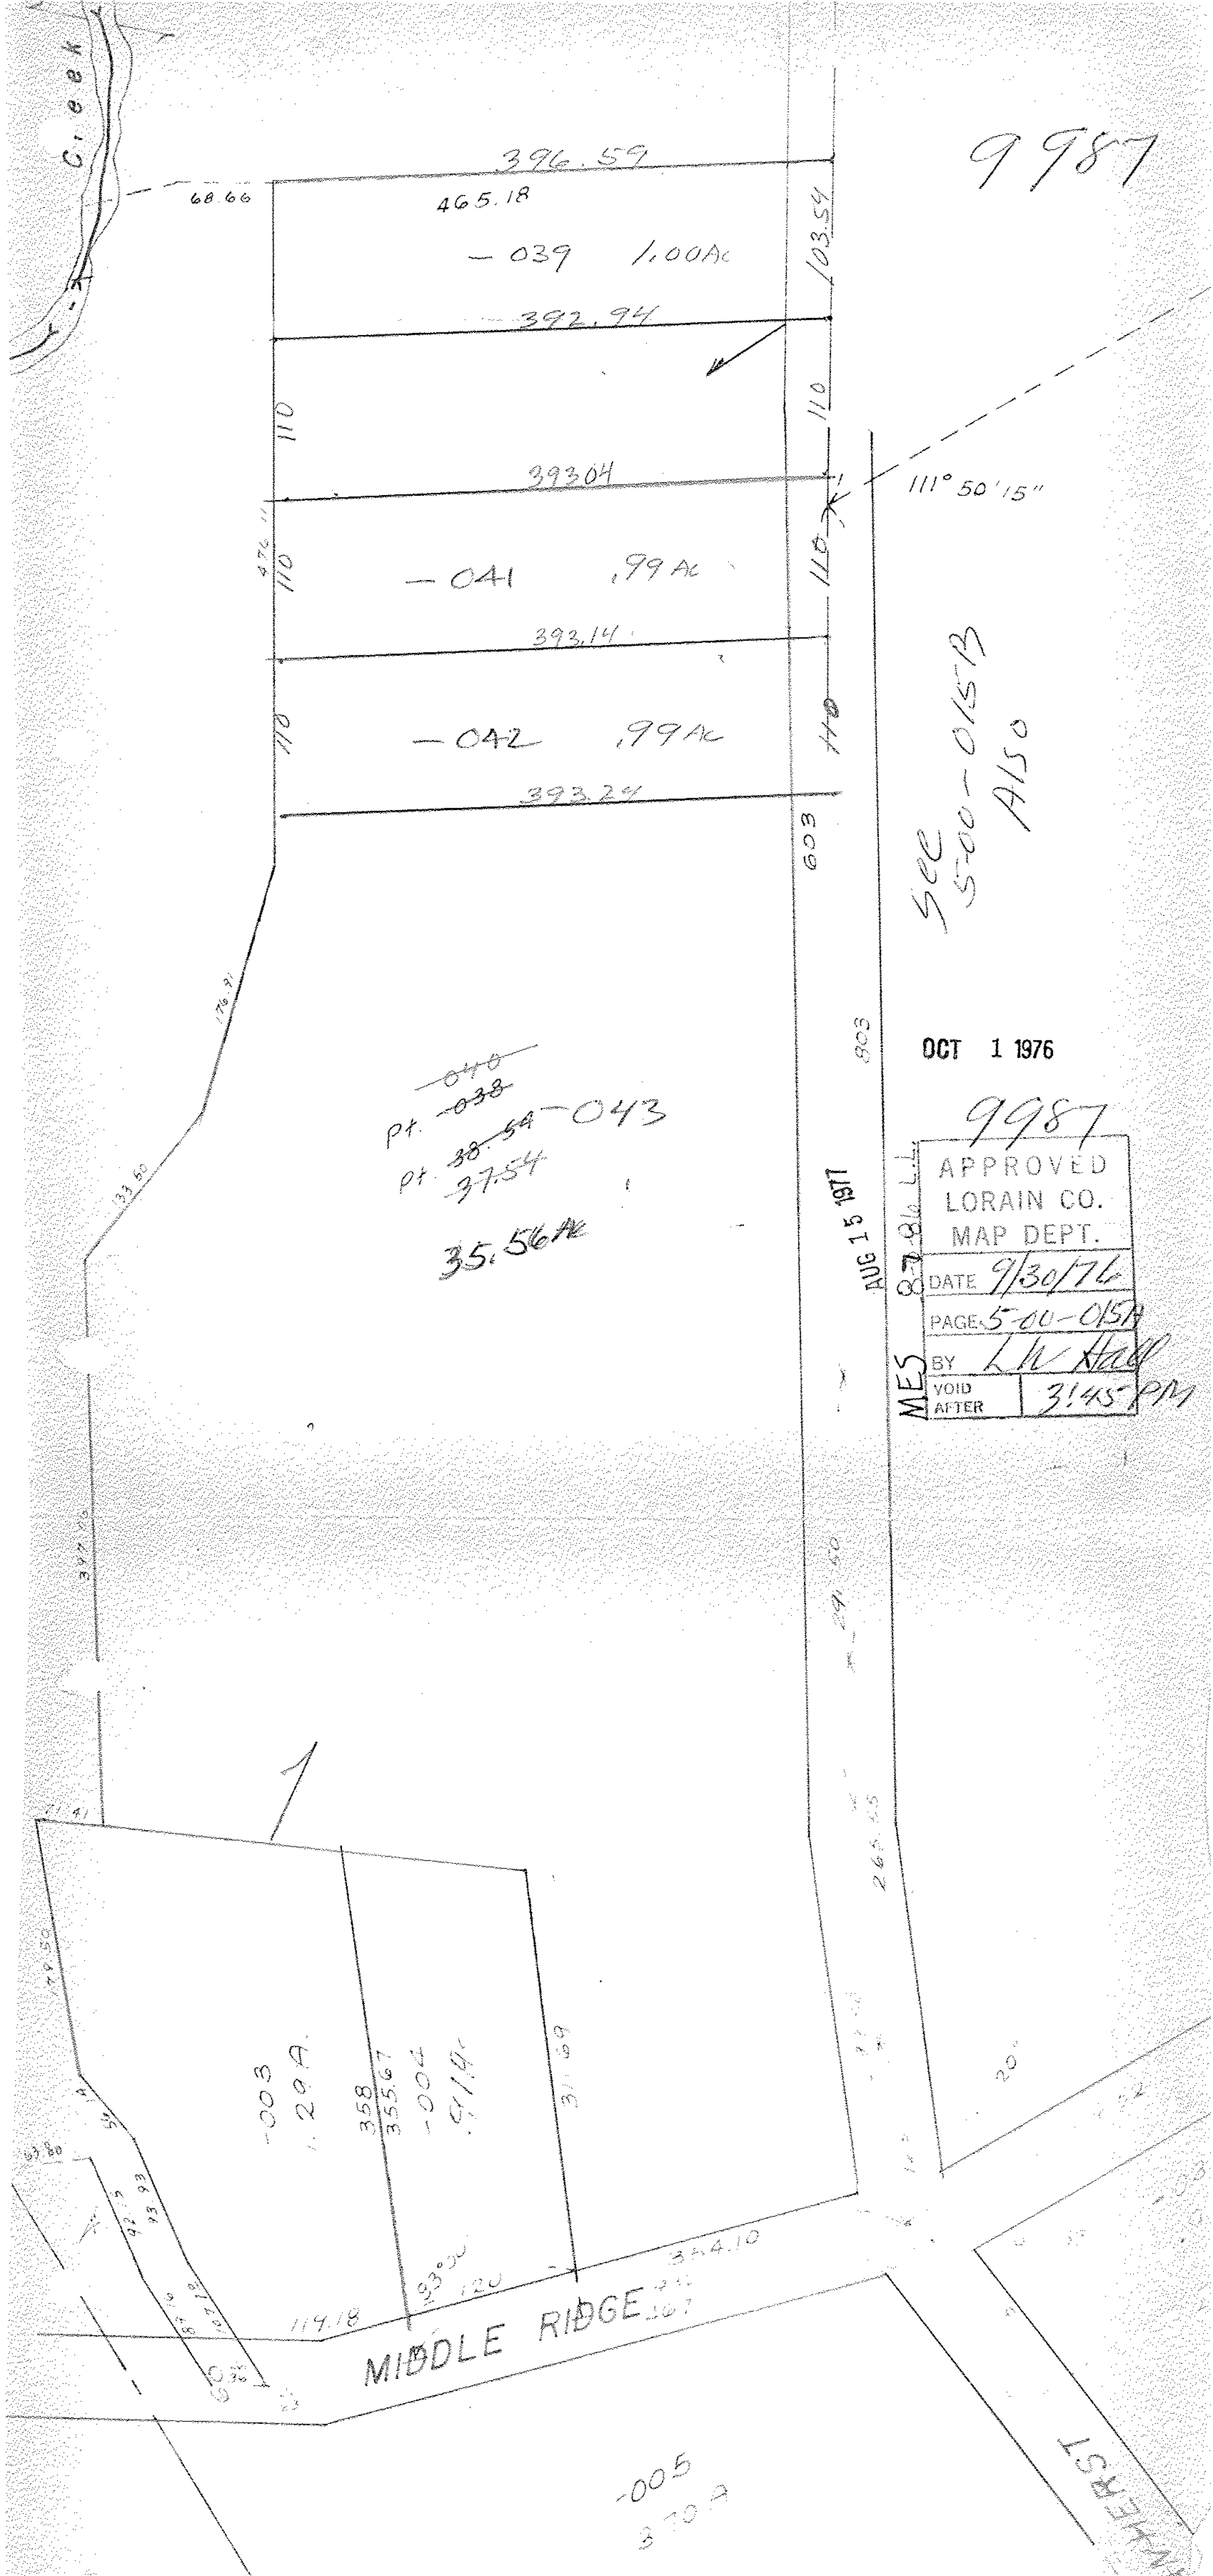

9987
Creek
396.59
68.66
465.18
-039 1.00Ac
103.54
392.94
110
110
393.04
111° 50' 15"
476.11
110
-041 .99Ac
110
393.14
110
-042 .99Ac
110
393.24
603
See 5-00-015B Also
176.91
803
OCT 1 1976
~~040~~
~~038~~
pt. ~~38.54~~ -043
pt. ~~37.54~~
35.56Ac
133.50
AUG 15 1977
9987
APPROVED
LORAIN CO.
MAP DEPT.
DATE 9/30/76
PAGE 5-00-015A
BY LW Hall
VOID AFTER 3:45 PM
MES
397.96
291.50
265.55
-003
1.29A
358
355.67
-004
31.69
20"
119.18
93°30'
120
344.10
MIDDLE RIDGE
-005
3.70A