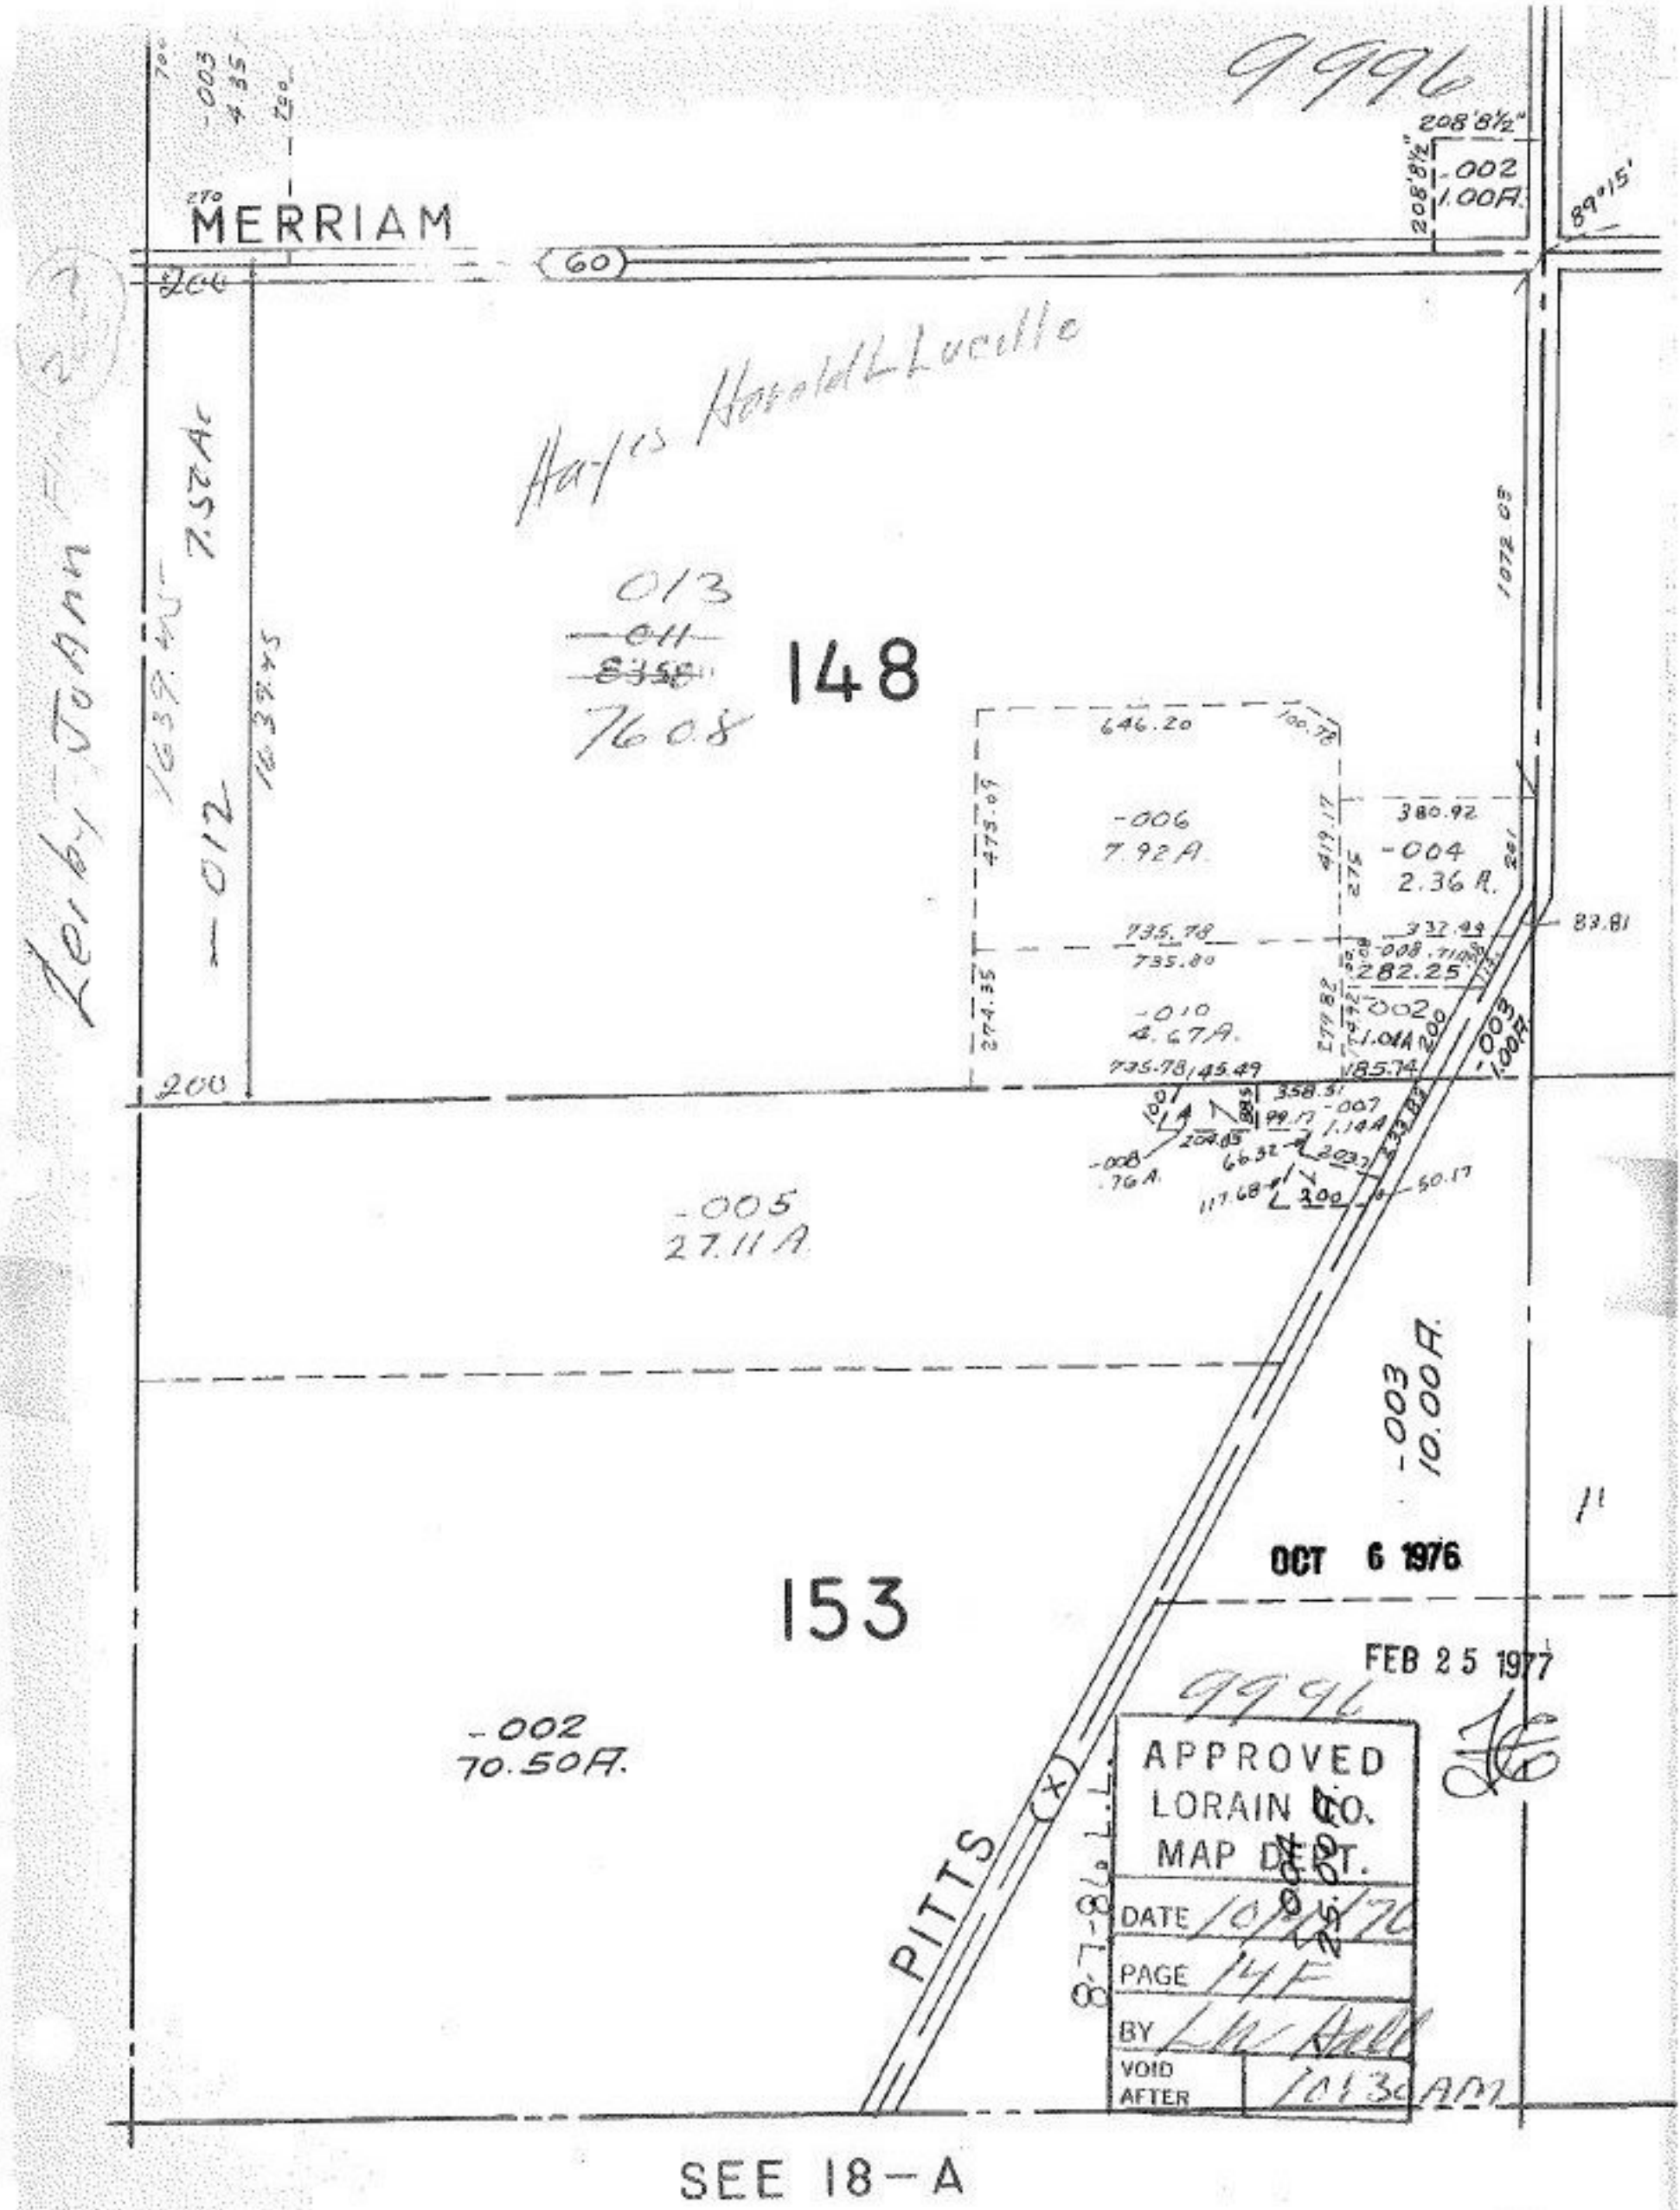
9996
MERRIAM
60
Hayes Harold L Lucille
013
~~011~~
~~8358~~
7608
148
-006
7.92 A.
-004
2.36 A.
-010
4.67 A.
-005
27.11 A.
-003
10.00 A.
153
-002
70.50 A.
PITTS (X)
OCT 6 1976
FEB 25 1977
APPROVED
LORAIN CO.
MAP DEPT.
DATE 10/20/76
PAGE 14F
BY
VOID AFTER 10:30 AM
SEE 18-A