PARENT PARCEL: 11-00-078-000-027 & -028

CHILD PARCEL: 11-00-078-000-047 & 11-00-063-000-032

STARTING POINT: AC CORR PER SURV BY DOUGLAS S. JEWEL

22-04439

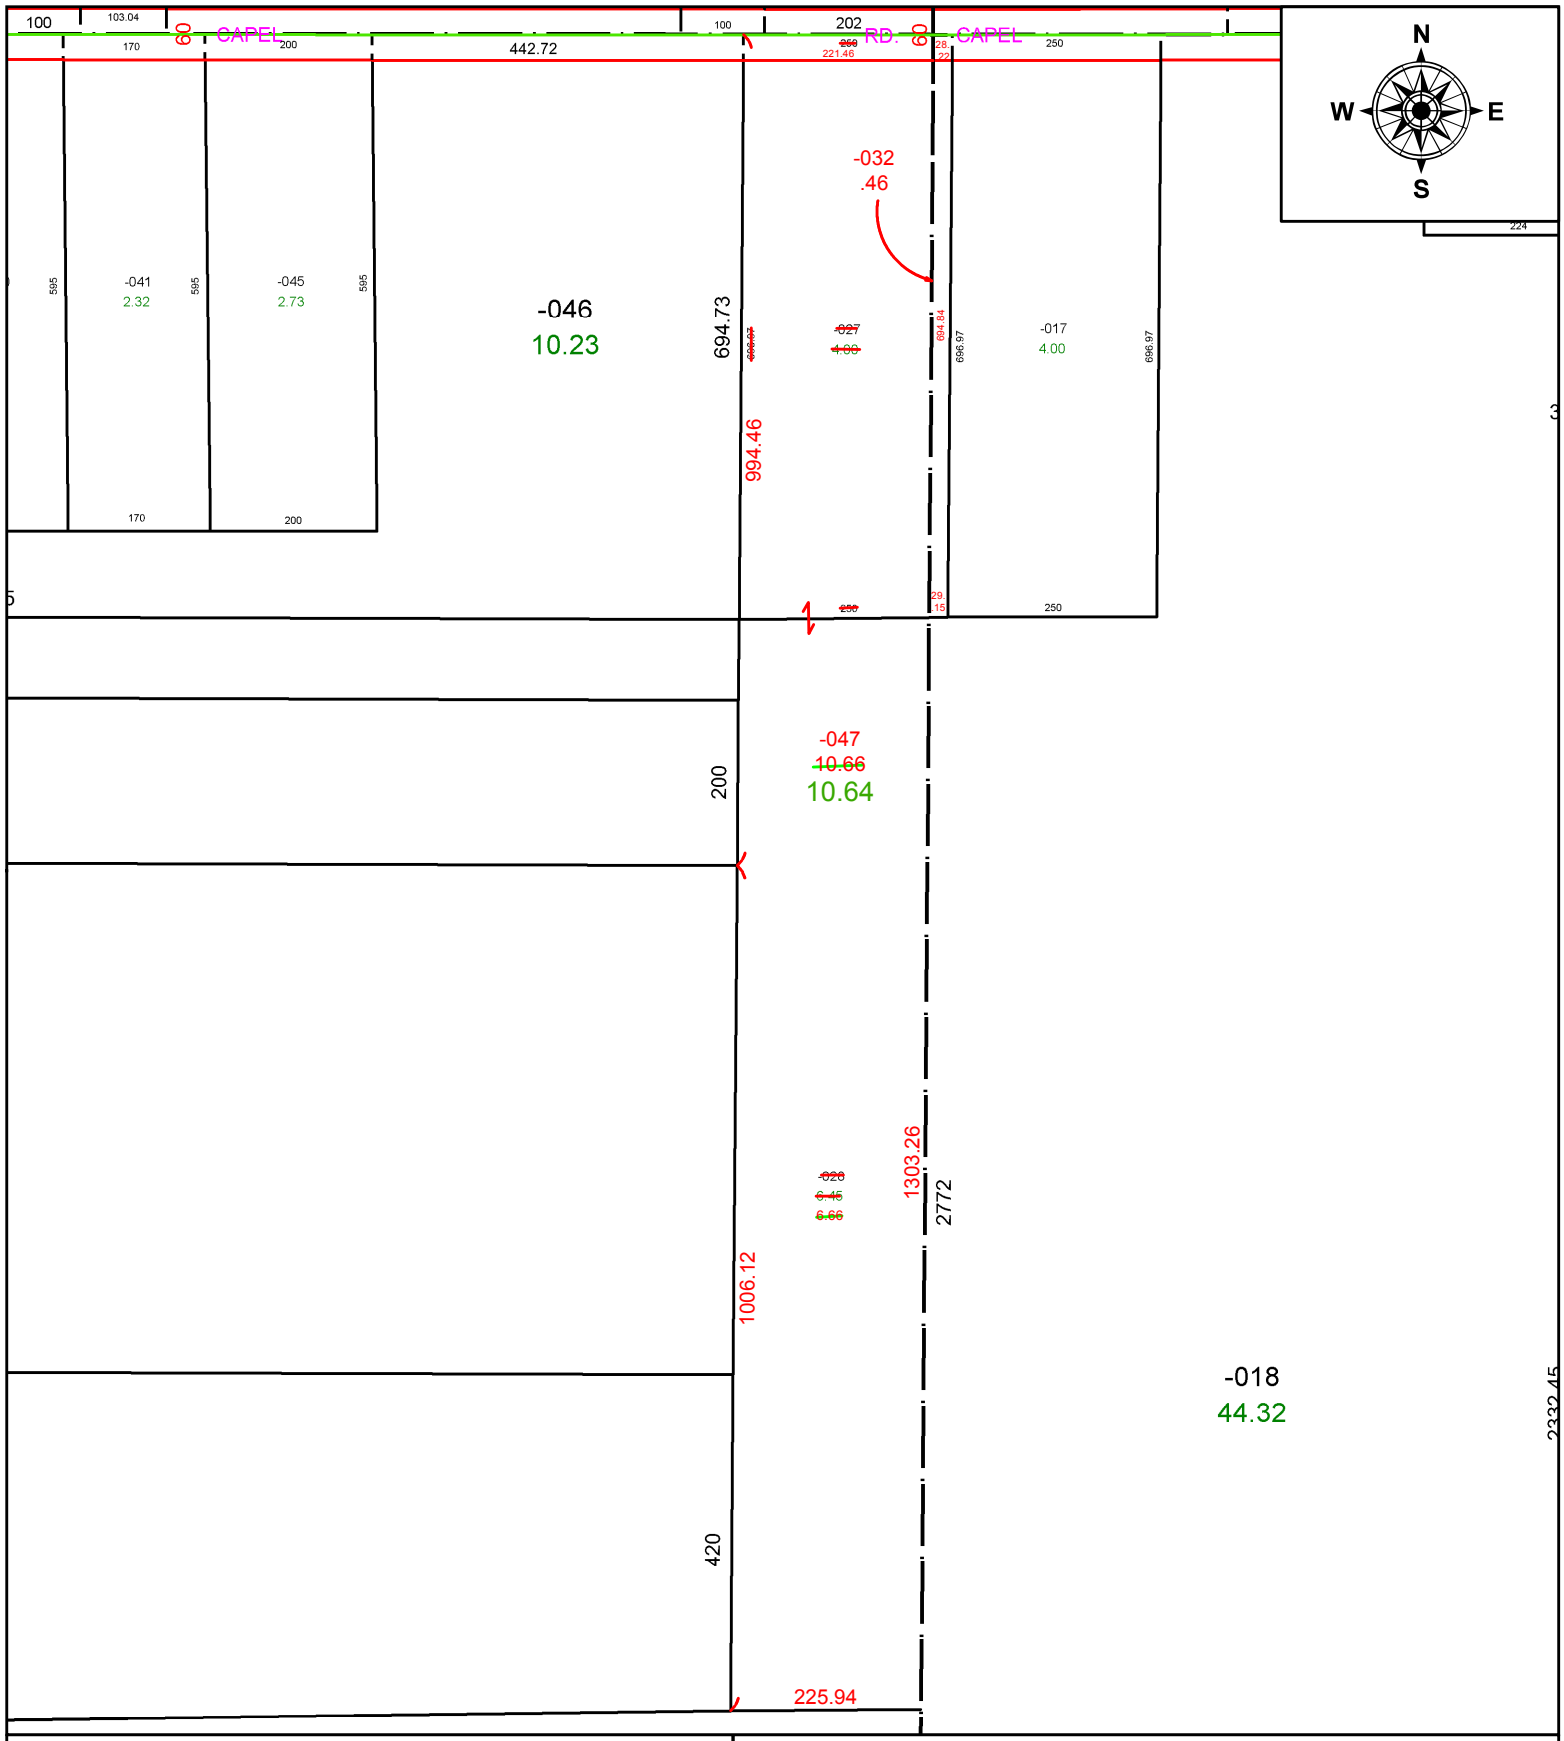

SPLITS/DEEDS PROCESSED

LORAIN COUNTY TAX MAP DEPARTMENT
226 MIDDLE AVE. ELYRIA, OH

SURVEYED BY: DOUGLAS S. JEWEL
CLOSURE: 1: 917530
MAP PAGE(S): 11-00-078
APPOVED BY: AC **DATE:** 2/3/2022
SCALE: 1" = 230 **PRIOR INSTRUMENT:** 2009- 0317882