**PARENT PARCEL:** 05-00-052-000-024, -054, & 05-00-069-000-003(S.T.)

**CHILD PARCEL:** 05-00-052-000-064 AC CORR PER SURVEYOR THEODORE SPILLMAN

**STARTING POINT:** MONUMENT BOX @ INTERSECTION OF C/L OBERLIN RD & SOUTH LINE OF O.L. 52

# 23-04753

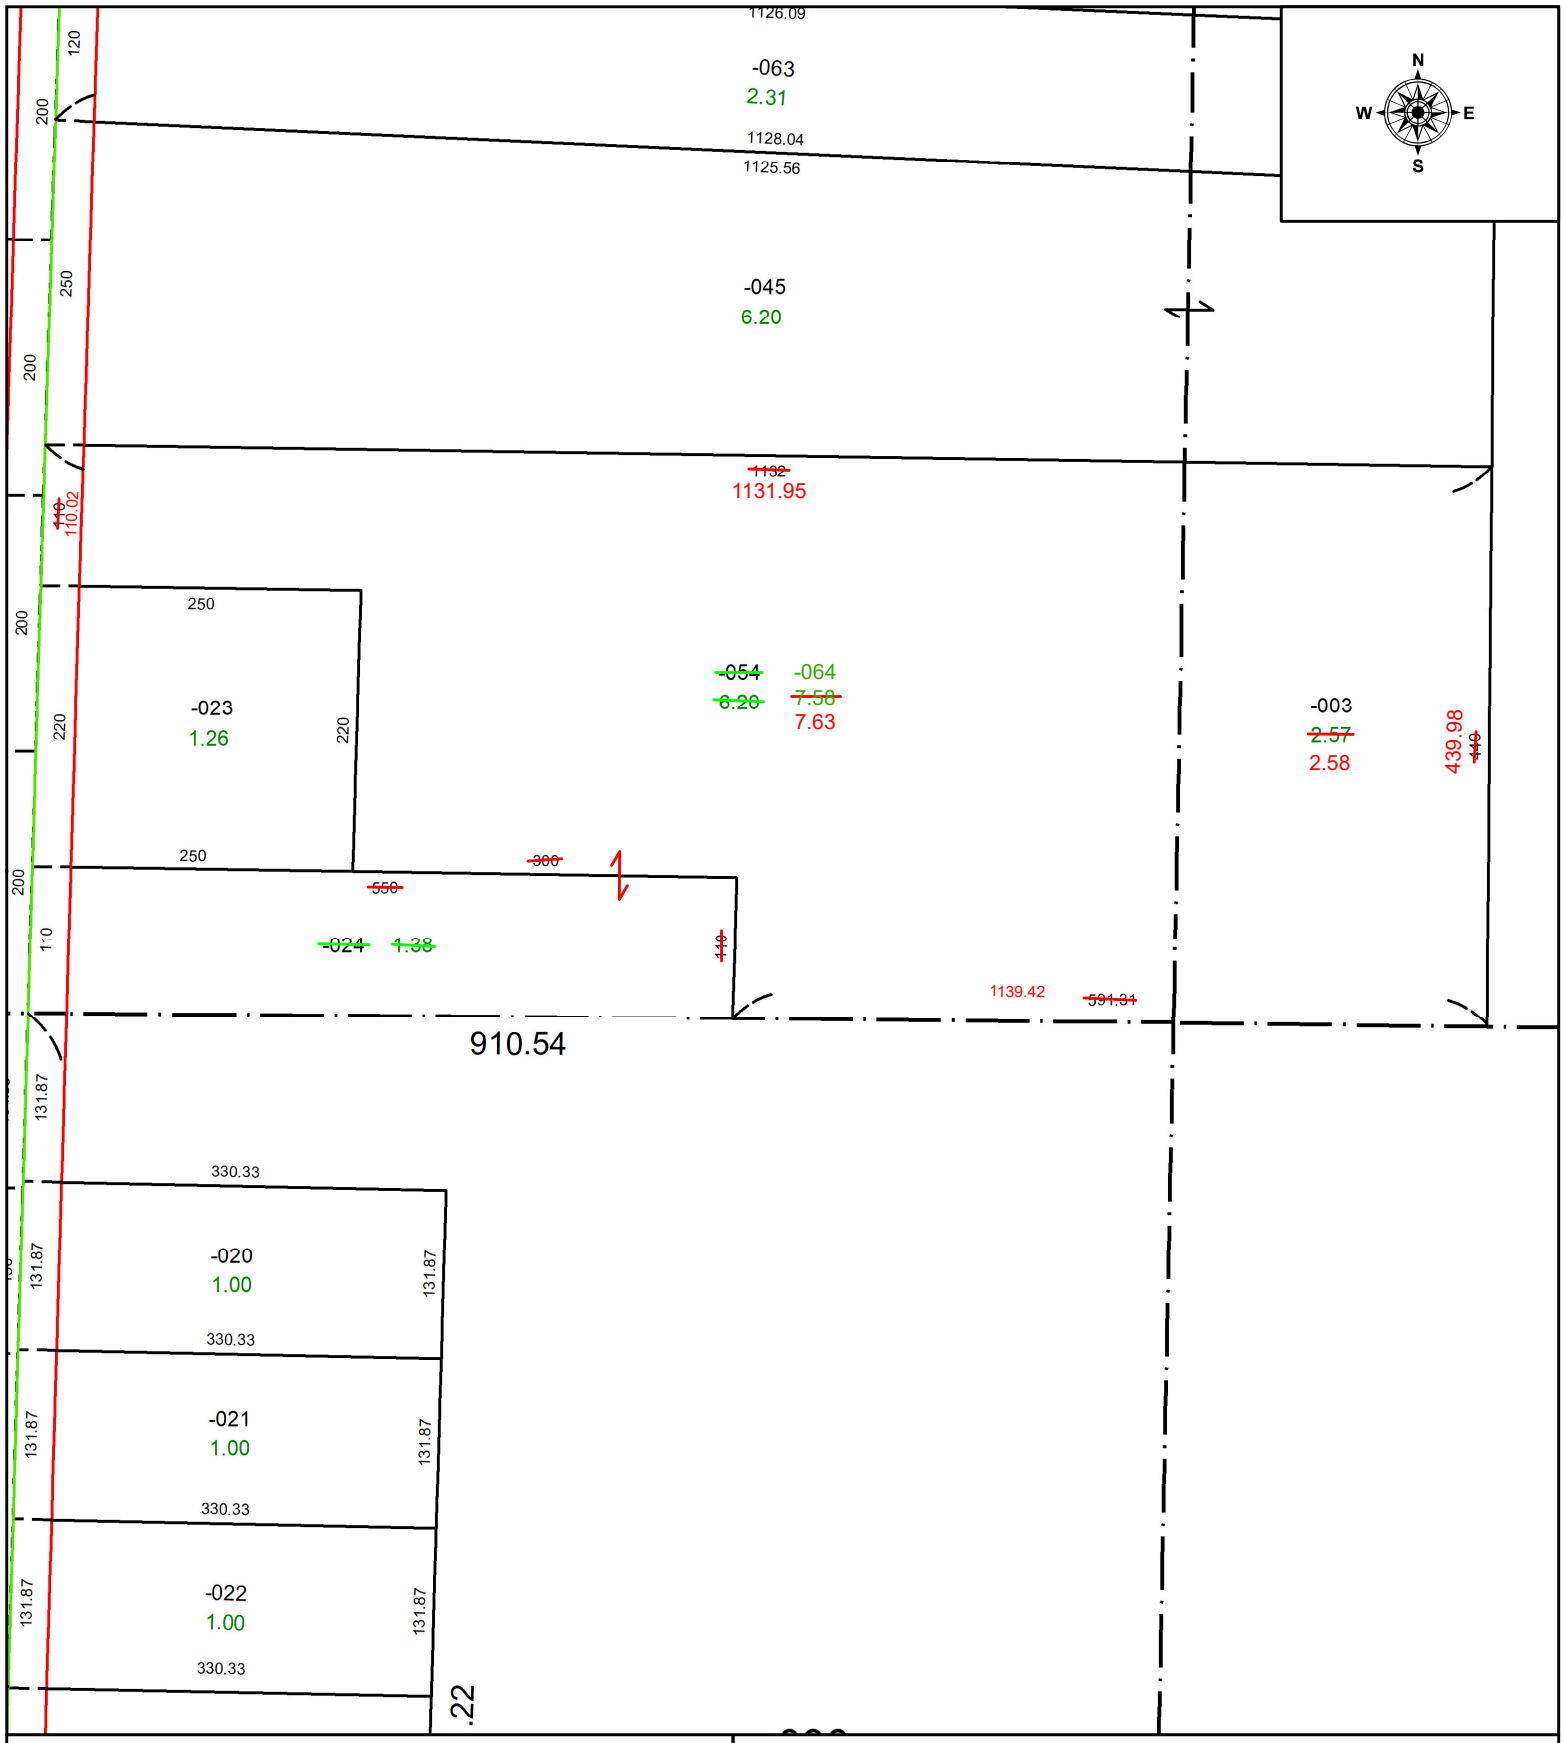


**SPLITS/DEEDS PROCESSED**

LORAIN COUNTY TAX MAP DEPARTMENT
226 MIDDLE AVE. ELYRIA, OH

**SURVEYED BY:** THEODORE SPILLMAN SURVEY # 51018
**CLOSURE:** 1: 324662
**MAP PAGE(S):** 05-00-052 & 05-00-069
**APPOVED BY:** WRZ **DATE:** 9/29/2023
**SCALE:** 1" = 150 **PRIOR INSTRUMENT:** #2008-0263428