PARENT PARCEL: 03-00-096-108-065
CHILD PARCEL: 03-00-096-108-066 & -067
STARTING POINT: N/A

21-04756-U

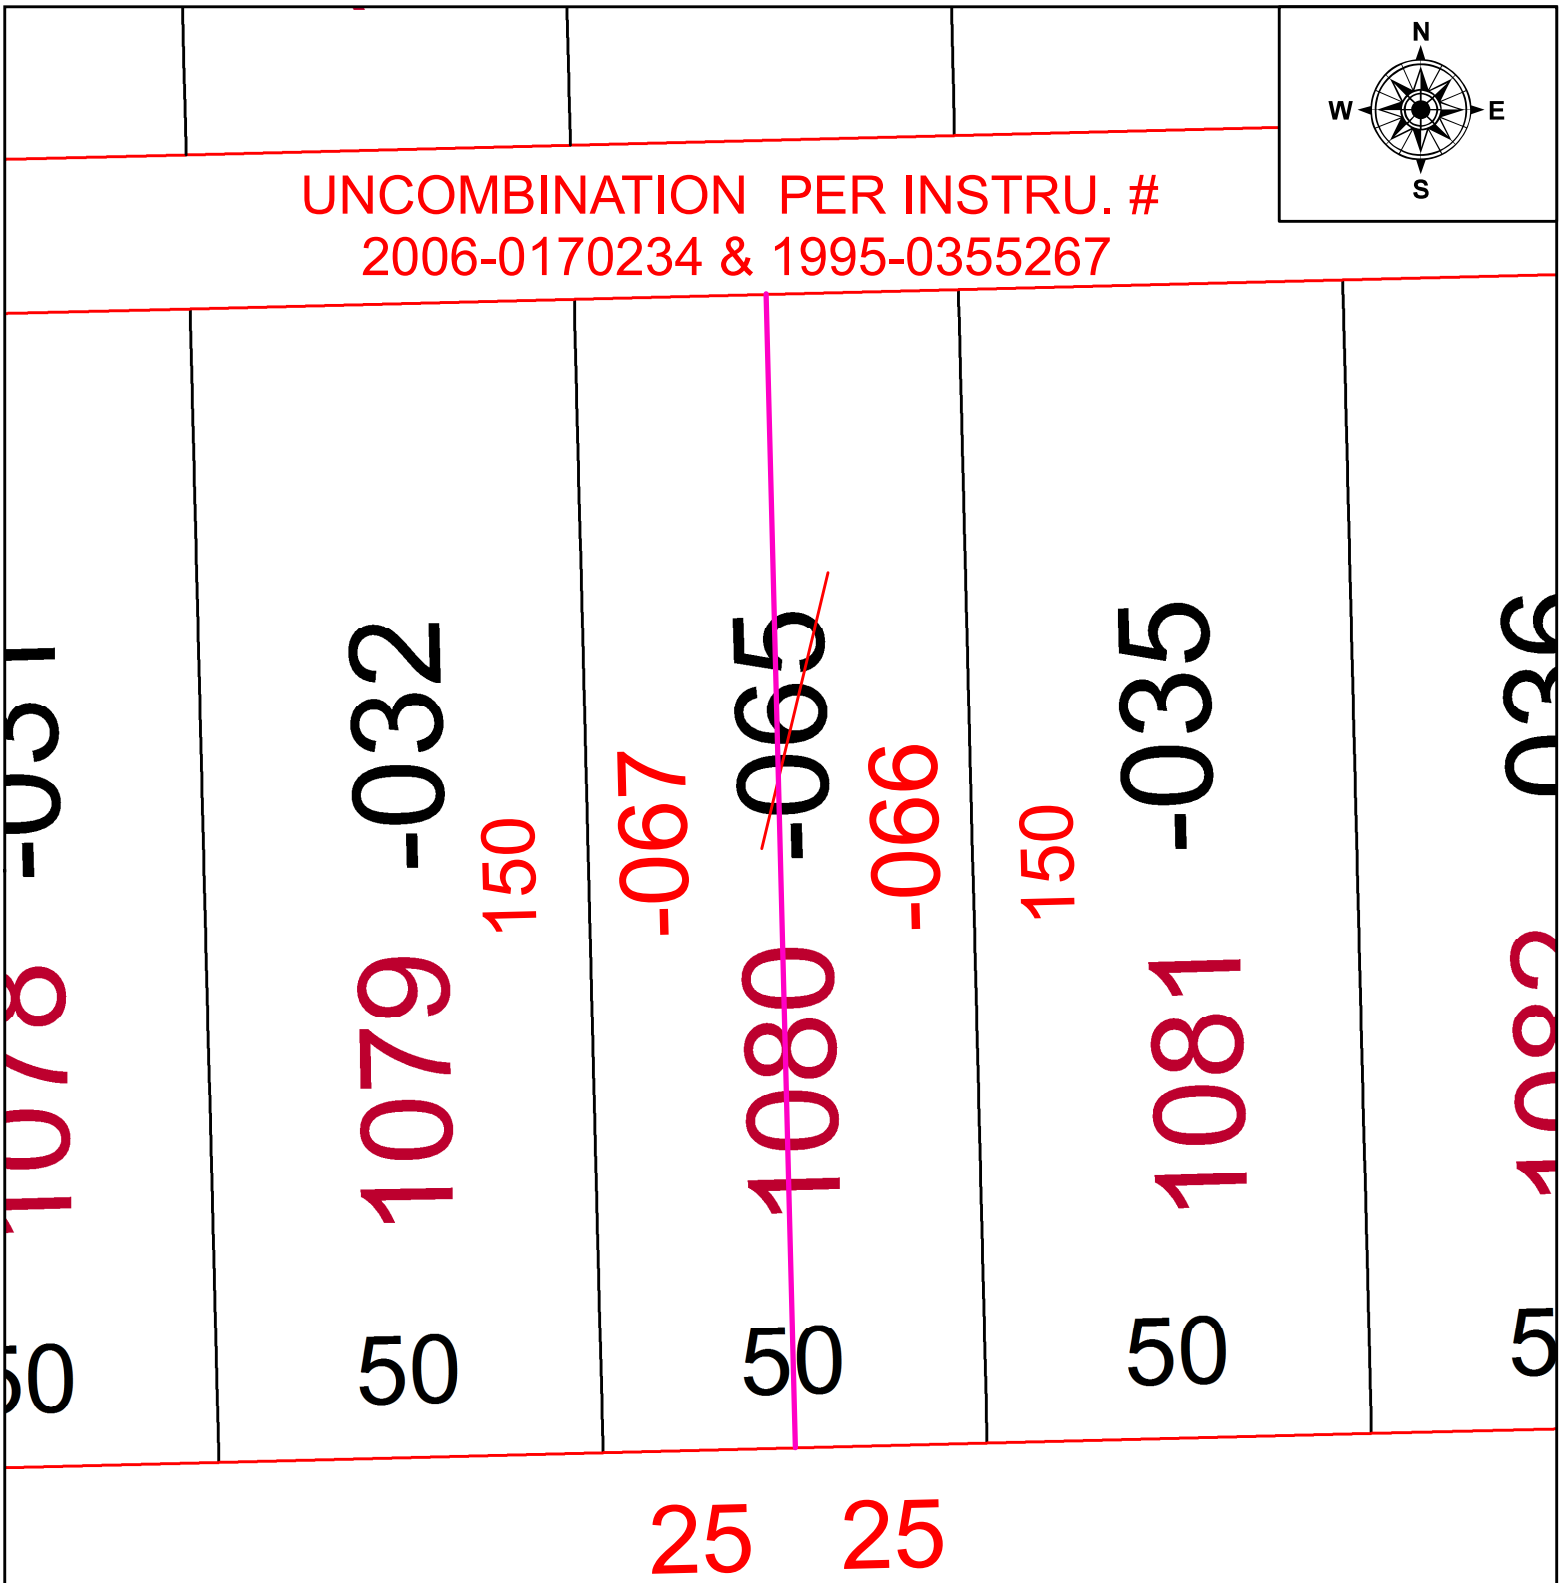

SPLITS/DEEDS PROCESSED
LORAIN COUNTY TAX MAP DEPARTMENT
226 MIDDLE AVE. ELYRIA, OH

SURVEYED BY: N/A
CLOSURE: N/A
MAP PAGE(S): 03-00-096
APPOVED BY: DMA **DATE:** 12/29/2021
SCALE: 1" = 25' **PRIOR INSTRUMENT:** 2006-0170234