PARENT PARCEL: 15-00-017-000-013 & -014

CHILD PARCEL: 15-00-017-000-039, -040, & -041

STARTING POINT: C/L OF WHITEHEAD RD AND NW CORNER OF O/L 17

23-04789

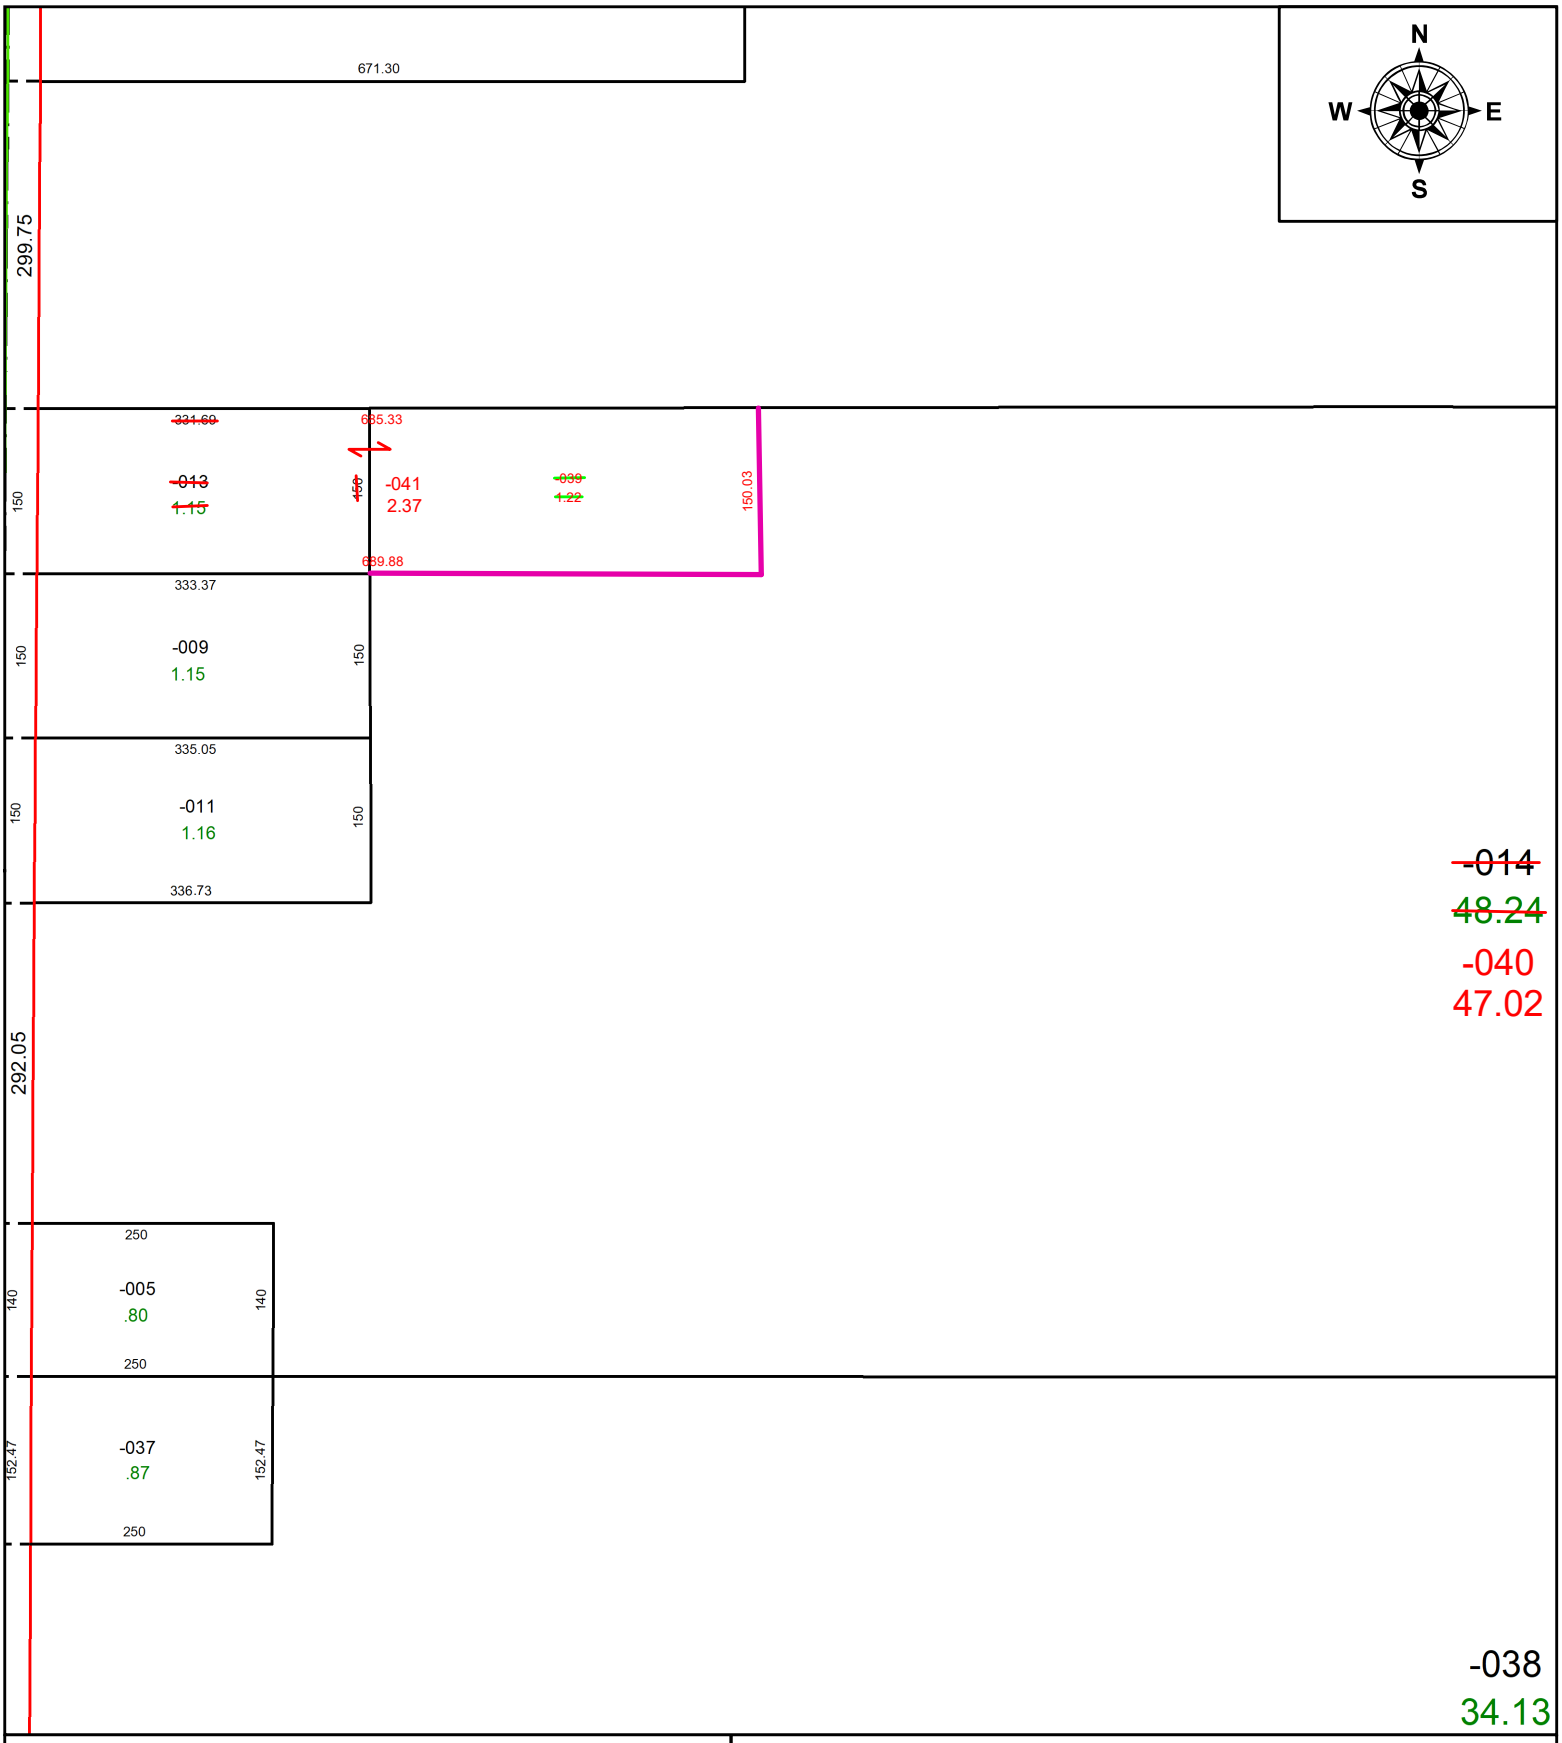

SPLITS/DEEDS PROCESSED

LORAIN COUNTY TAX MAP DEPARTMENT
226 MIDDLE AVE. ELYRIA, OH

SURVEYED BY: THOMAS A. SIMON **SURV # 51070**

CLOSURE: 1: 110971

MAP PAGE(S): 15-00-017-A

APPOVED BY: AC **DATE:** December 01, 2023

SCALE: 1 in = 175 ft **PRIOR INSTRUMENT:** 1999- 0239973