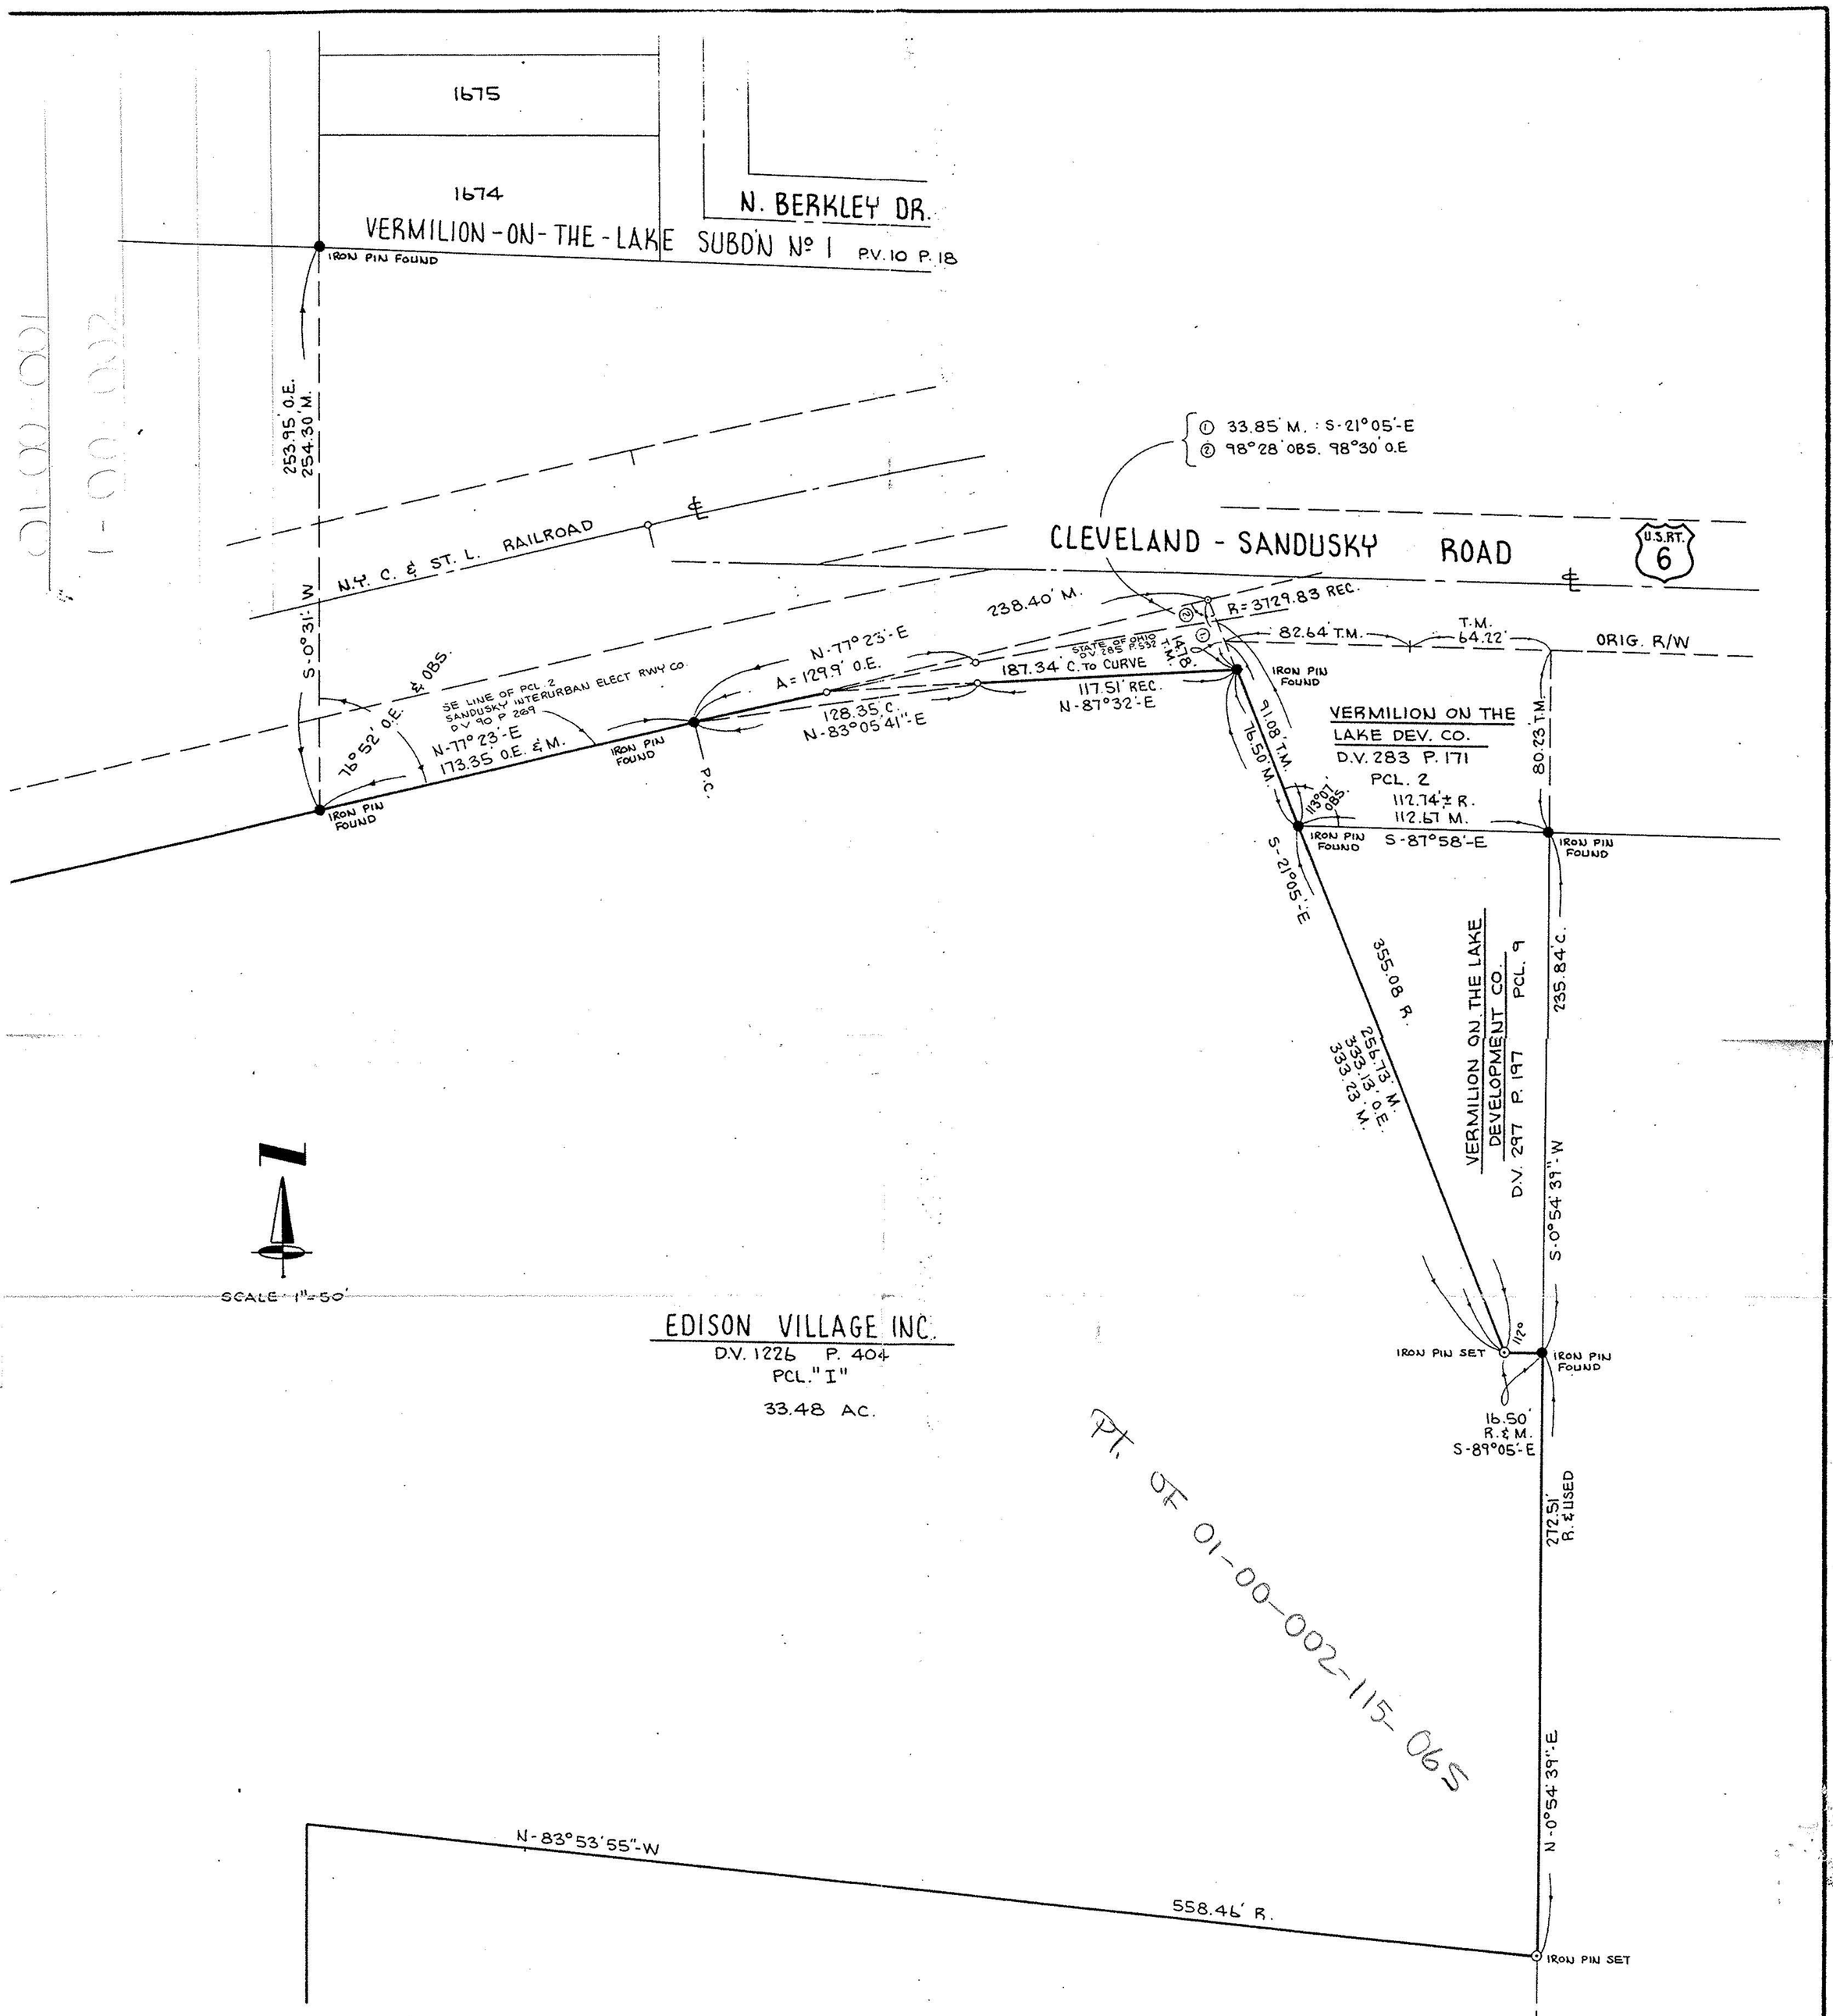

P.P.N. 01-00-002-115-065

BOUNDARY SURVEY

OF PART OF

ORIGINAL BROWNHELM TWP. LOT Nº 2

CITY OF VERMILION COUNTY OF LORAIN STATE OF OHIO

PREPARED BY

KLEINOEDER-SCHMIDT & ASSOC.

CONSULTING ENGINEERS & SURVEYORS

MAY 1, 1980

DELORES ANN KOPPENHAFER & RICHARD VICTOR FOLEA D.V. 947 P. 240

PCL. "A" 16.57 AC.

PCL. "B" 11.96 AC.

NOTATION

M. - MEASURED
"R." - RECORD (DEED)
"T.M." - TAX MAP DATA
"C." - CALCULATED
"O.E." - DATA APPEARING ON OHIO EDISON PROPERTY MAP 47:002 (1 OF 2) REVISED 1-6-78.

80-55

80-55