


THE WOODLANDS OF VERMILION CONDOMINIUM NO. 1

CITY OF VERMILION-COUNTY OF LORAIN-OHIO

PART OF ORIGINAL BROWHELM TOWNSHIP LOT NO. 2

| BLDG. NO. | UNIT NO. | UNIT AREA | % OWNERSHIP |
|-----------|----------|------------|-------------|
| 1 | 1 | 1,088 S.F. | .0424 |
| 1 | 2 | 1,088 S.F. | .0424 |
| 1 | 3 | 1,138 S.F. | .0443 |
| 1 | 4 | 1,138 S.F. | .0443 |
| 1 | 5 | 1,088 S.F. | .0424 |
| 1 | 6 | 1,088 S.F. | .0424 |
| 1 | 7 | 1,138 S.F. | .0443 |
| 1 | 8 | 1,138 S.F. | .0443 |
| 2 | 9 | 1,668 S.F. | .0650 |
| 2 | 10 | 1,904 S.F. | .0742 |
| 2 | 11 | 1,668 S.F. | .0650 |
| 3 | 12 | 1,476 S.F. | .0575 |
| 3 | 13 | 1,516 S.F. | .0591 |
| 3 | 14 | 1,484 S.F. | .0578 |
| 4 | 15 | 1,587 S.F. | .0618 |
| 4 | 16 | 2,650 S.F. | .1033 |
| 5 | 17 | 1,392 S.F. | .0542 |
| 5 | 18 | 1,392 S.F. | .0542 |

| SHEET NO. | DESCRIPTION |
|-----------|--------------------------------------|
| 1 | TITLE SHEET - SURVEY MAP & MISC. |
| 2 | WEST, EAST, SOUTH & NORTH ELEVATIONS |
| 3 | FOUNDATION UNITS |
| 3 | FIRST FLOOR PLAN UNITS |
| 3 | SECOND FLOOR PLAN UNITS |

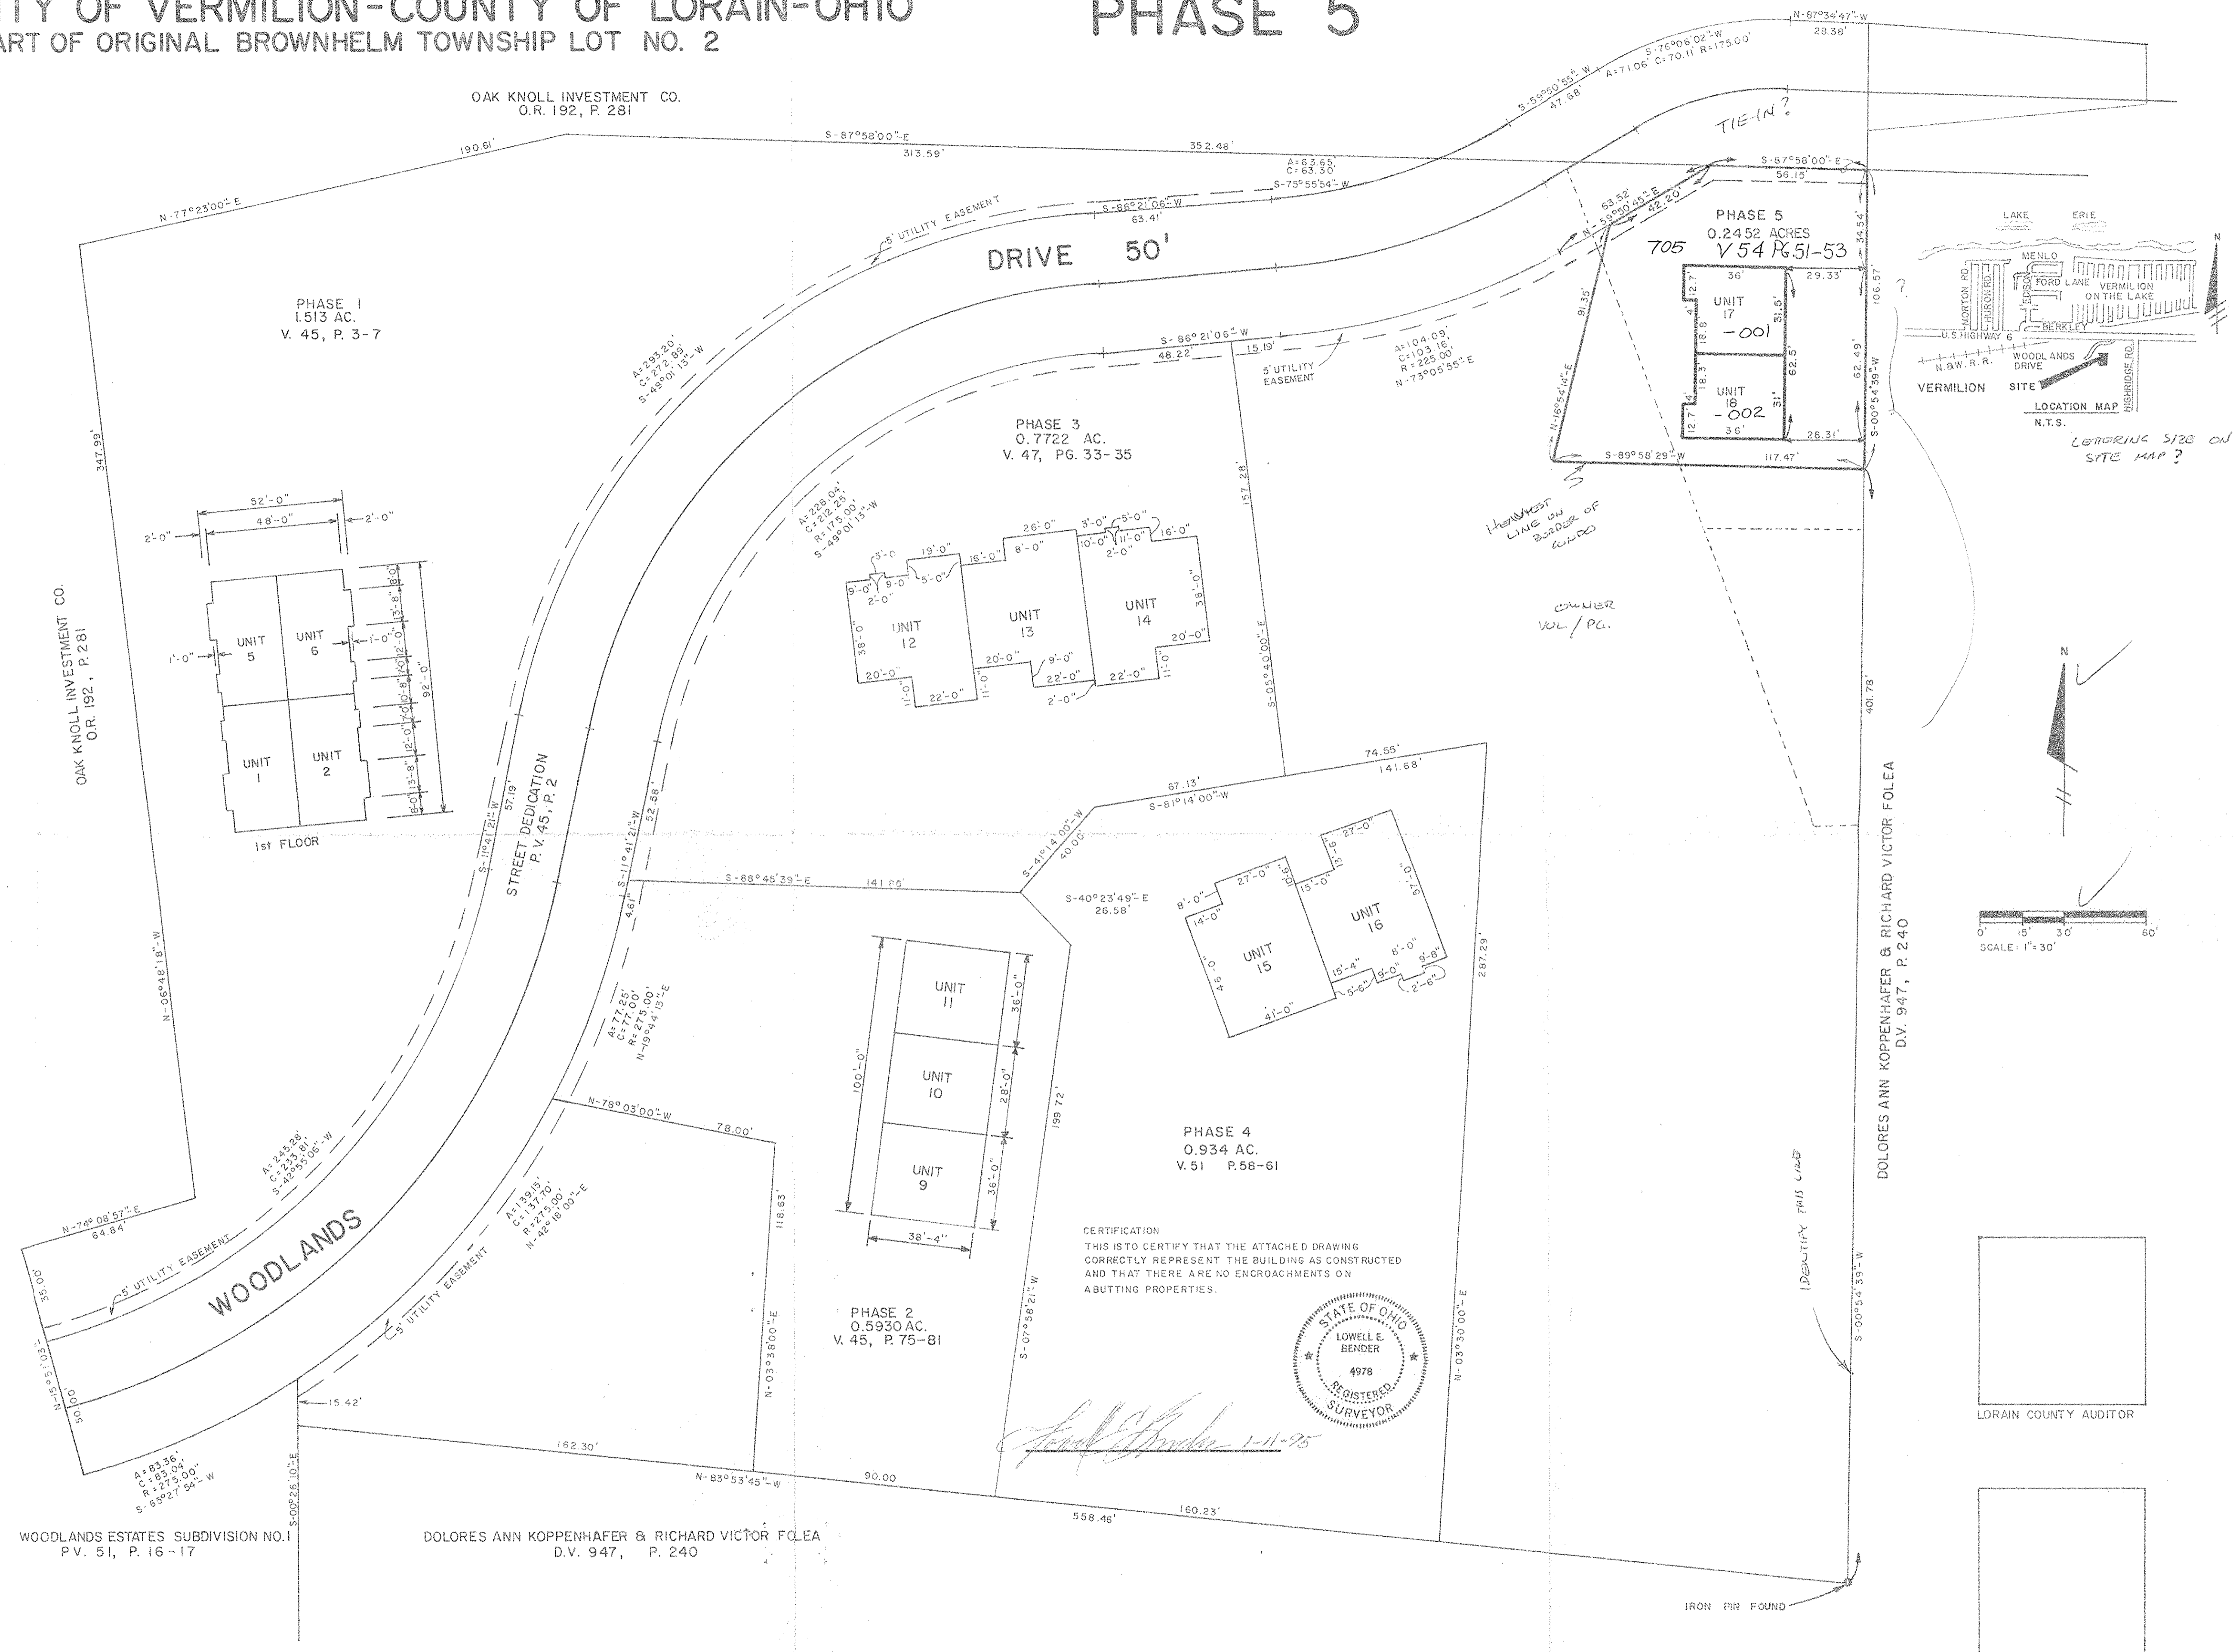

1-00-002-C

P.P.N. 01-00-002-705-001
- 002

LORAIN COUNTY AUDITOR

LORAIN COUNTY RECORDER