
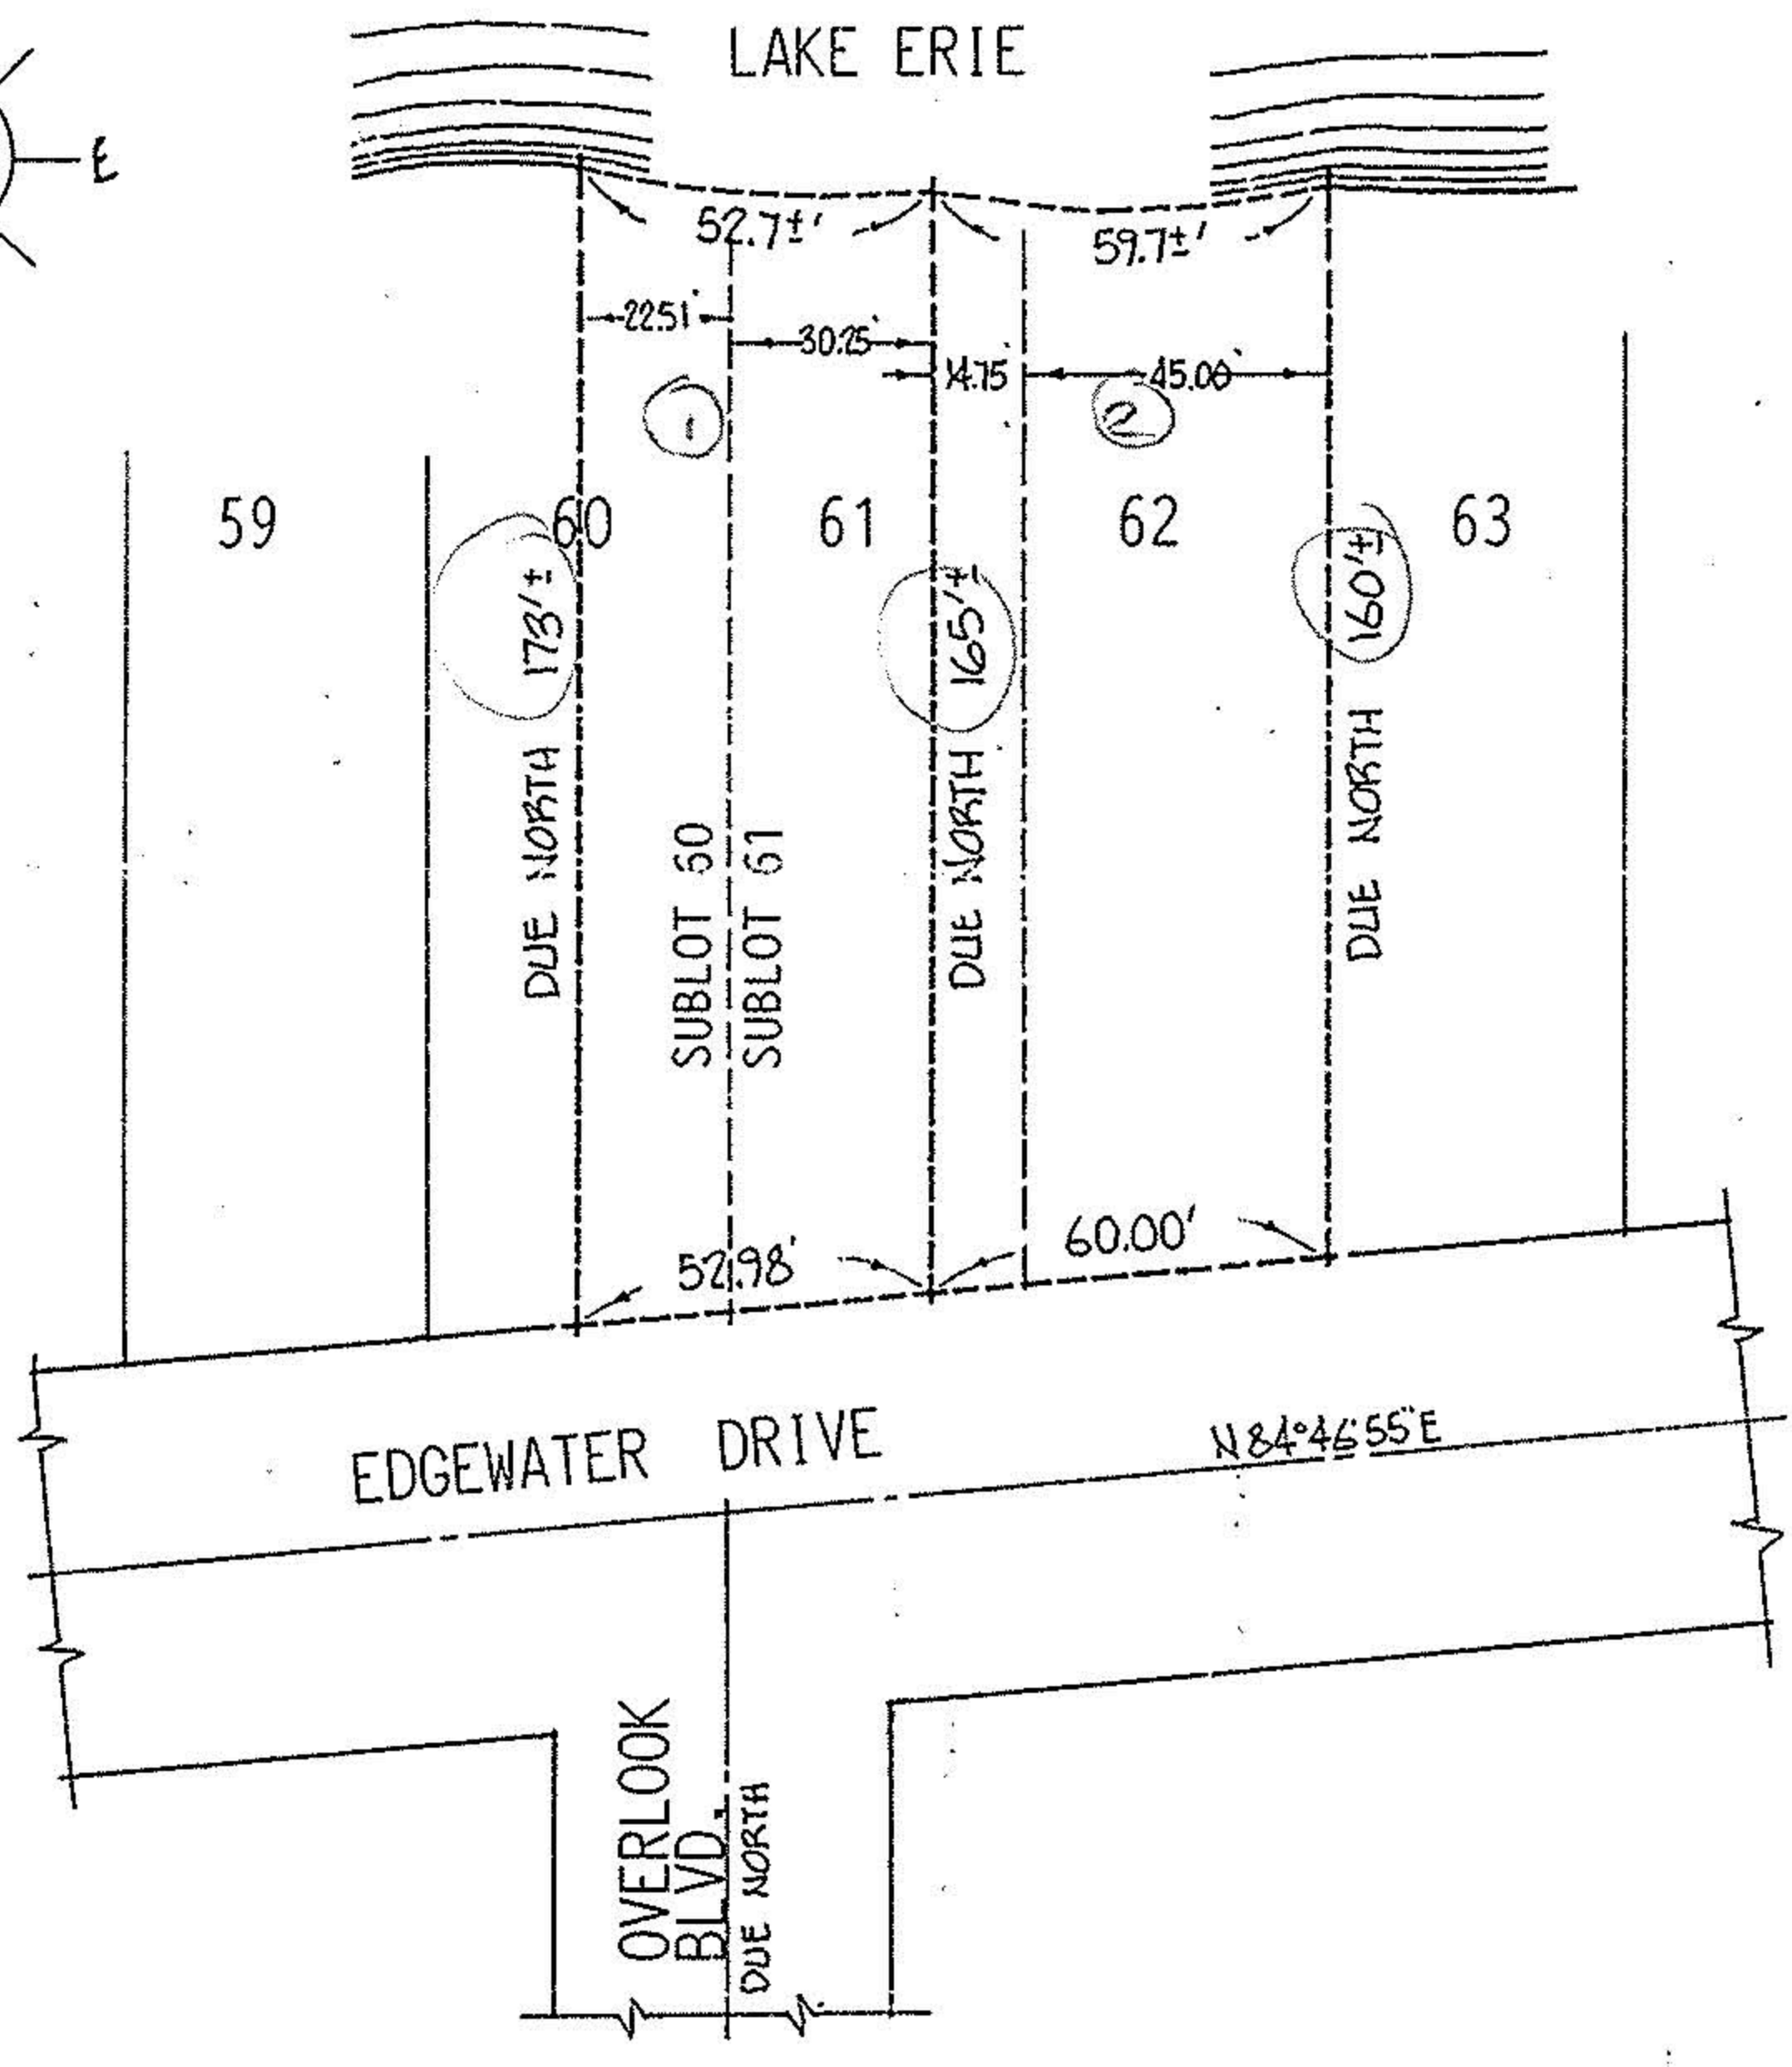


#18554 01-00-003-101-

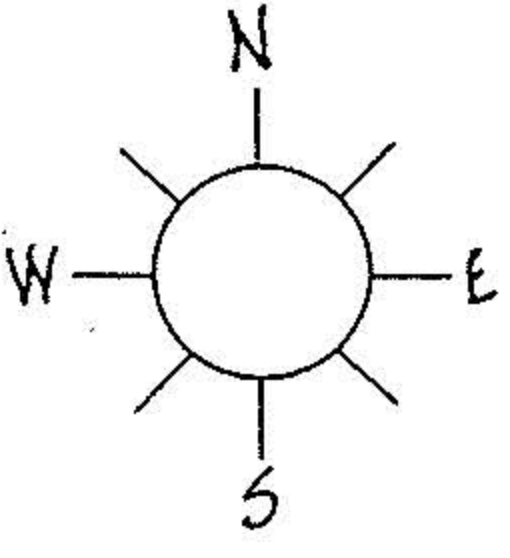

VERMILION PLANNING COMMISSION;

Mr. David M. Lackstrom of Medina, Ohio, holds title to Sublots 61, 62, and the easterly 22.51 feet of Sublot 60, Vermilion-On-The-Lake, as individual parcels. It is his intent to create two new parcels from the three existing parcels, frontages and dimensions as indicated above.

#18554

APPROVED LORAIN CO. MAP DEPT.	
DATE 8-3-89	
PAGE 1-00-003-A	
BY T. McMan	
VOID AFTER	18554

01-00-003-101-061
062
063

ACREAGE NA	PREPARED FOR <u>MR. DAVID LACKSTROM</u>	CITY OF Vermilion
DATE <u>APR 89</u>	<u>MEDINA, OHIO</u>	
DRAWN <u>MGH</u>	MICHAEL G. HURA registered surveyor	
SCALE 1" = 50 ft.	12706 MASON ROAD, VERMILION, OHIO (216) 965-4040	
PARCEL SPLIT APPROVAL		
SUBLOTS <u>61-62 & PART 60</u> OF <u>VERMILION-ON-THE-LAKE</u> SUBDIN <u>Nº 1</u> Volume <u>10</u> Page <u>18</u> of PLATS PART OF O.L. _____ TRACT _____ SECTION _____ OF <u>BROWNHELM</u> TOWNSHIP <u>LORAIN</u> CO., OHIO		
Perm. Parcel Nº _____ Ref. deed: _____		

