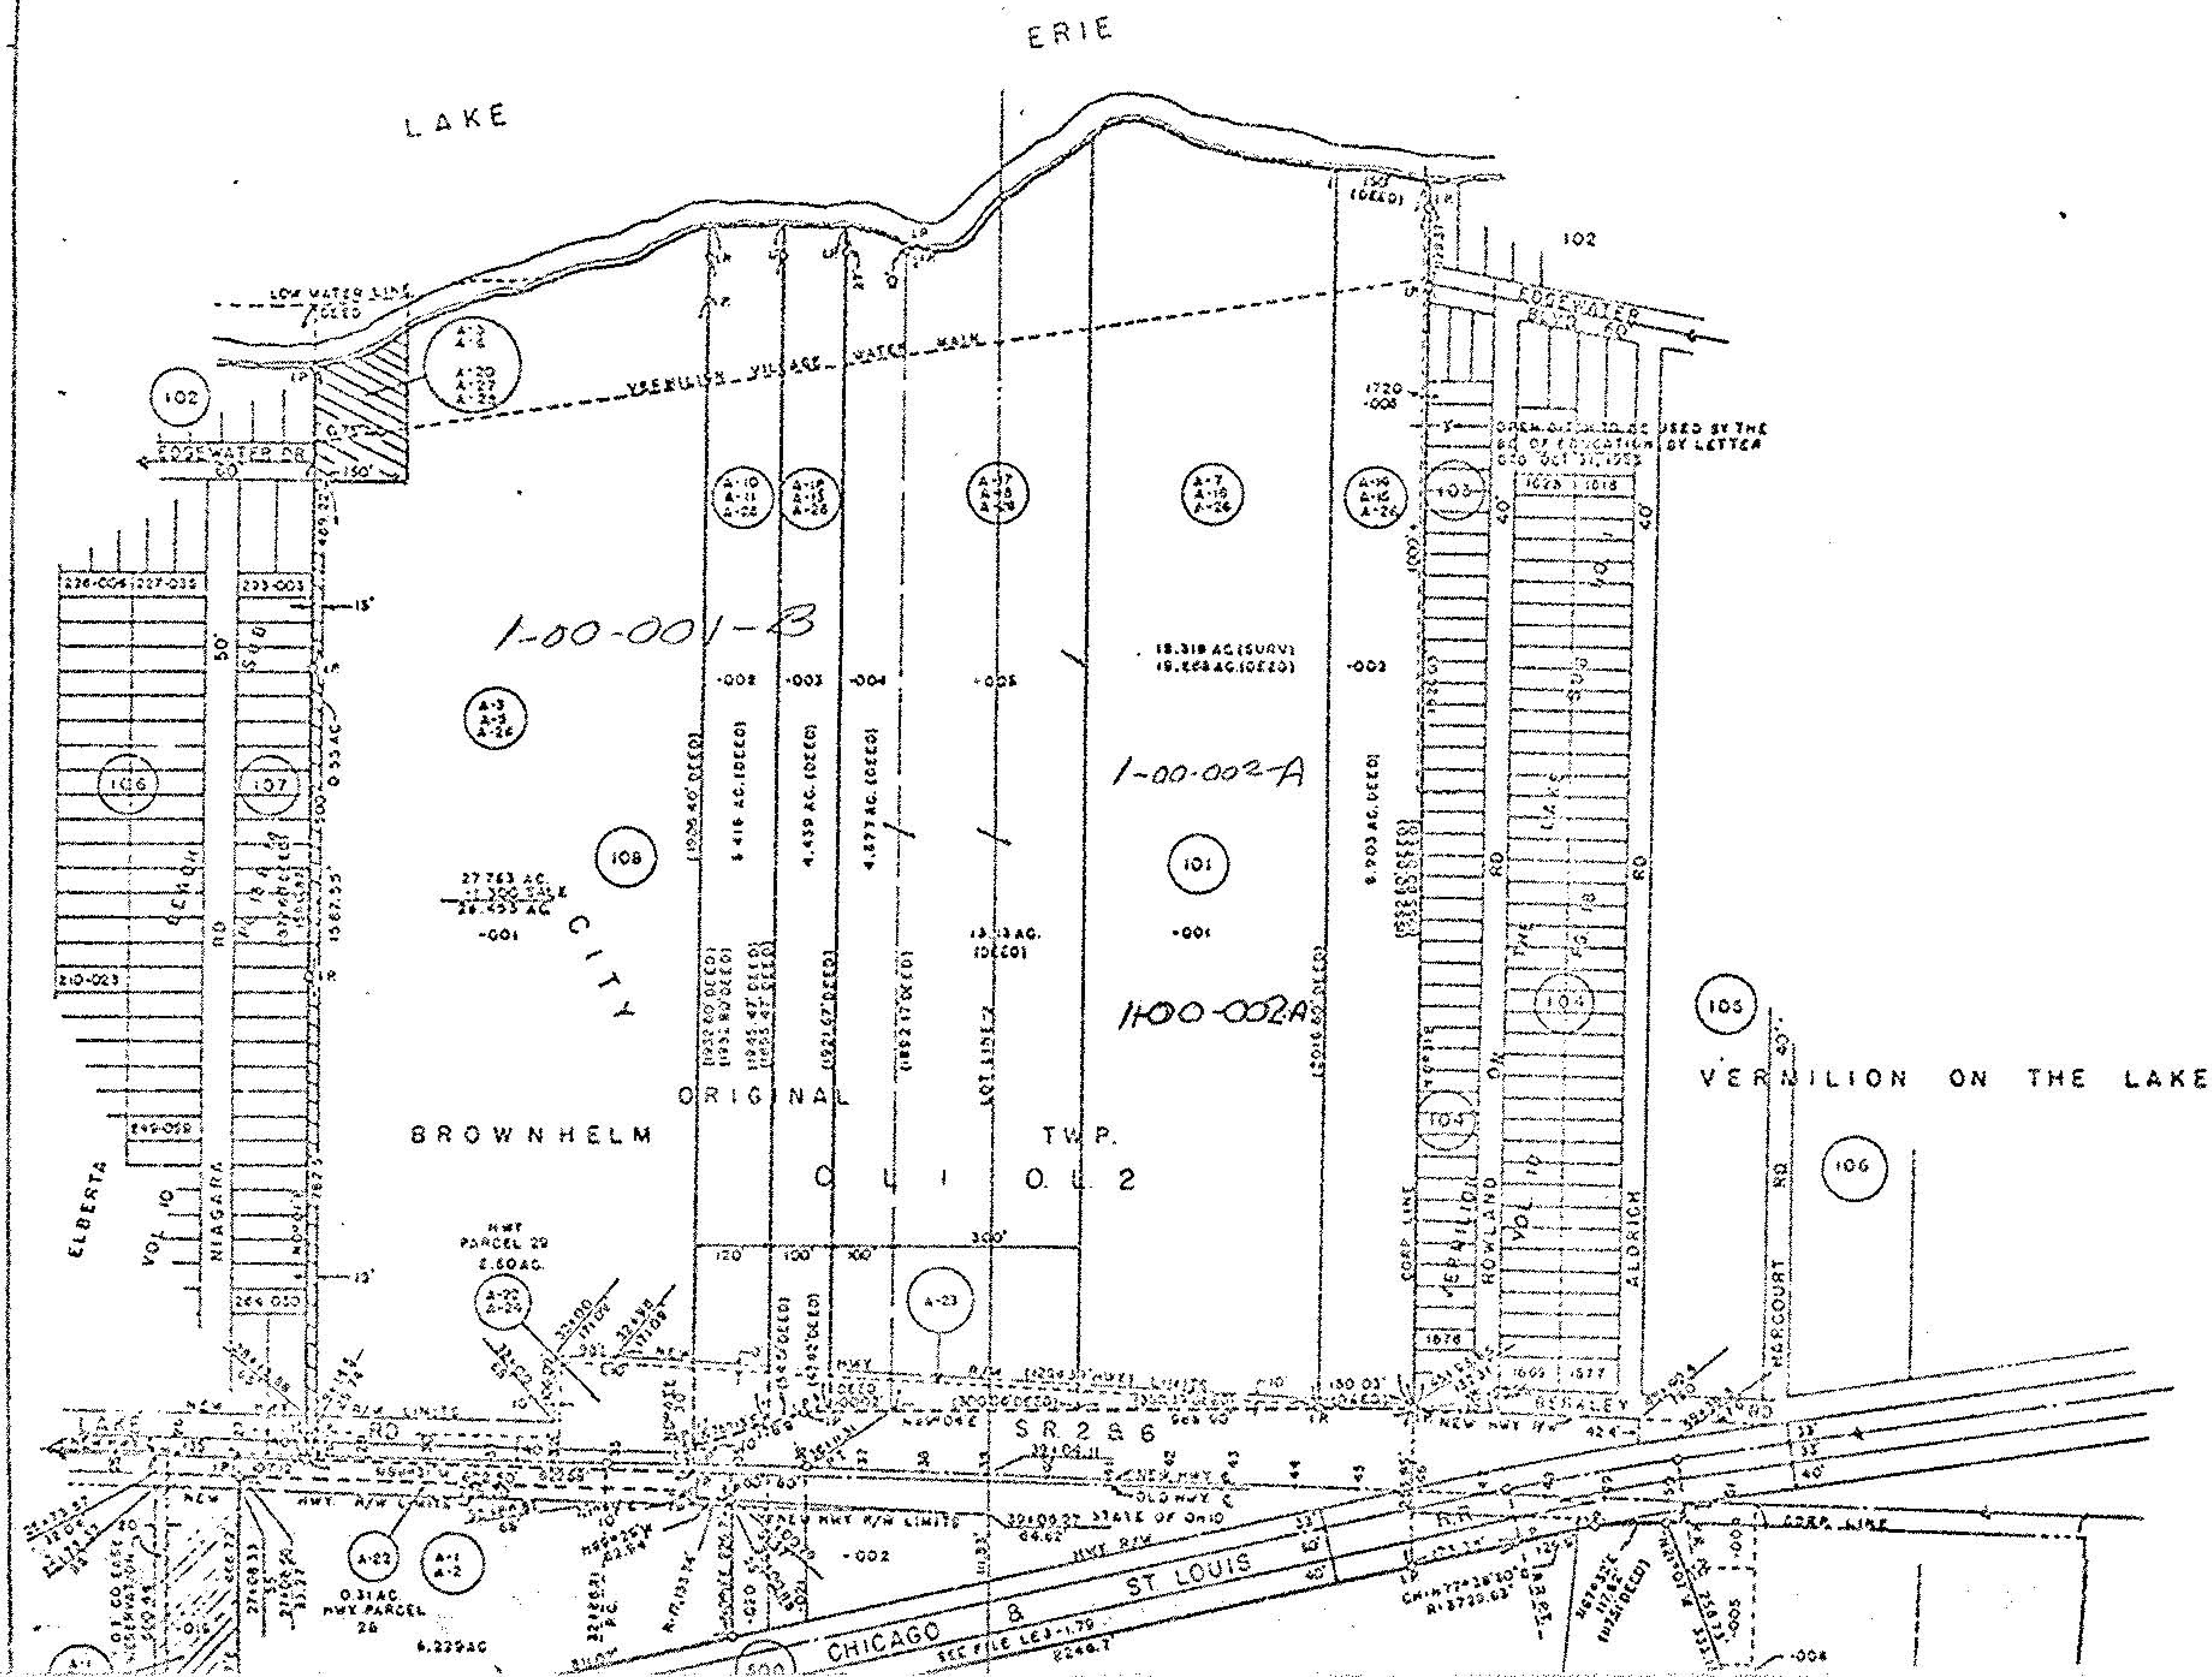01-00-001-110-016
P.P.N. 01-00-002-115-049