CATION SERVICE

CRIPTION:

PARCEL- O.L. 1

PLAT VOL PAGE

CITY OF VERMILION

BROWNHELM TWP LORAIN CO., OHIO

01-00-001-103-107

made for and at the instance of:

LINCOLN MORTGAGE INVESTORS &

LOUISVILLE TITLE INSURANCE CO.

order no.

(a) THE ATTACHED IS A PHOTOGRAPH OF THE PREMISES KNOWN AS
CRYSTAL SHORES CONDOMINIUM

(b) THE PLAT SHOWN HEREON CORRECTLY INDICATES THE BOUNDARIES OF SAID PREMISES

(c) THE BUILDINGS SHOWN ON SAID PLAT LIE ENTIRELY WITHIN SAID BOUNDARIES.

(d) THERE ARE NO ENCROCHMENTS OF ADJOINING BUILDINGS OR OTHER IMPROVEMENTS OR APPARENT EASEMENTS ON SAID PROPERTY.

THE FOLLOWING INFORMATION WAS OBTAINED BY PERSONAL INSPECTION AND INQUIRY ON MAY 17 197 2:

(a) NO MATERIAL HAS BEEN FURNISHED NOR WORK BEEN PERFORMED FOR THE IMPROVEMENT OF SAID PREMISES.

(b) PREMISES VACANT ARE IN POSSESSION OF SAID PREMISES AS OWNERS

PLOT PLAN

SCALE 1"=200 ft.

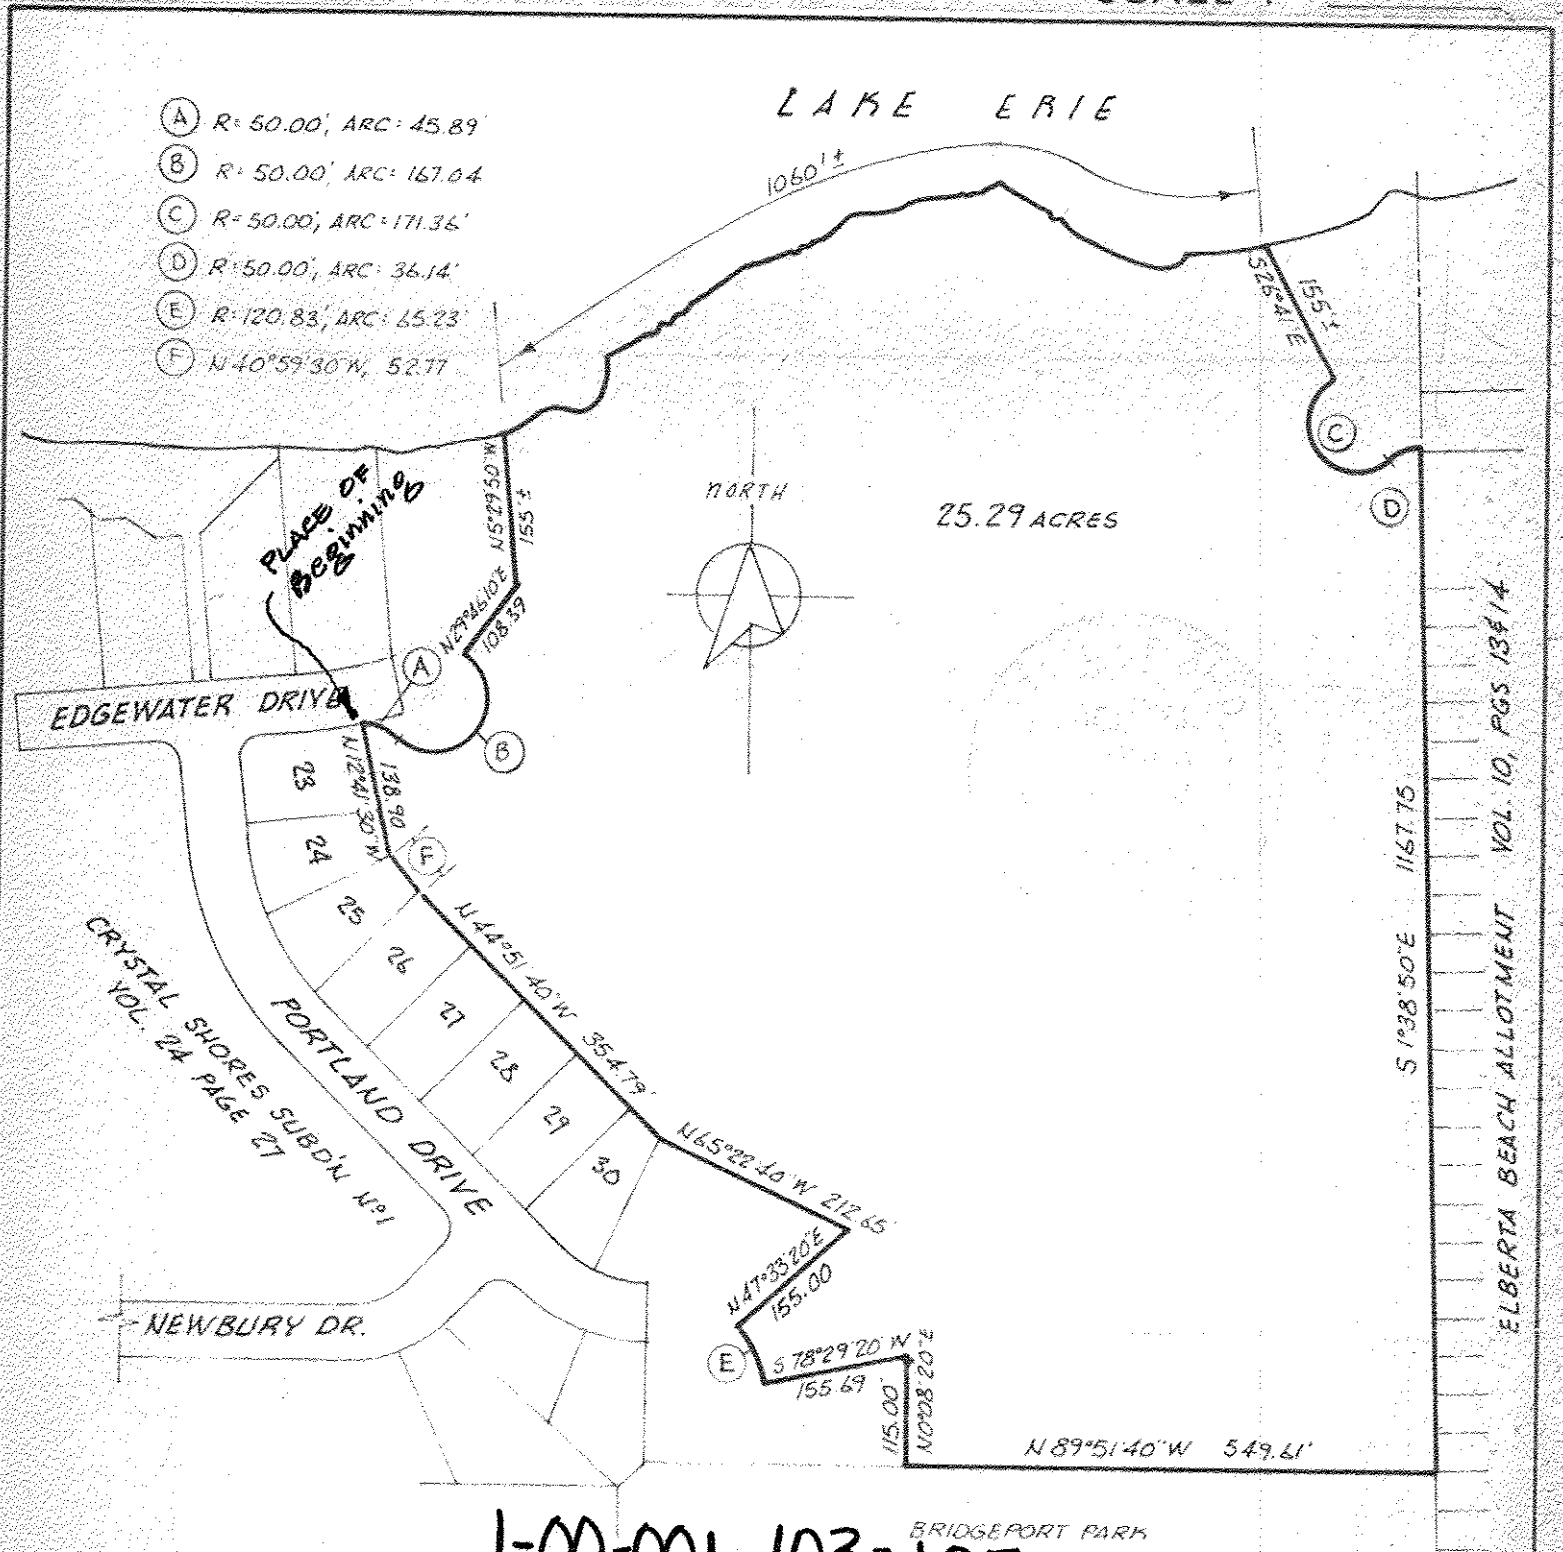

1-00-001-103-107

Note: The survey as shown hereon is a representation of and agrees with the legal description attached.

This survey was performed for LINCOLN MORTGAGE INVESTORS, a California Business Trust, as mortgagee, and LOUISVILLE TITLE INSURANCE COMPANY.

Michael G. Hura
REGISTERED SURVEYOR 4712
623 TERRA LANE
AMHERST, OHIO 44001
phone 988-4040