
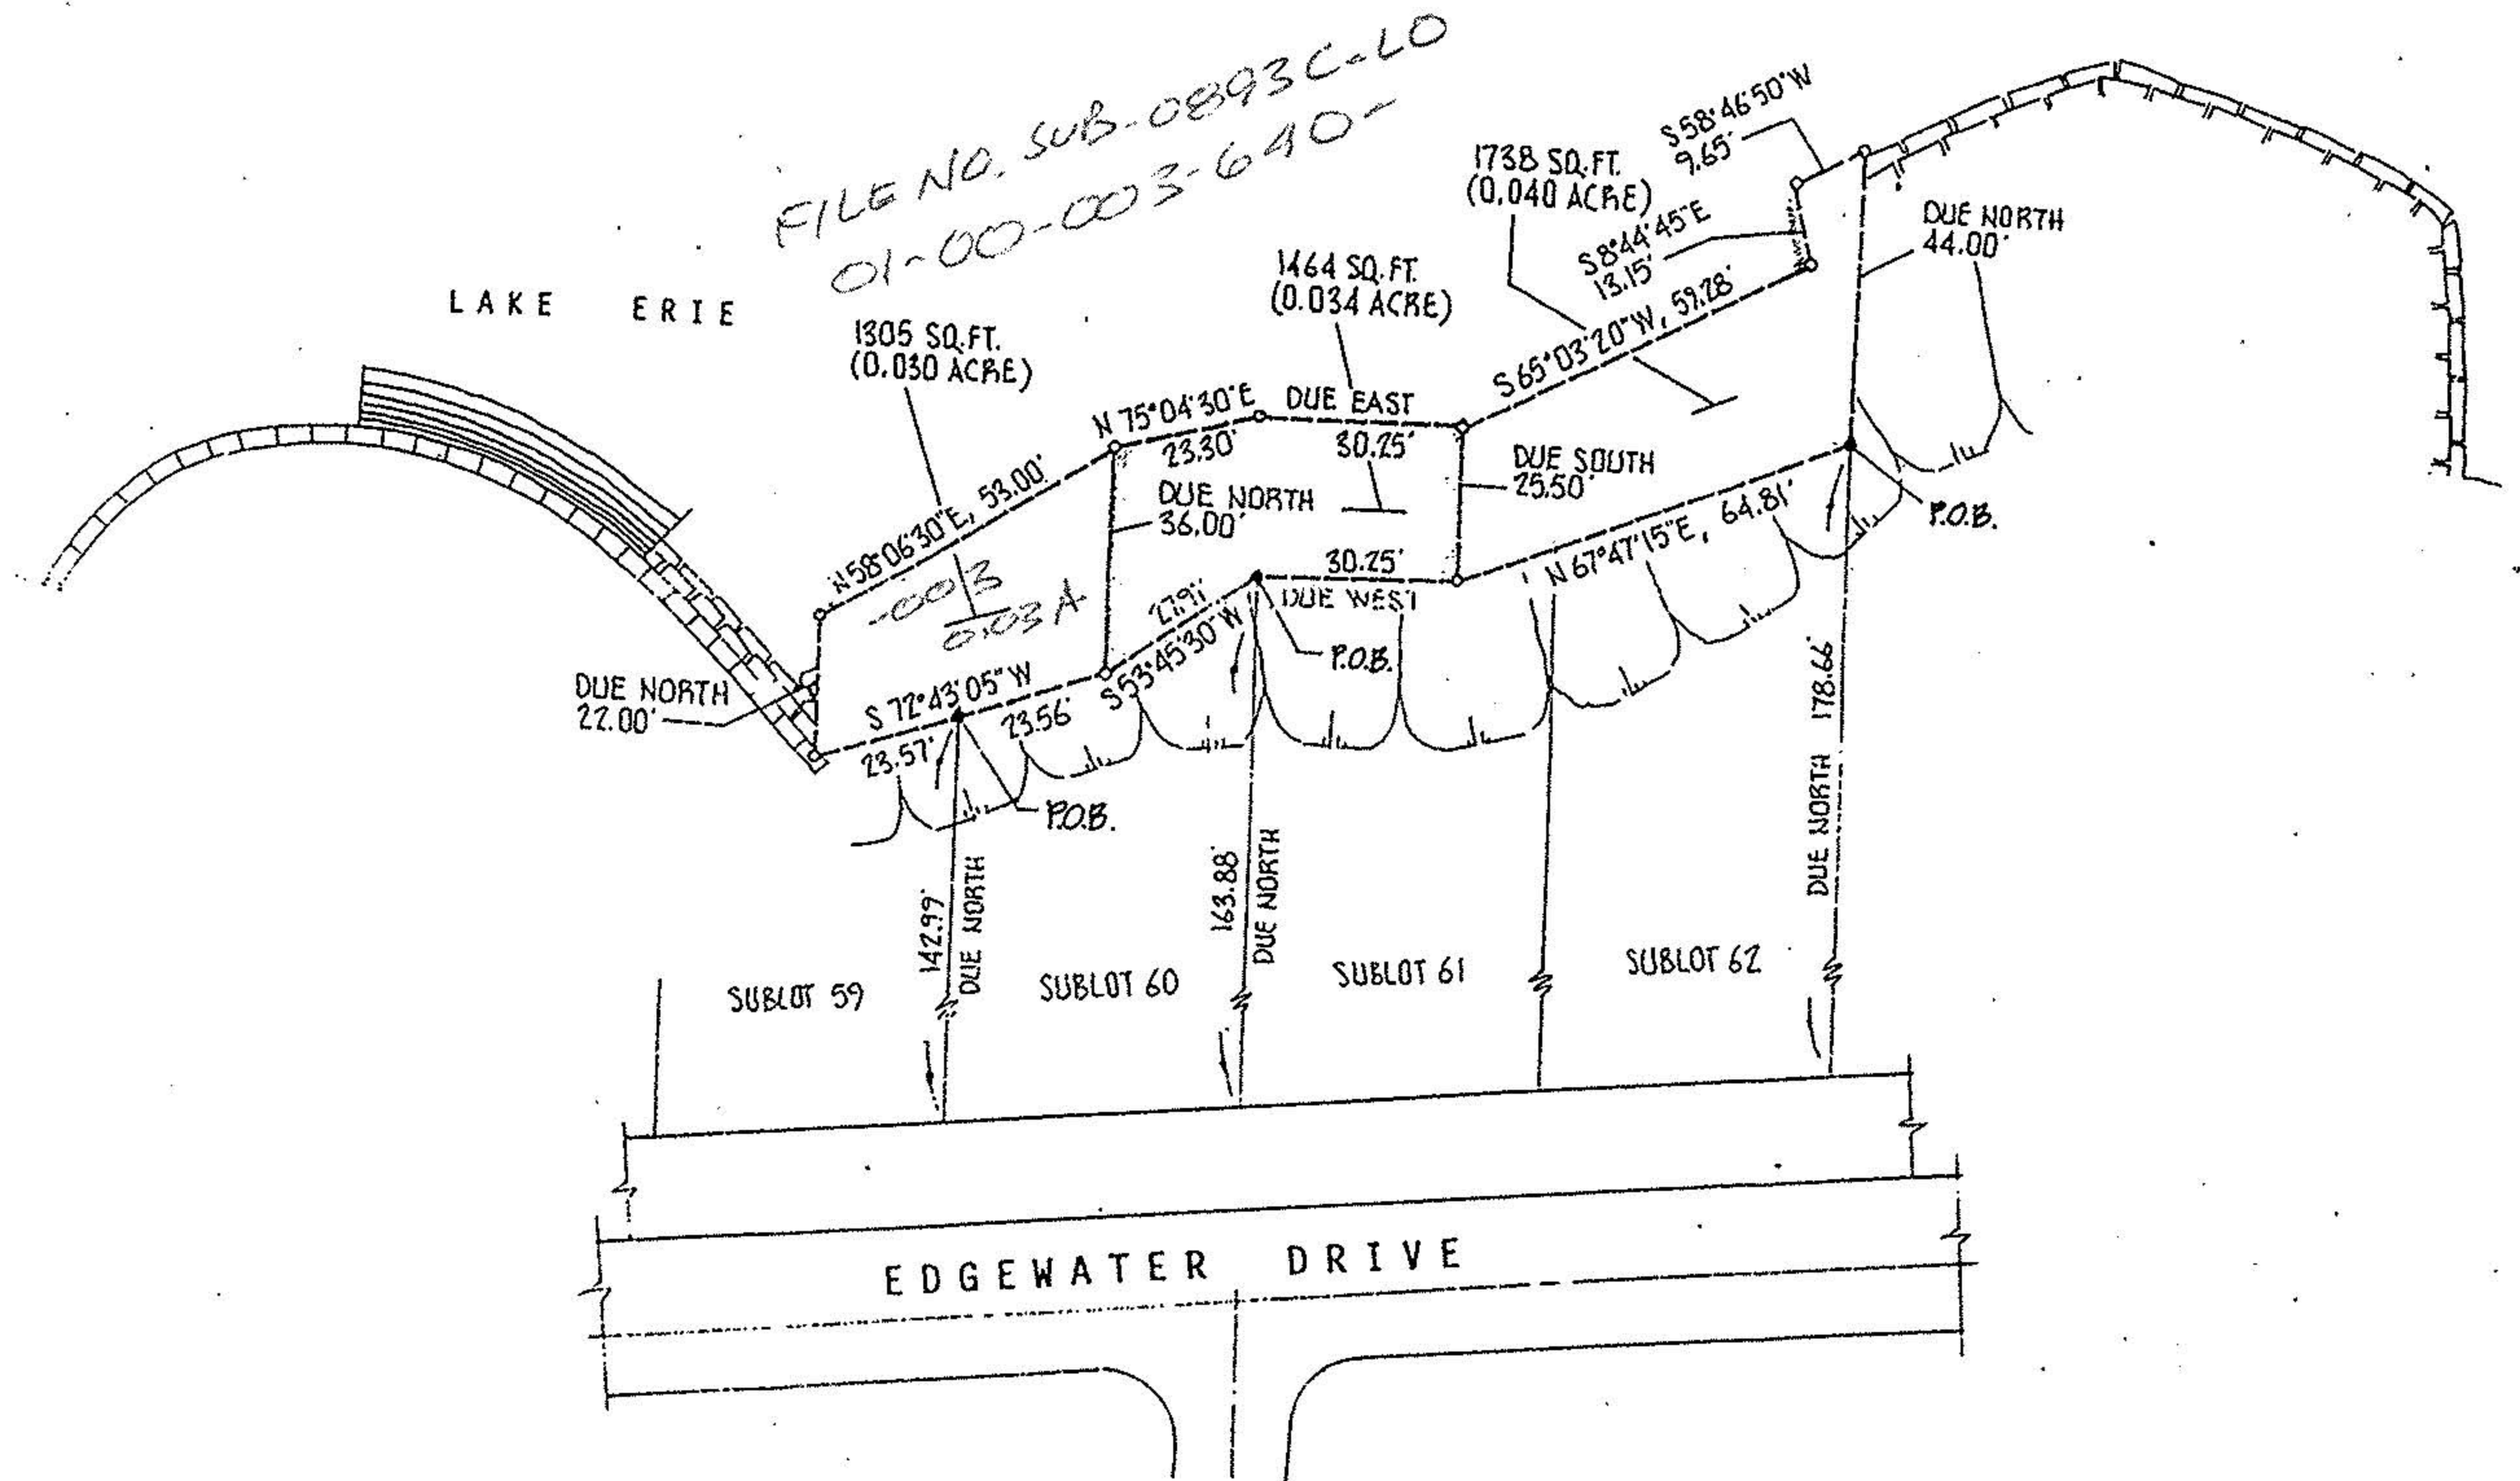


RE: NO 01-00768


01-00-003-640-003

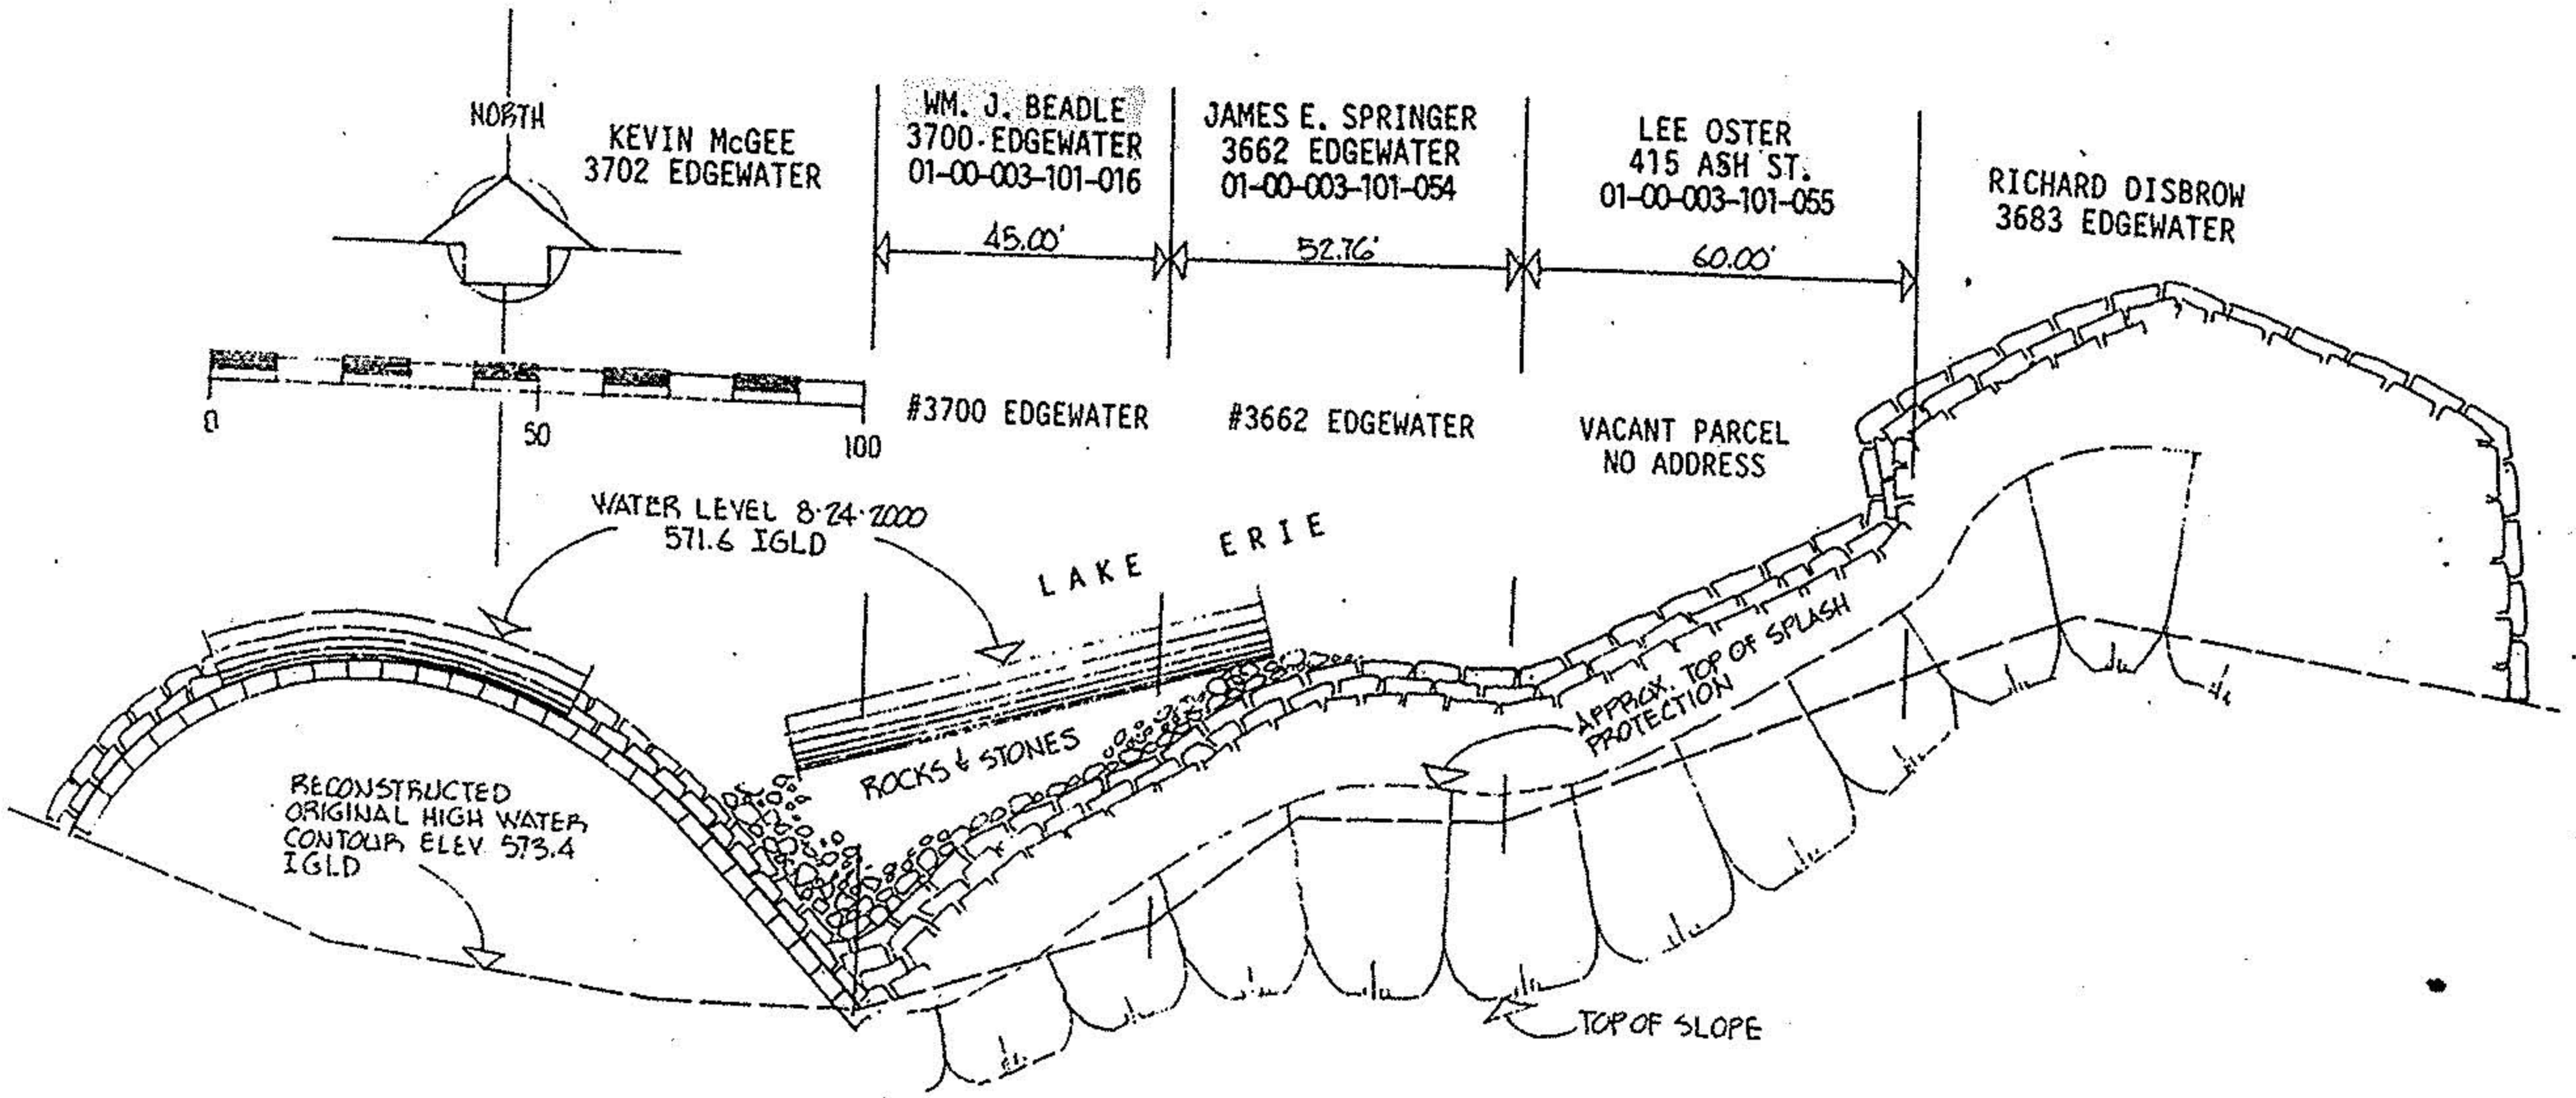

01 #00768

3 PARCELS ON LAKE ERIE  
 CITY OF VERMILION, OHIO  
 AUGUST, 2000 SCALE 1" = 40 FT.  
 M.G. HURA REGISTERED SURVEYOR

APPE  
 LOR  
 M  
 64-01  
 PAGE 1-00-003-A  
 BY T. SPILLMAN  
 01-00768

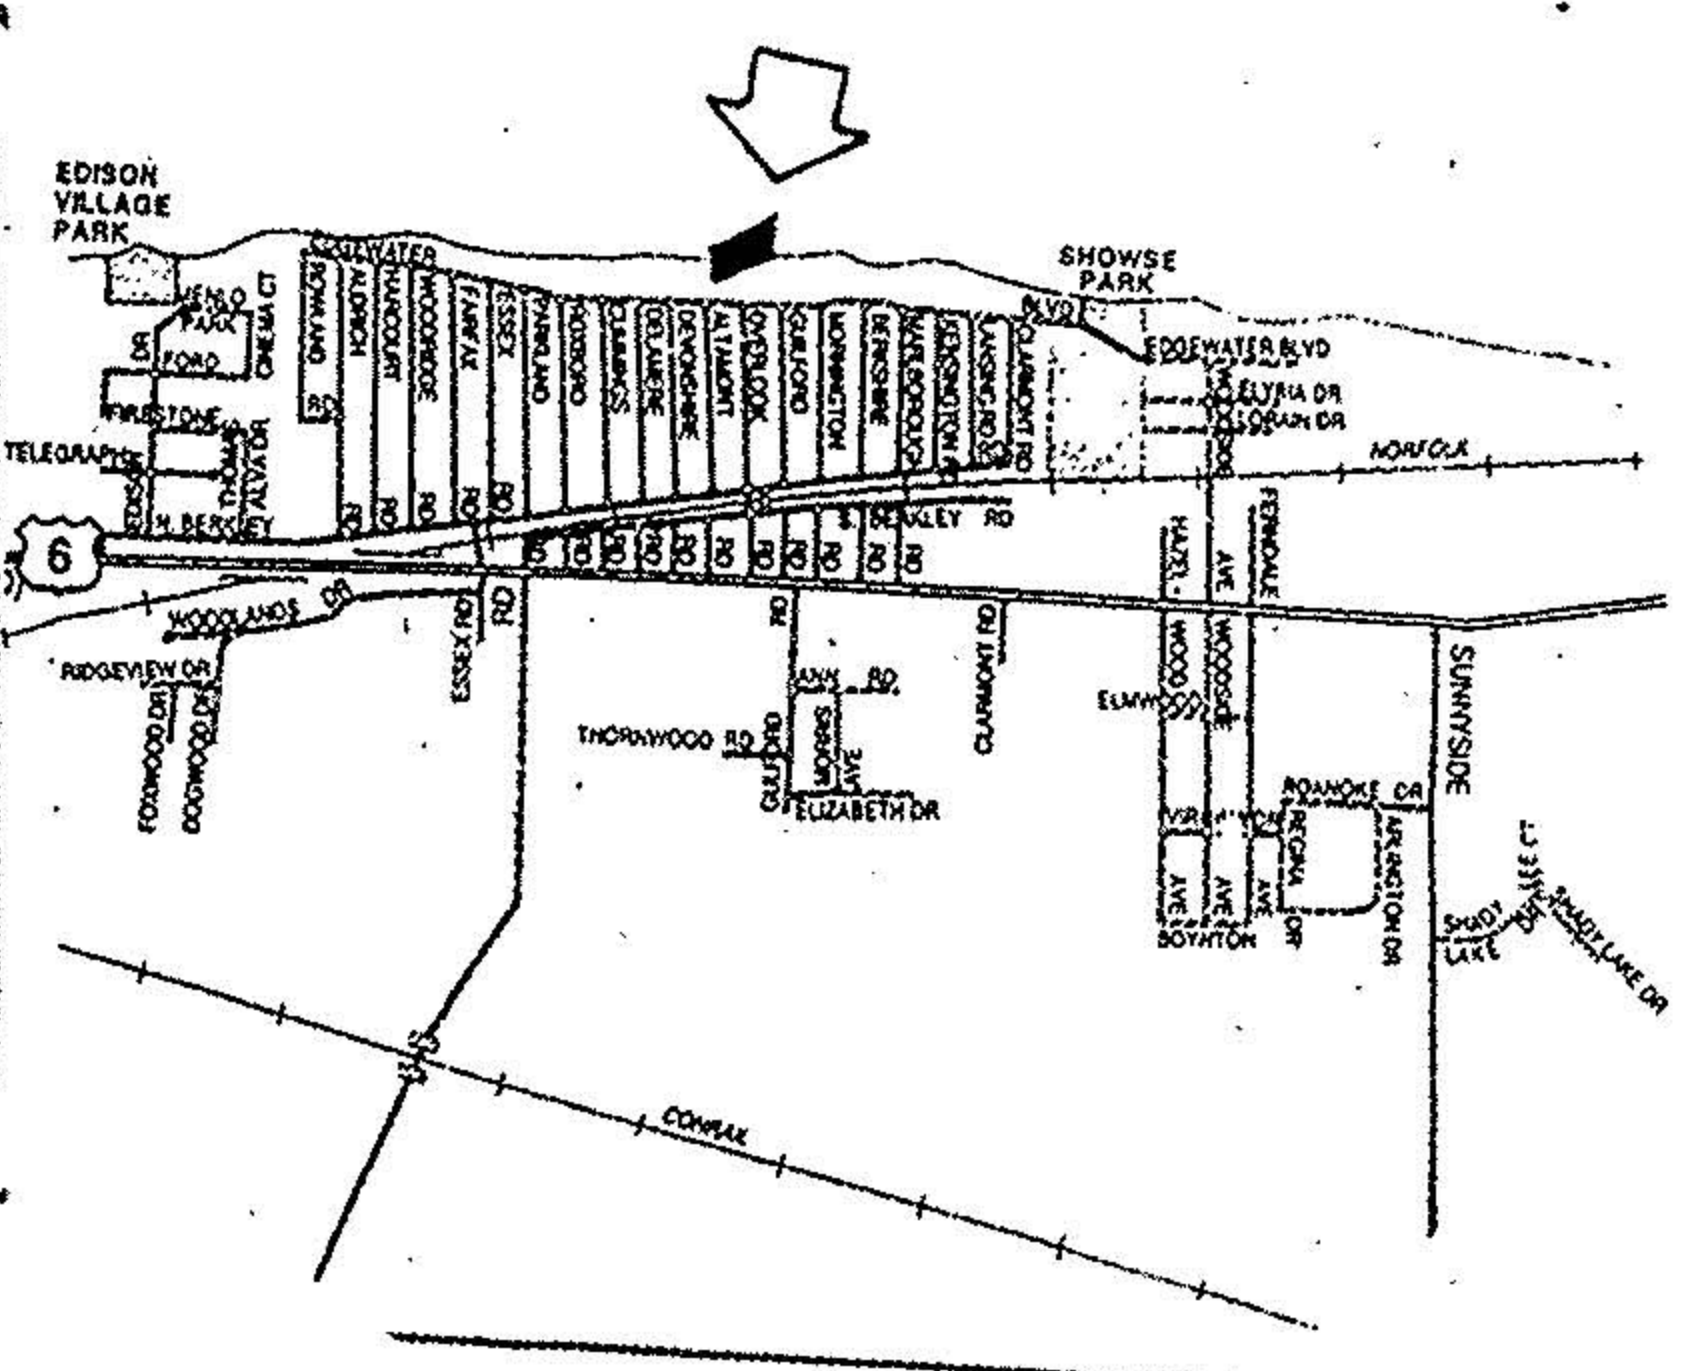

SUBMERGED LAND LEASE