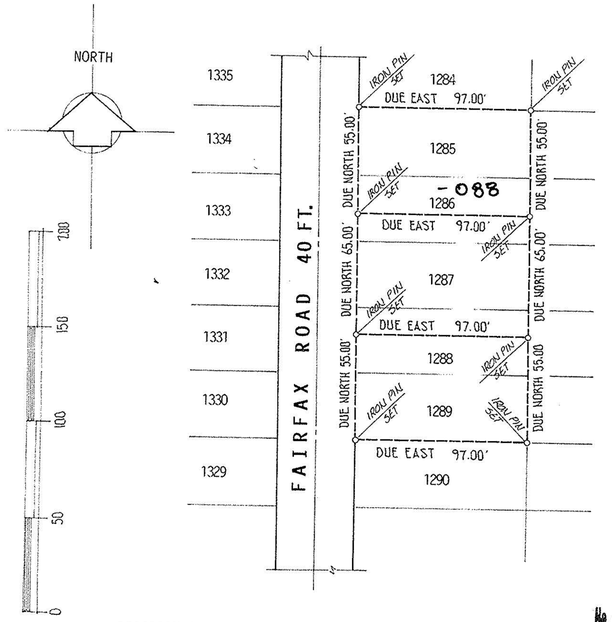

REVISED 05-25-02
DESTROY ALL
PREVIOUS COPIES

DESCRIPTION- NORTHERLY PARCEL

SITUATED in the City of Vermilion, County of Lorain and State of Ohio. Being all of Sublot 1285 and the northerly 20.00 feet of Sublot 1286 of Vermilion-on-the-Lake Subdivision No.1 as recorded in Volume 10, Page 18 of Plat Records, forming a parcel of land of 55.00 feet width contiguous and perpendicular to the easterly line of Fairfax Road and extending easterly a distance of 97.00 feet to its rear line, as surveyed by M.G. Hura, May, 2001.

№01078

APPROVED
LORAIN CO.
MAP DEPT
DATE 5-30-02
PAGE 1-00-002-B
BY JHatfield
#02-01078

acreage	N.A.
date	MAY-2001
drawn	MGH
scale	1"=50'

STATE OF OHIO
M G. HURA
No 4712
REGISTERED PROFESSIONAL SURVEYOR

prepared for SEDER CONSTN. 967-3327
13319 DARROW RD — VERMILION 44089

MICHAEL G. HURA, REGISTERED SURVEYOR
12706 Mason Road, Vermilion Ohio (216)965-4040

PERIMETER SURVEY

SUBLOT(S) MISC. OF VERMILION-ON-THE LAKE SUBDN#1 Volume 10 Page 18 of PLATS
PART of O.L. ____ Tract ____ Section ____ of BROWNHELM TOWNSHIP LORAIN CO., OHIO

City of Village of VERMILION

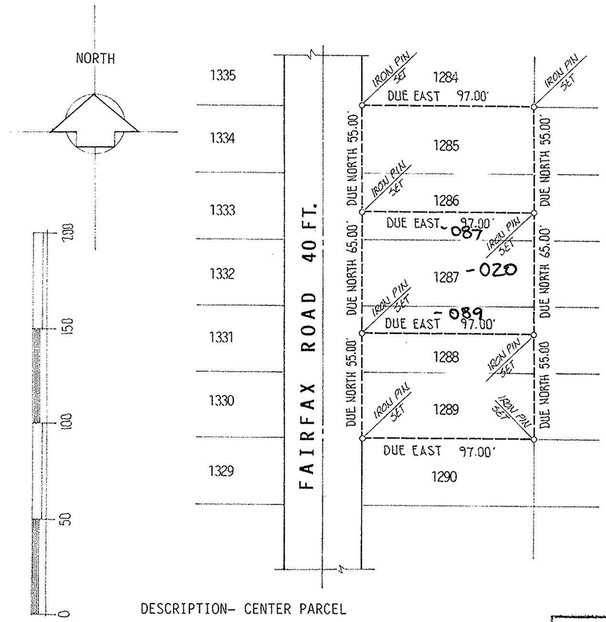

REVISED 05-25-02
DESTROY ALL
PREVIOUS COPIES

DESCRIPTION- CENTER PARCEL

SITUATED in the City of Vermilion, County of Lorain and State of Ohio. Being all of Sublot 1287, the southerly 15.00 feet of Sublot 1286, and the northerly 15.00 feet of Sublot 1288 of Vermilion-on-the-Lake Subdivision No.1 as recorded in Volume 10, Page 18 of Plat Records, forming a parcel of land of 65.00 feet width contiguous and perpendicular to the easterly line of Fairfax Road and extending easterly a distance of 97.00 feet to its rear line, as surveyed by M.G. Hura, May, 2001.

№01078

APPROVED
LORAIN CO.
MAP DEPT
DATE 5-30-02
PAGE 1-00-002-B
BY JHatfield
#02-01078

acreage	N.A.
date	MAY-2001
drawn	MGH
scale	1"=50'

STATE OF OHIO
M G. HURA
No 4712
REGISTERED PROFESSIONAL SURVEYOR

prepared for SEDER CONSTN. 967-3327
13319 DARROW RD — VERMILION 44089

MICHAEL G. HURA, REGISTERED SURVEYOR
12706 Mason Road, Vermilion Ohio (216)965-4040

PERIMETER SURVEY

SUBLOT(S) MISC. OF VERMILION-ON-THE LAKE SUBDN#1 Volume 10 Page 18 of PLATS
PART of O.L. ____ Tract ____ Section ____ of BROWNHELM TOWNSHIP LORAIN CO., OHIO

City of Village of VERMILION

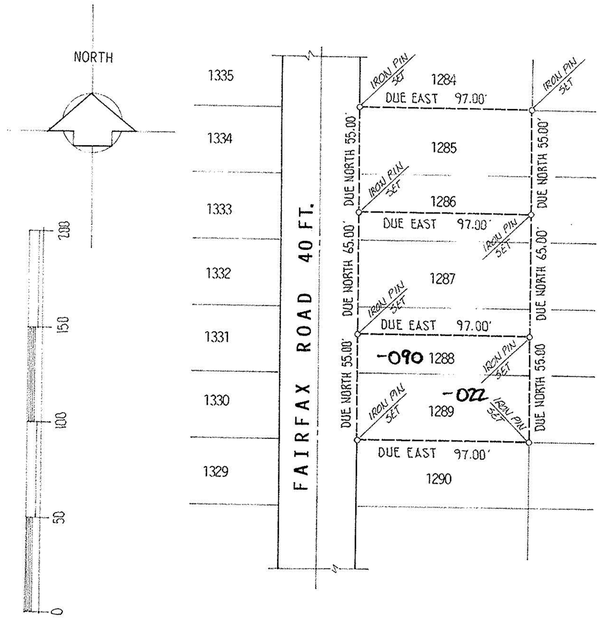

REVISED 05-25-02
DESTROY ALL
PREVIOUS COPIES

DESCRIPTION- SOUTHERLY PARCEL

Situated in the City of Vermilion, County of Lorain and State of Ohio. Being known as all of Sublot 1289 and the southerly 20.00 feet of Sublot 1288 of Vermilion-on-the-Lake Subdivision No.1 as recorded in Volume 10, Page 18 of Plat Records, forming a parcel of land of 55.00 feet width contiguous and perpendicular to the easterly line of Fairfax Road and extending easterly a distance of 97.00 feet to its rear line, as surveyed by M.G. Hura, May, 2001.

acreage	N.A.
date	MAY-2001
drawn	MGH
scale	1"=50'

STATE OF OHIO
M G. HURA
No 4712
REGISTERED PROFESSIONAL SURVEYOR

prepared for SEDER CONSTN. 967-3327
13319 DARROW RD — VERMILION 44089

MICHAEL G. HURA, REGISTERED SURVEYOR
12706 Mason Road, Vermilion Ohio (216)965-4040

PERIMETER SURVEY

SUBLOT(S) MISC. OF VERMILION-ON-THE LAKE SUBDN#1 Volume 10 Page 18 of PLATS
PART of O.L. ____ Tract ____ Section ____ of BROWNHELM TOWNSHIP LORAIN CO., OHIO

City of Village of VERMILION