
ACDE ACE

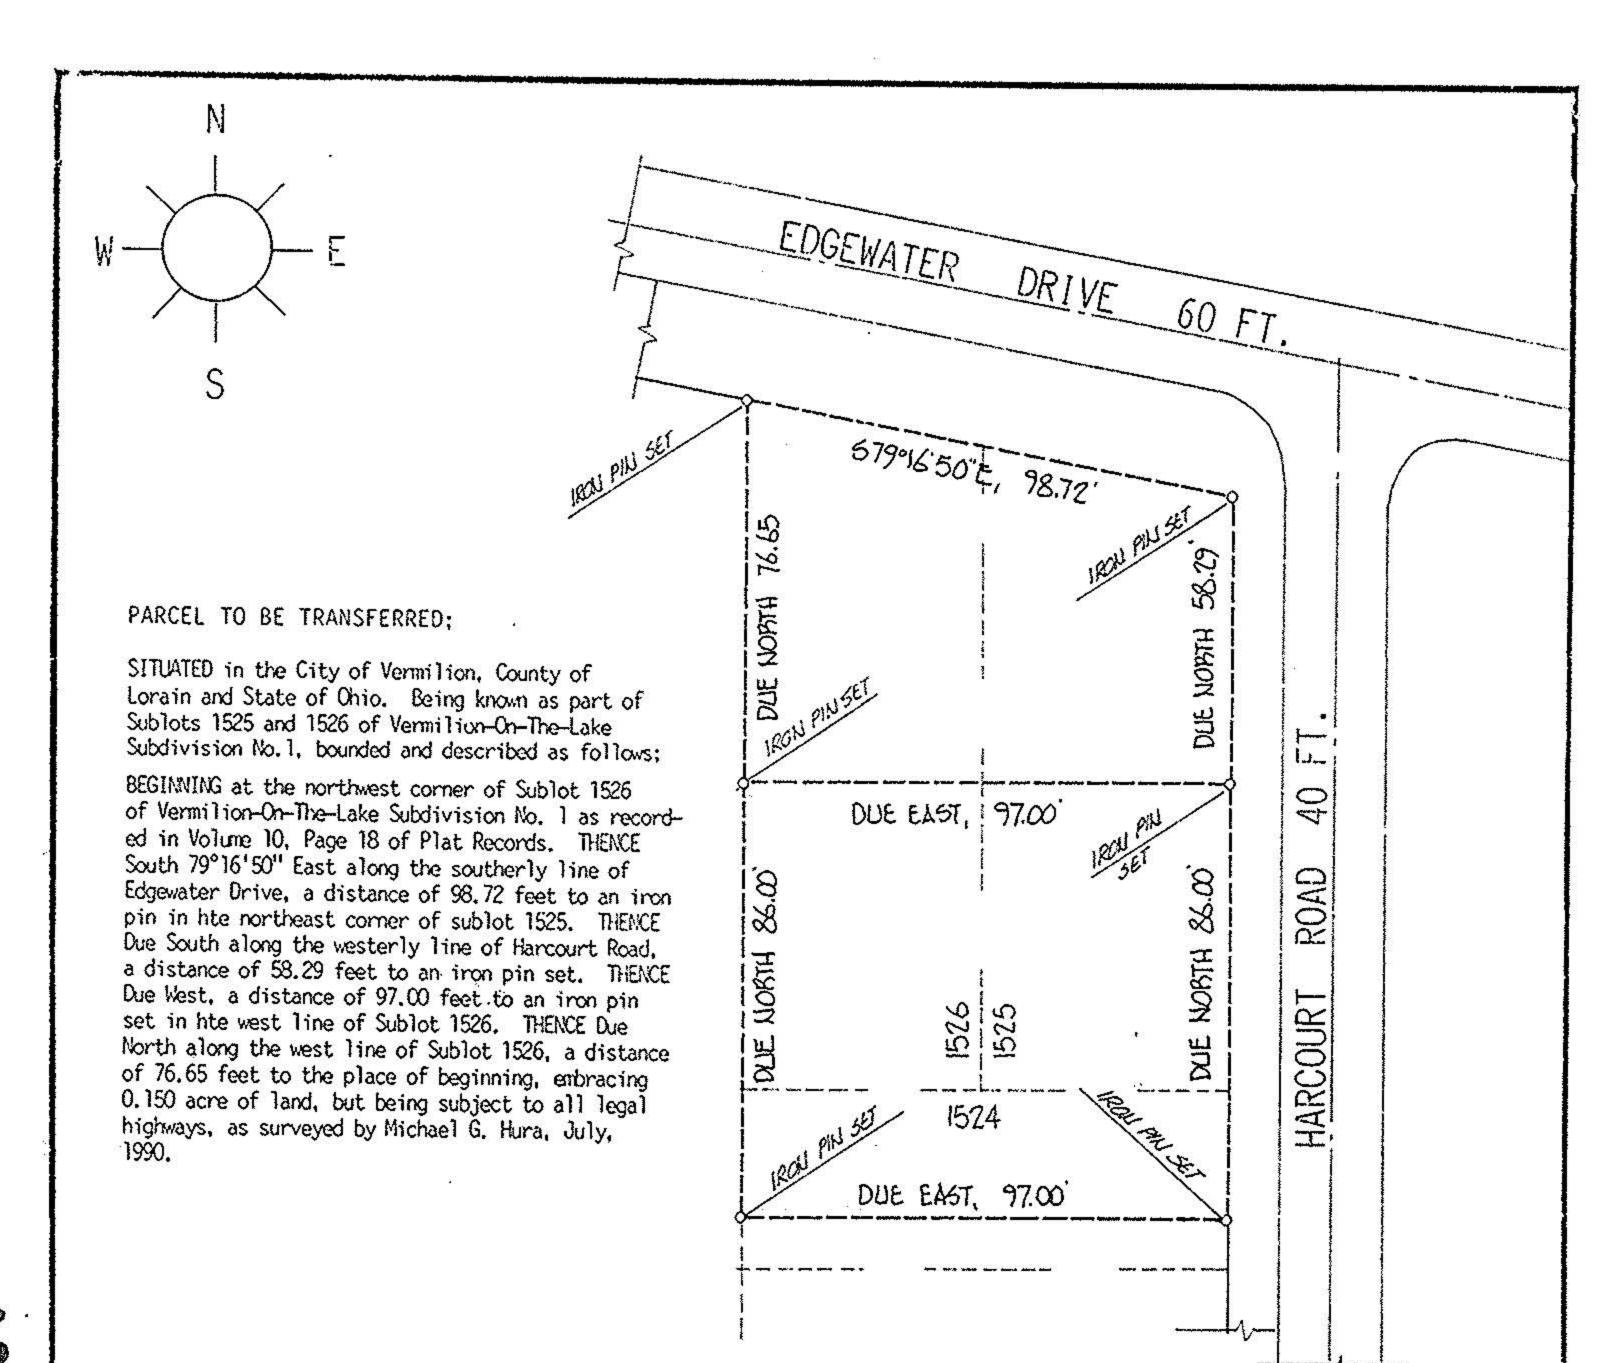

PARCEL TO REMAIN;

SITUATED in hte City of Vermilion. County of Lorain and State of Ohio. Being known as parts of Sublots 1524, 1525, and 1526 of Vermilion-On-The-Lake Subdivision No. 1 as recorded in Volume 10, Page 18 of Plat Records, bounded and described as follows:

BEGINNING at a point in the westerly line of Harcourt Road being ten (10.00) feet northerly form the southeast corner of Sublot 1524. THENCE Due North along the west line of Harcourt Road, a distance of 86.00 feet to an iron pin set. THENCE Due West, a distance of 97.00 feet to an iron pin set in the west line of Sublot 1526. THENCE Due South in the west lines of Sublots 1526 and 1524, a distance of 86.00 feet to an iron pin set. THENCE Due East in a line parallel to the south line of Sublot 1524 and being ten feet therefrom, a distance of 97.00 feet to an iron pin set and the place of beginning, embracing 0.191 acre of land, but being subject to all legal highways.

20027

APPROVED LORAIN CO. MAP DEPT.

DATE 8-3 792

PAGE I-UU-UUZ A BY FRANCIS VOID AFTER #1 200 27

P.P.N.01-00-002-105-085

DATE JULY-90	285 HARCOURT - VERMILION
DRAWN MGH SCALE 1" = 40 ft. MICHAEL G. HURA No. 4712	MICHAEL G. HURA registered surveyor 12706 MASON ROAD, VERMILION, OHIO [216] 965-4040
	PERIMETER SURVEY
	SUBLOT 1525-1526 & PART 1524 OF YERMILION -ON-THE-LAKE PART OF O.L. TRACT SECTION OF ON-THE-LAKE BROWNHELD 1525-1526 & PART 1524 OF YERMILION -ON-THE-LAKE SUBLOT 1525-1526 & PART 15

Perm. Parcel No

Ref. deed: