


#22432

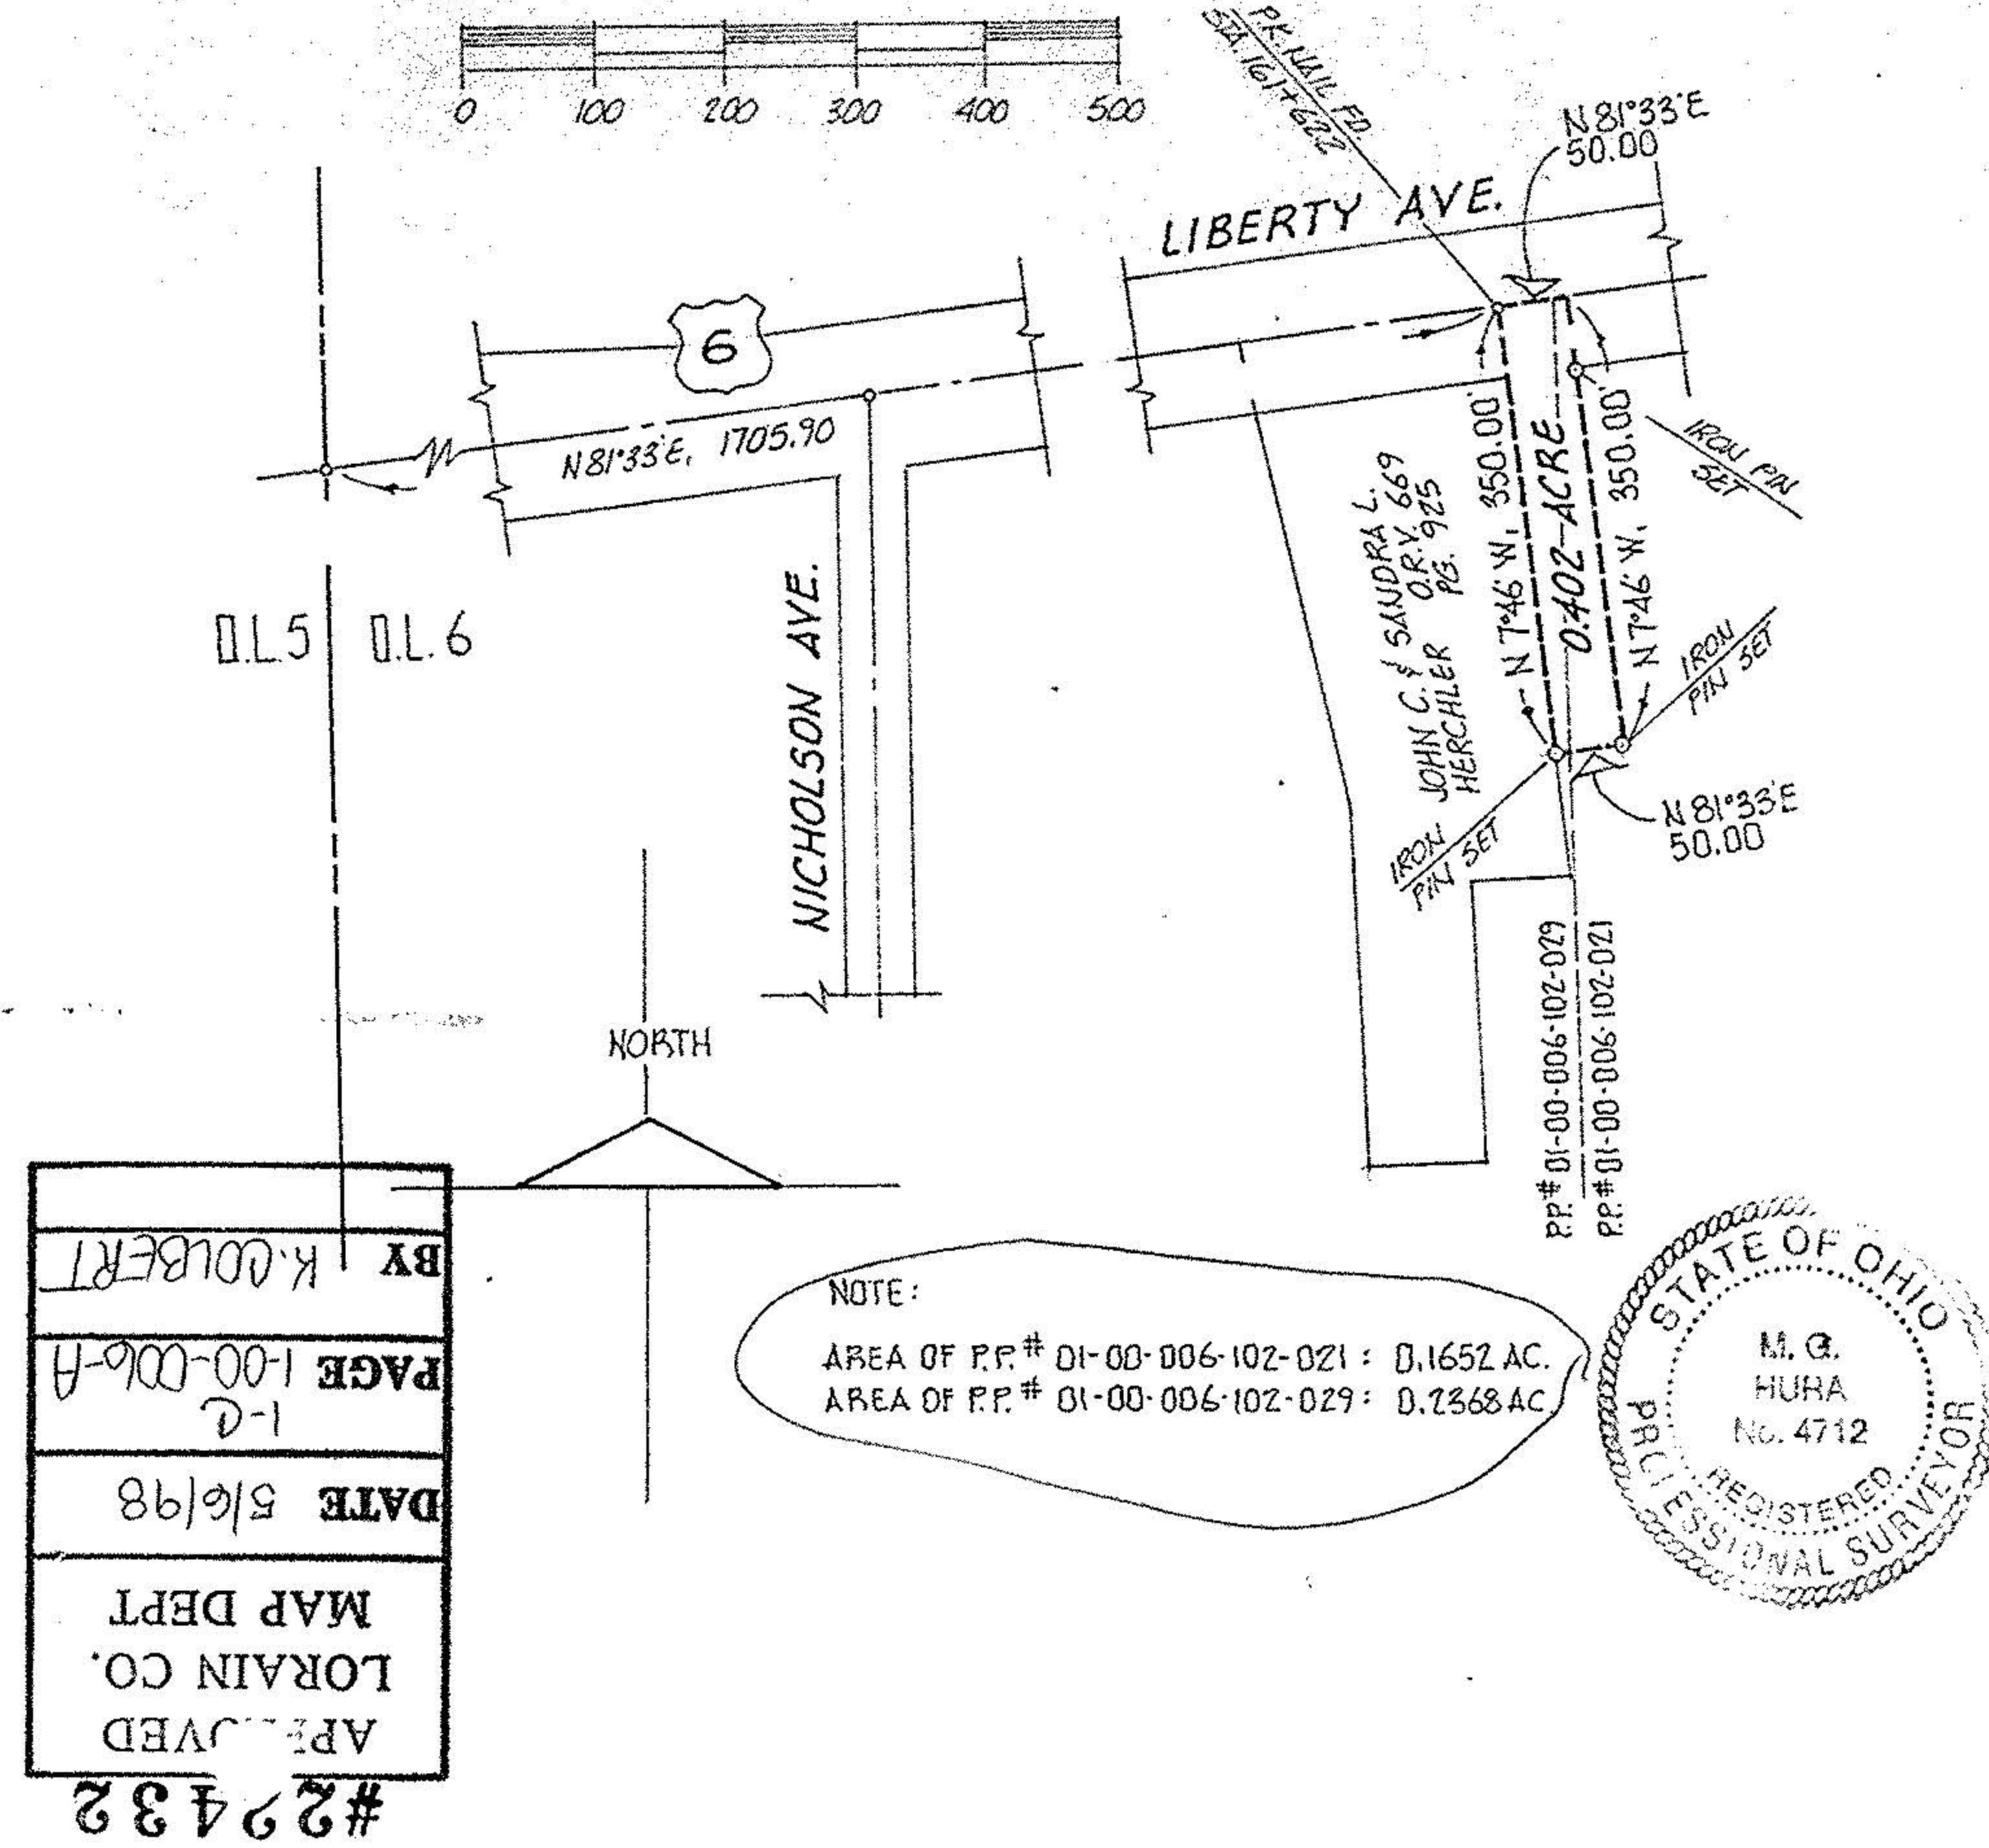

APPROVED
 LORAIN CO. MAP DEPT
 DATE 5/6/98
 PAGE 1-1
 100-006-102-021
 BY K. COUBERT

DESCRIPTION:


SITUATED in the City of Vermilion, County of Lorain and State of Ohio. Being known as part of Original Brownhelm Township Lot 6, bounded and described as follows;

BEGINNING at a point in the centerline of Liberty Avenue being North 81°33' East a distance of 1705.90 feet from a P.K. nail found at its intersection with the west line of Original Lot 6, said point being also the northeast corner of lands conveyed to John C. and Sandra L. Herchler by deed recorded in O.R. Volume 669, Page 925 of Lorain County Records.

THENCE North 61°33' East along said centerline, a distance of 50.00 feet to a point. THENCE South 7°46' East, a distance of 350.00 feet to an iron pin set, said line passing through an iron pin set in the southerly right-of-way line of Liberty Avenue. THENCE South 81°33' West, a distance of 50.00 feet to an iron pin set. THENCE North 7°46' West along Herchler's easterly line, a distance of 350.00 feet to the place of beginning, embracing 0.402 acre of land, but being subject to all legal highways, as surveyed by M.G. Hura, August, 1997.

THE ABOVE described parcel of land is to become part of adjacent lands and is not intended to be a building lot.

PARCEL SPLIT APPROVAL
 PART OF ORIGINAL BROWNHELM TOWNSHIP LOT 6
 NOW CITY OF VERMILION, LORAIN CO., OHIO
 SCALE 1"=100 FT. AUGUST, 1997
 M.G. HURA REGISTERED SURVEYOR

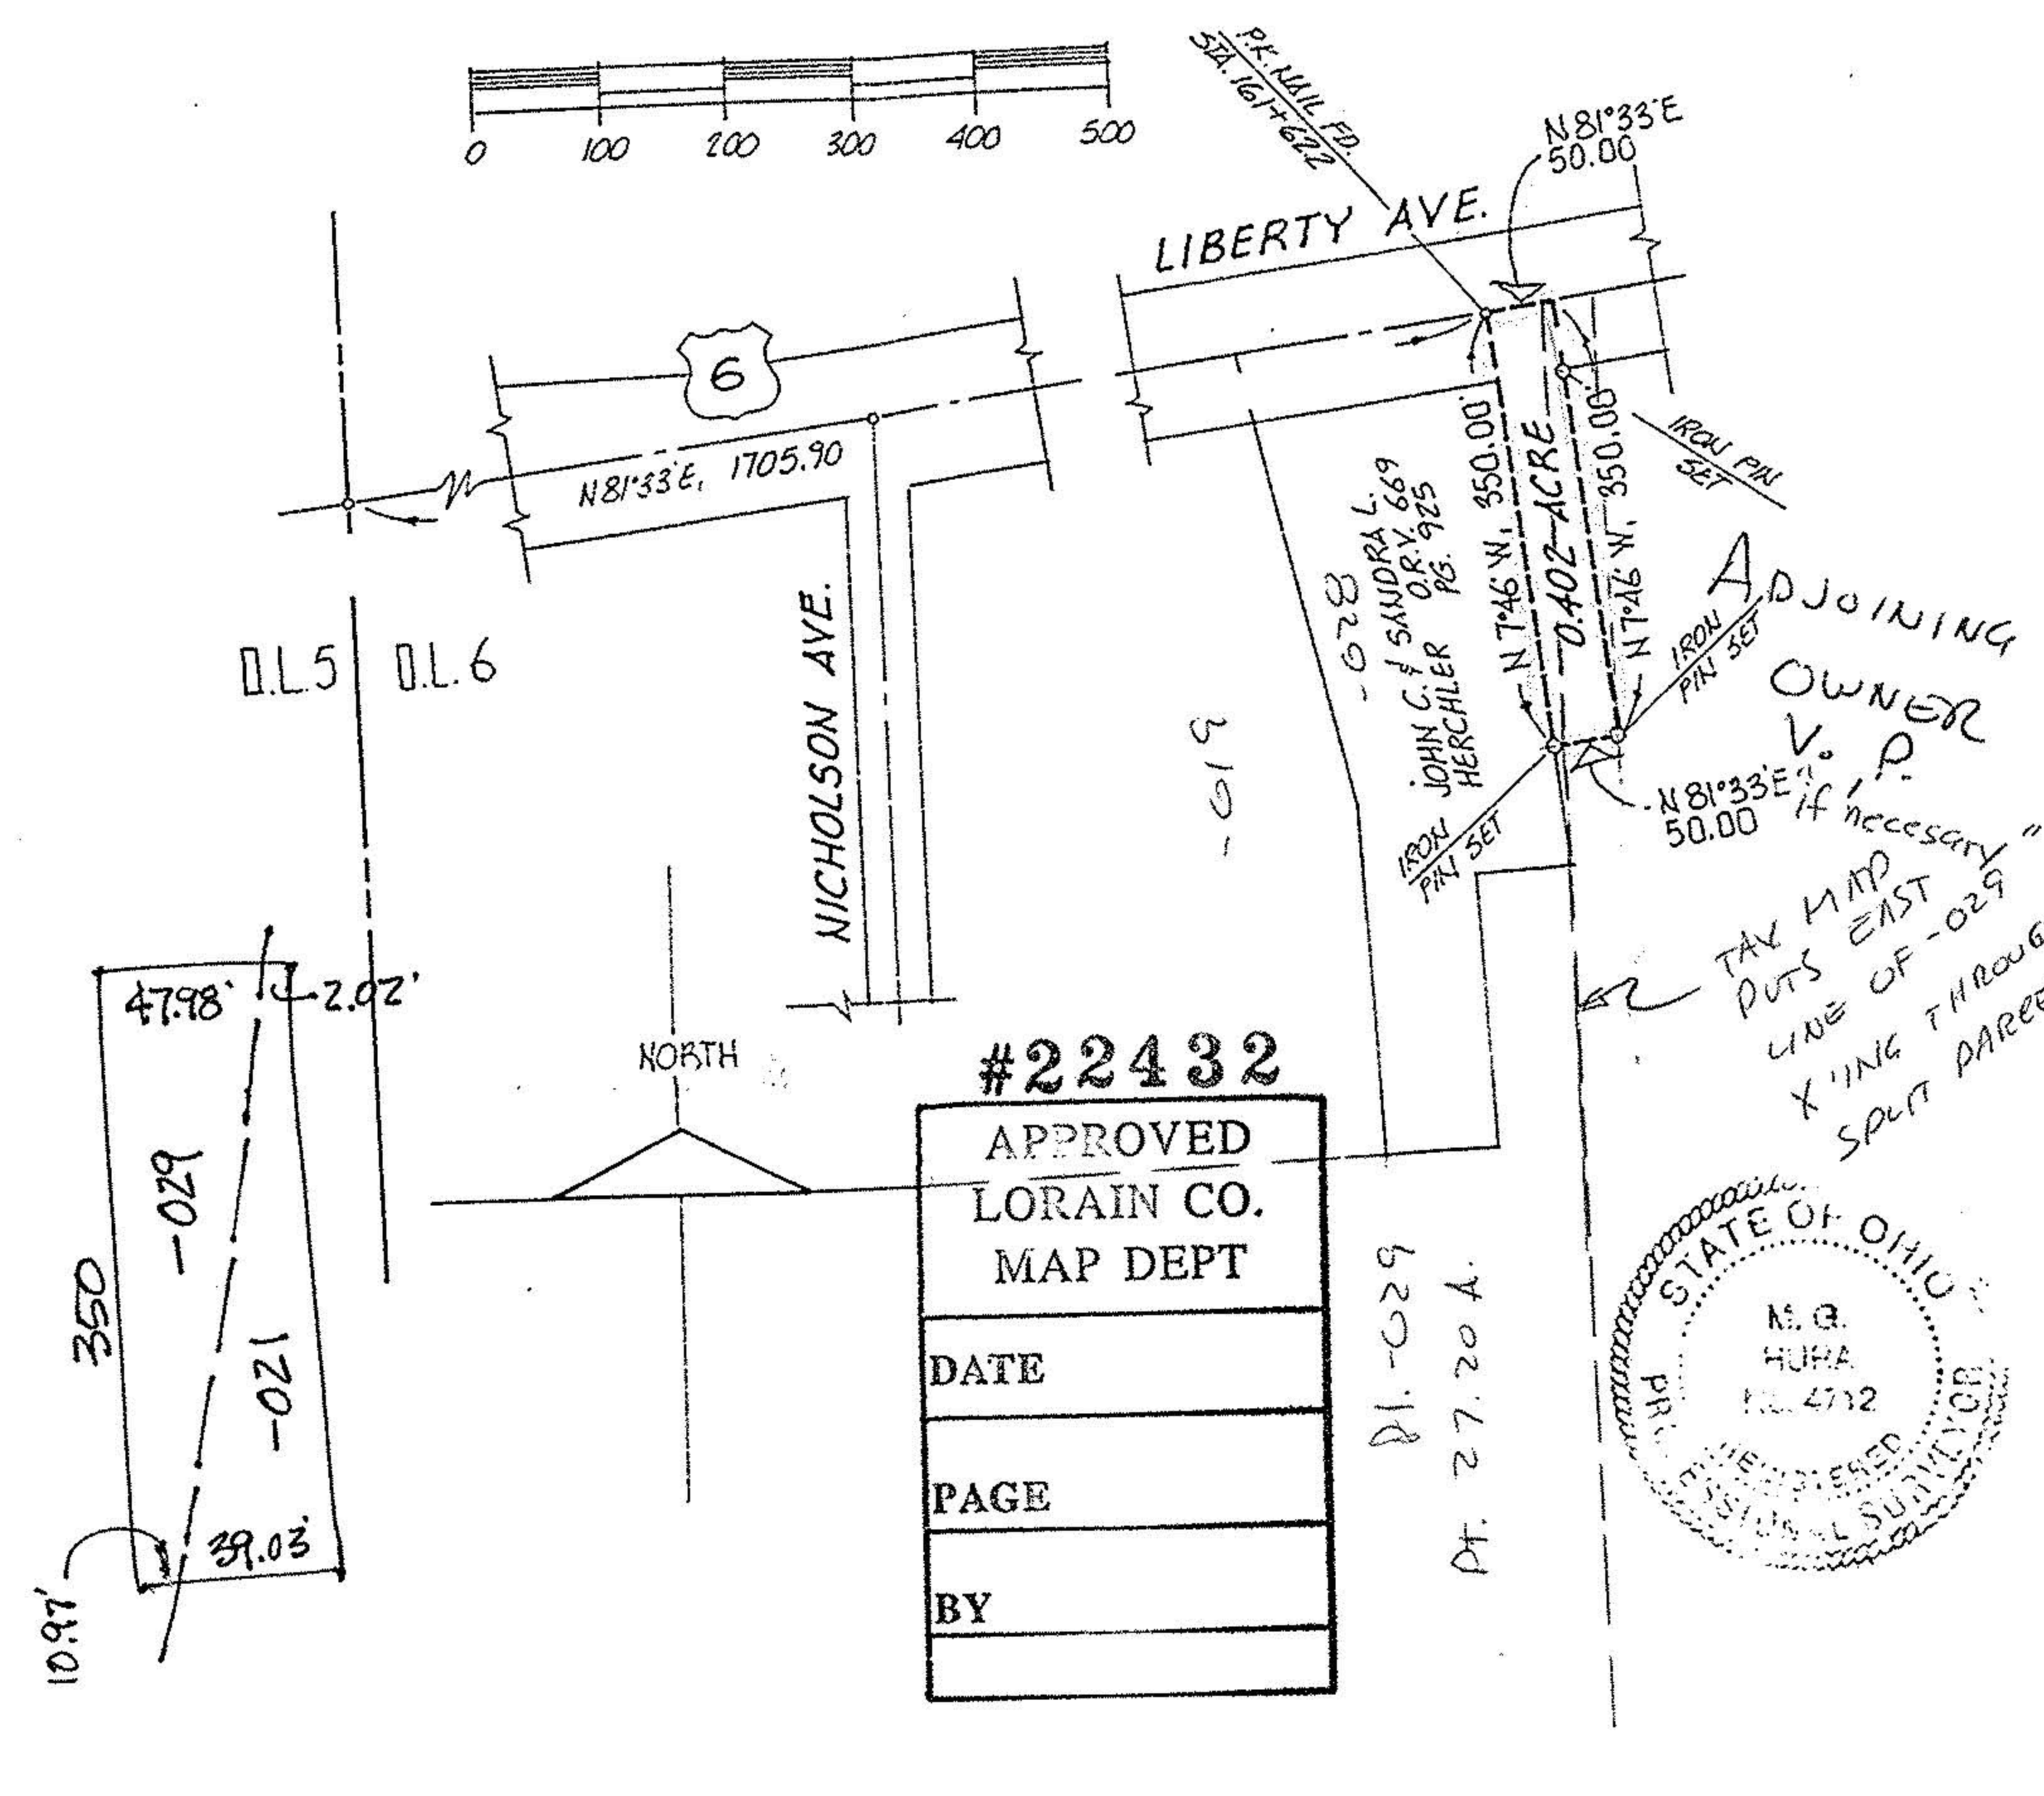

DESCRIPTION:

SITUATED in the City of Vermilion, County of Lorain and State of Ohio. Being known as part of Original Brownhelm Township Lot 6, bounded and described as follows;

BEGINNING at a point in the centerline of Liberty Avenue being North 81°33' East a distance of 1705.90 feet from a P.K. nail found at its intersection with the west line of Original Lot 6, said point being also the northeast corner of lands conveyed to John C. and Sandra L. Herchler by deed recorded in O.R. Volume 669, Page 925 of Lorain County Records.

THENCE North 81°33' East along said centerline, a distance of 50.00 feet to a point. THENCE South 7°46' East, a distance of 350.00 feet to an iron pin set, said line passing through an iron pin set in the southerly right-of-way line of Liberty Avenue. THENCE South 81°33' West, a distance of 50.00 feet to an iron pin set. THENCE North 7°46' West along Herchler's easterly line, a distance of 350.00 feet to the place of beginning, embracing 0.402 acre of land, but being subject to all legal highways, as surveyed by M.G. Hura, August, 1997.

THE ABOVE described parcel of land is to become part of adjacent lands and is not intended to be a building lot.

0.2368 ACRE OUT OF -029
 0.1652 ACRE OUT OF -021
 01-00-006-102-037,038,039

PARCEL SPLIT APPROVAL
 PART OF ORIGINAL BROWNHELM TOWNSHIP LOT 6
 NOW CITY OF VERMILION, LORAIN CO., OHIO
 SCALE 1"=100 FT. AUGUST, 1997
 M.G. HURA REGISTERED SURVEYOR