


LAKE ERIE

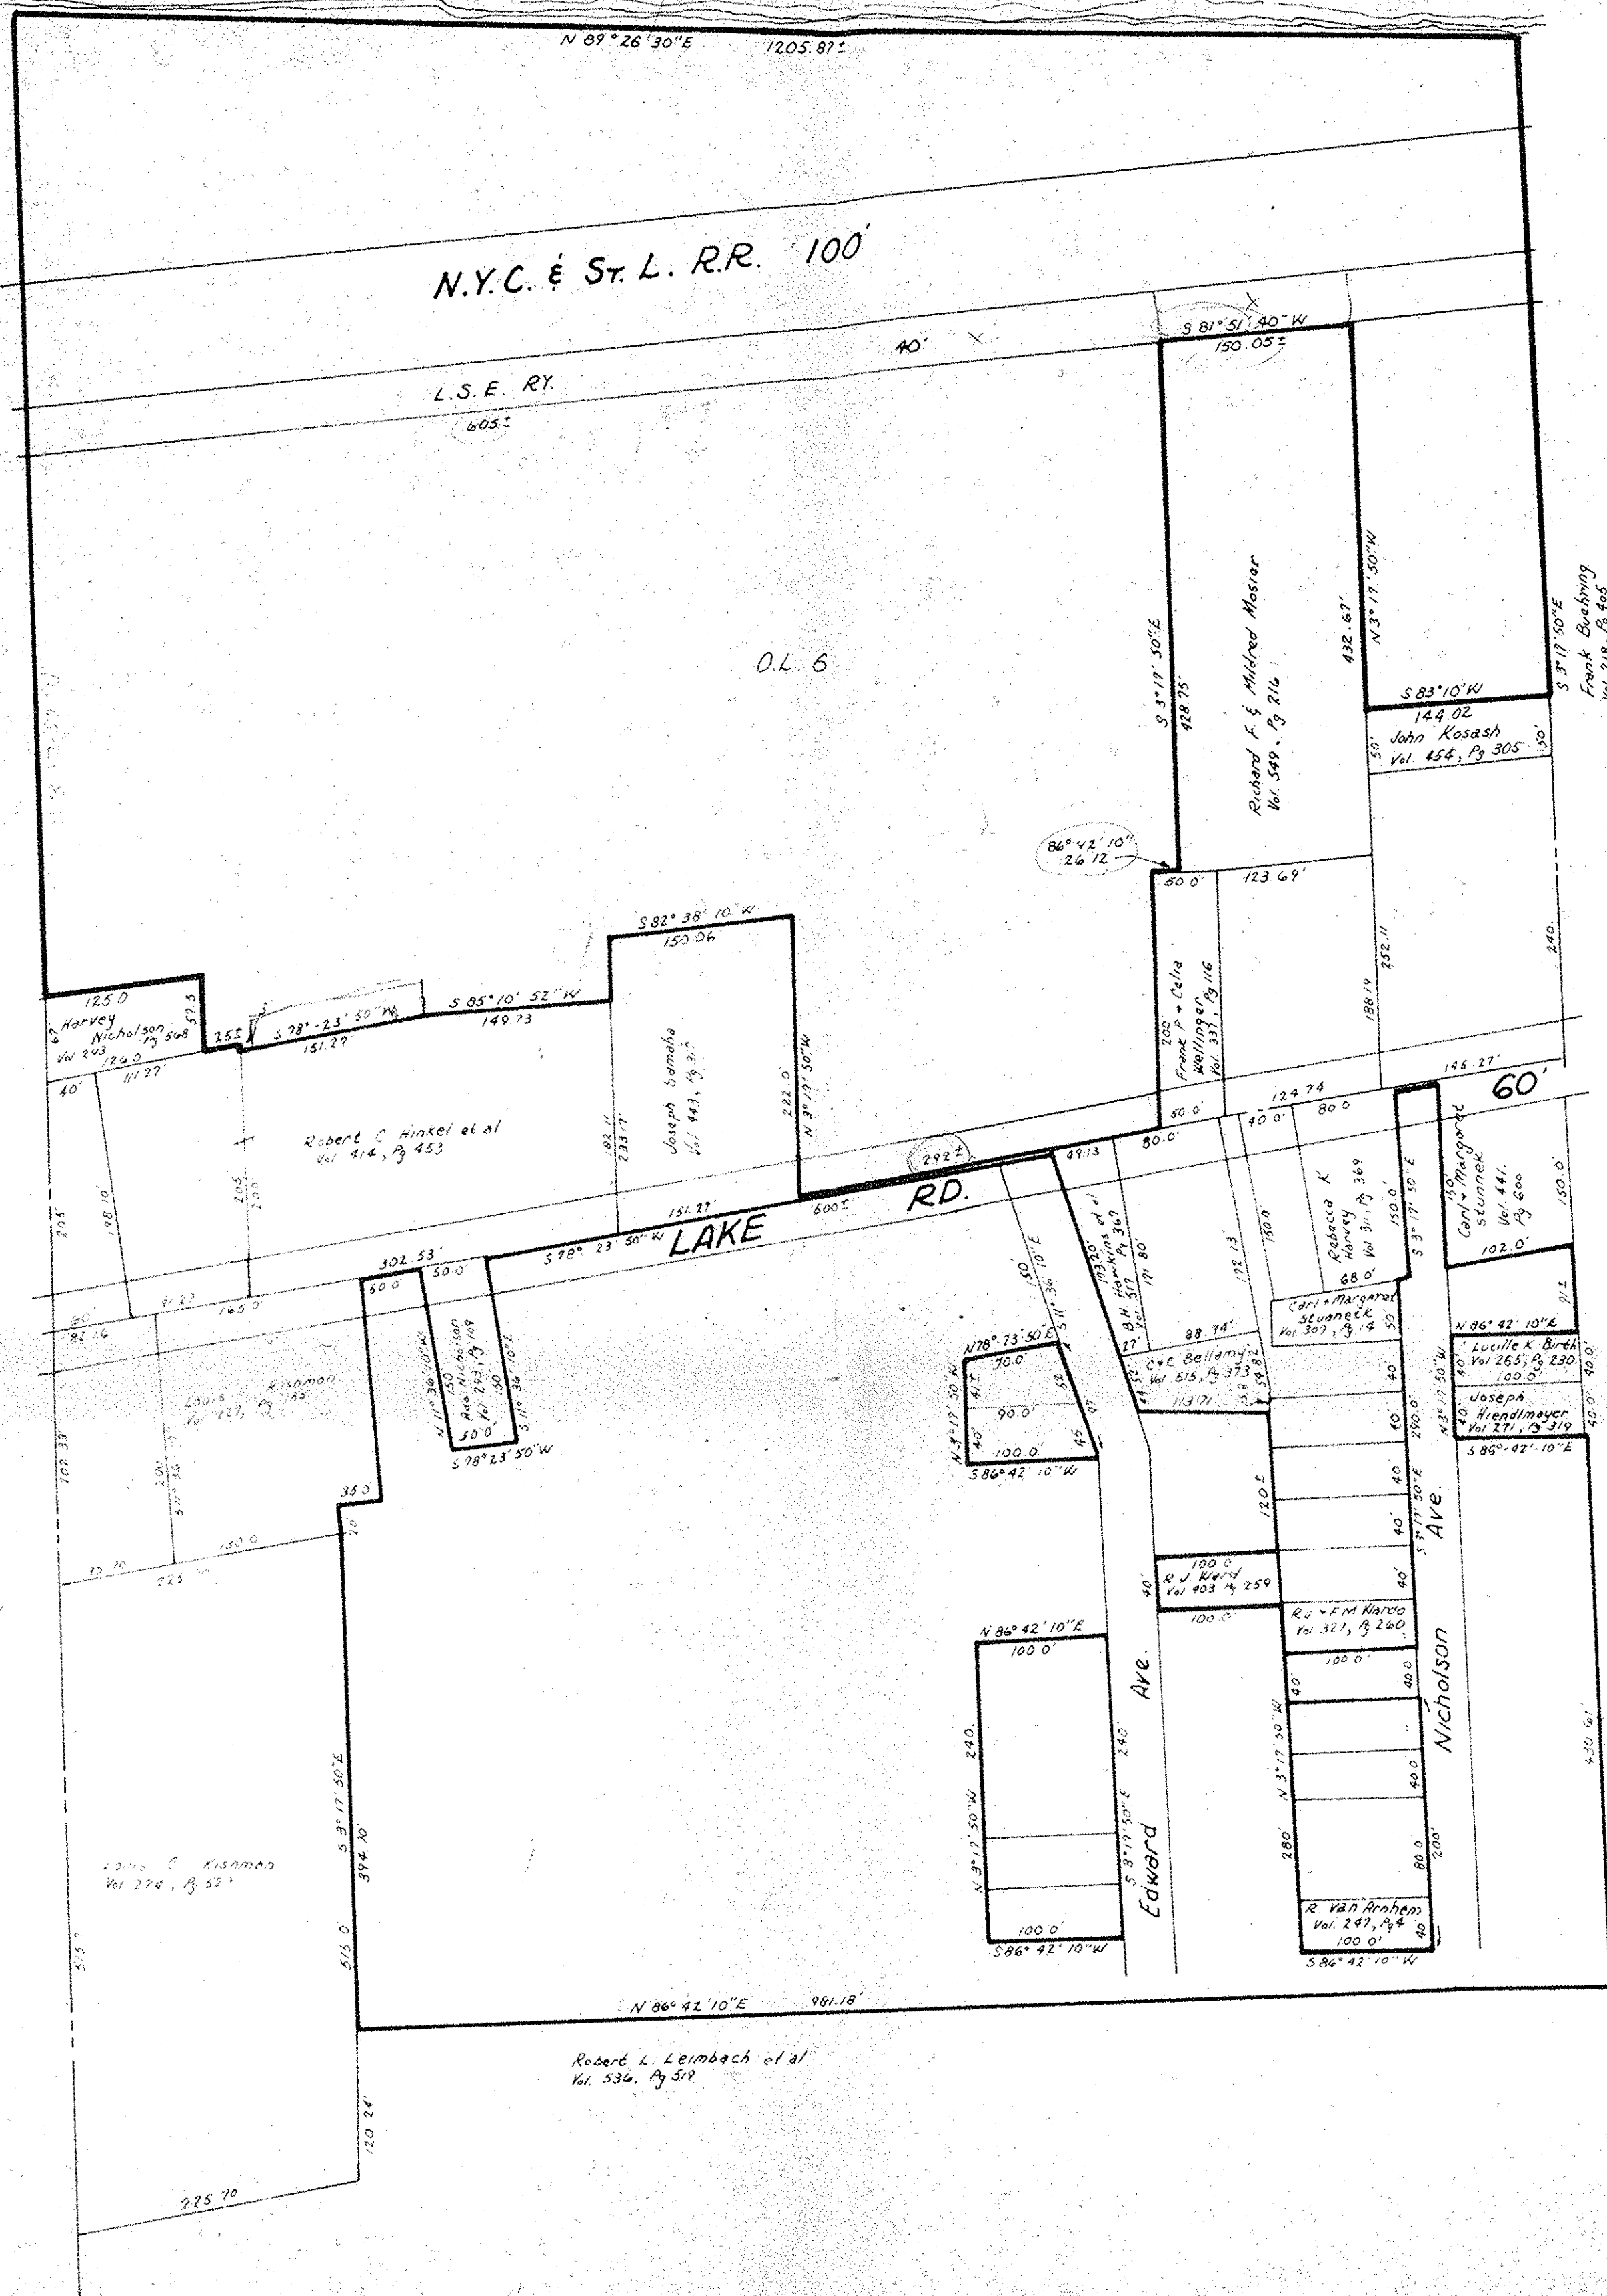

Mr. COLBERT  
 Mr. McNAUL  
 LOAN COUNTY TAX MAPS  
 Chattanooga,

Enclosed is a new copy of the letter to LOAN'S dual transcription  
 in Vermilion, bearing a newly stamped official seal and my  
 signature. Also, on the reverse side of the drawing,  

Thank you,  
 W.

01-00-000-101