


#00694

APPROVED
LORAIN CO.
MAP DEPT.

DATE 4/9/01

BY T. SPILLMAN

#01-00694

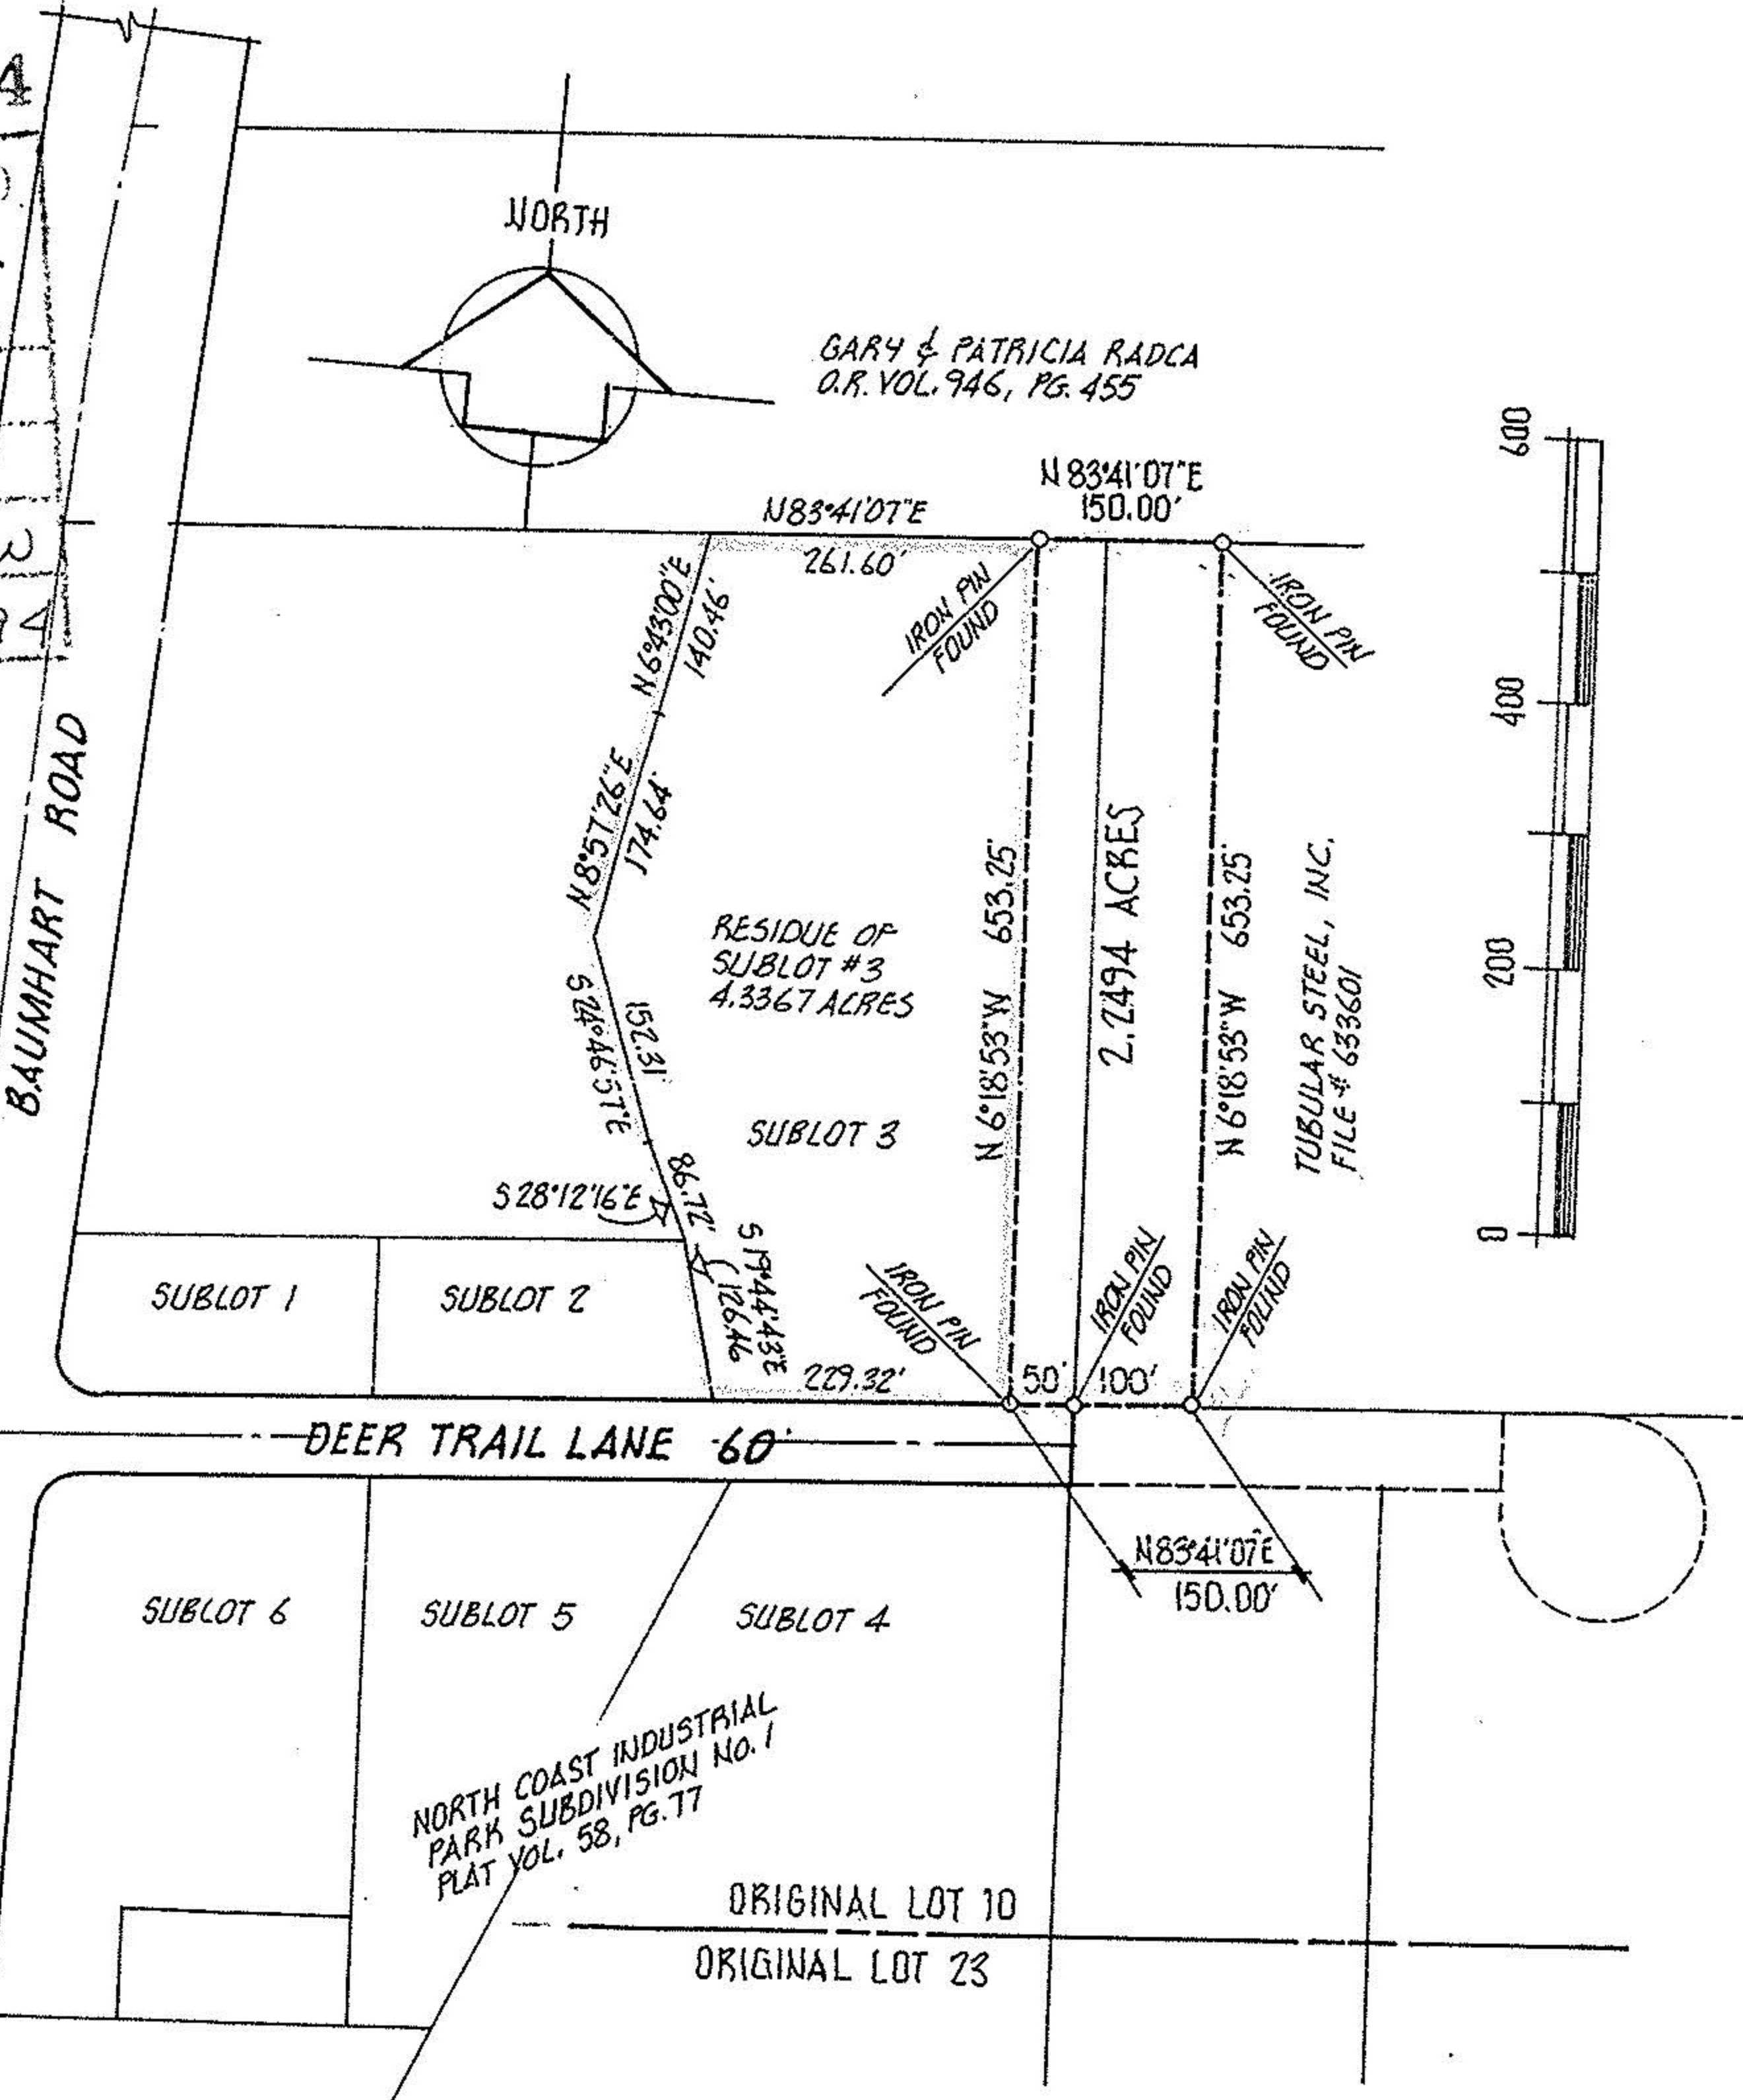

APPROVED

AS TO DESCRIPTION ONLY

Date March 13, 2001
City of Lorain
Per Lumberly Host
Engineering Dept.

APPROVED BY THE LORAIN CITY PLANNING COMMISSION..... NO PLAT REQUIRED

William E. Doherty 3-13-01
SECRETARY LORAIN CITY PLANNING COMMISSION

acreage <u>2.2494</u>	prepared for <u>CASSELL REALTY</u>
date <u>FEB-2001</u>	
drawn <u>MGH</u>	
scale <u>1"=200</u>	
	MICHAEL G. HURA, REGISTERED SURVEYOR 12706 Mason Road, Vermilion Ohio (216)965-4040
	PERIMETER SURVEY
	PART OF SUBLOT <u>#3</u> OF <u>NORTH COAST</u> <u>INDUST. PARK SUBDN #1</u> Volume <u>58</u> Page <u>77</u> of PLATS
	PART of O.L. <u>10</u> Tract _____ Section _____ of <u>BROWNHELM</u> TOWNSHIP <u>LORAIN</u> CO., OHIO
	City of LORAIN Village of