PRELIMINARY

VERMILION ACRES LIMITED PARTNERSHIP

SITUATED IN THE CITY OF VERMILION, COUNTY OF LORAIN, & STATE OF OHIO & KNOWN AS BEING PART OF BROWNHELM TOWNSHIP ORIGINAL LOT 16.

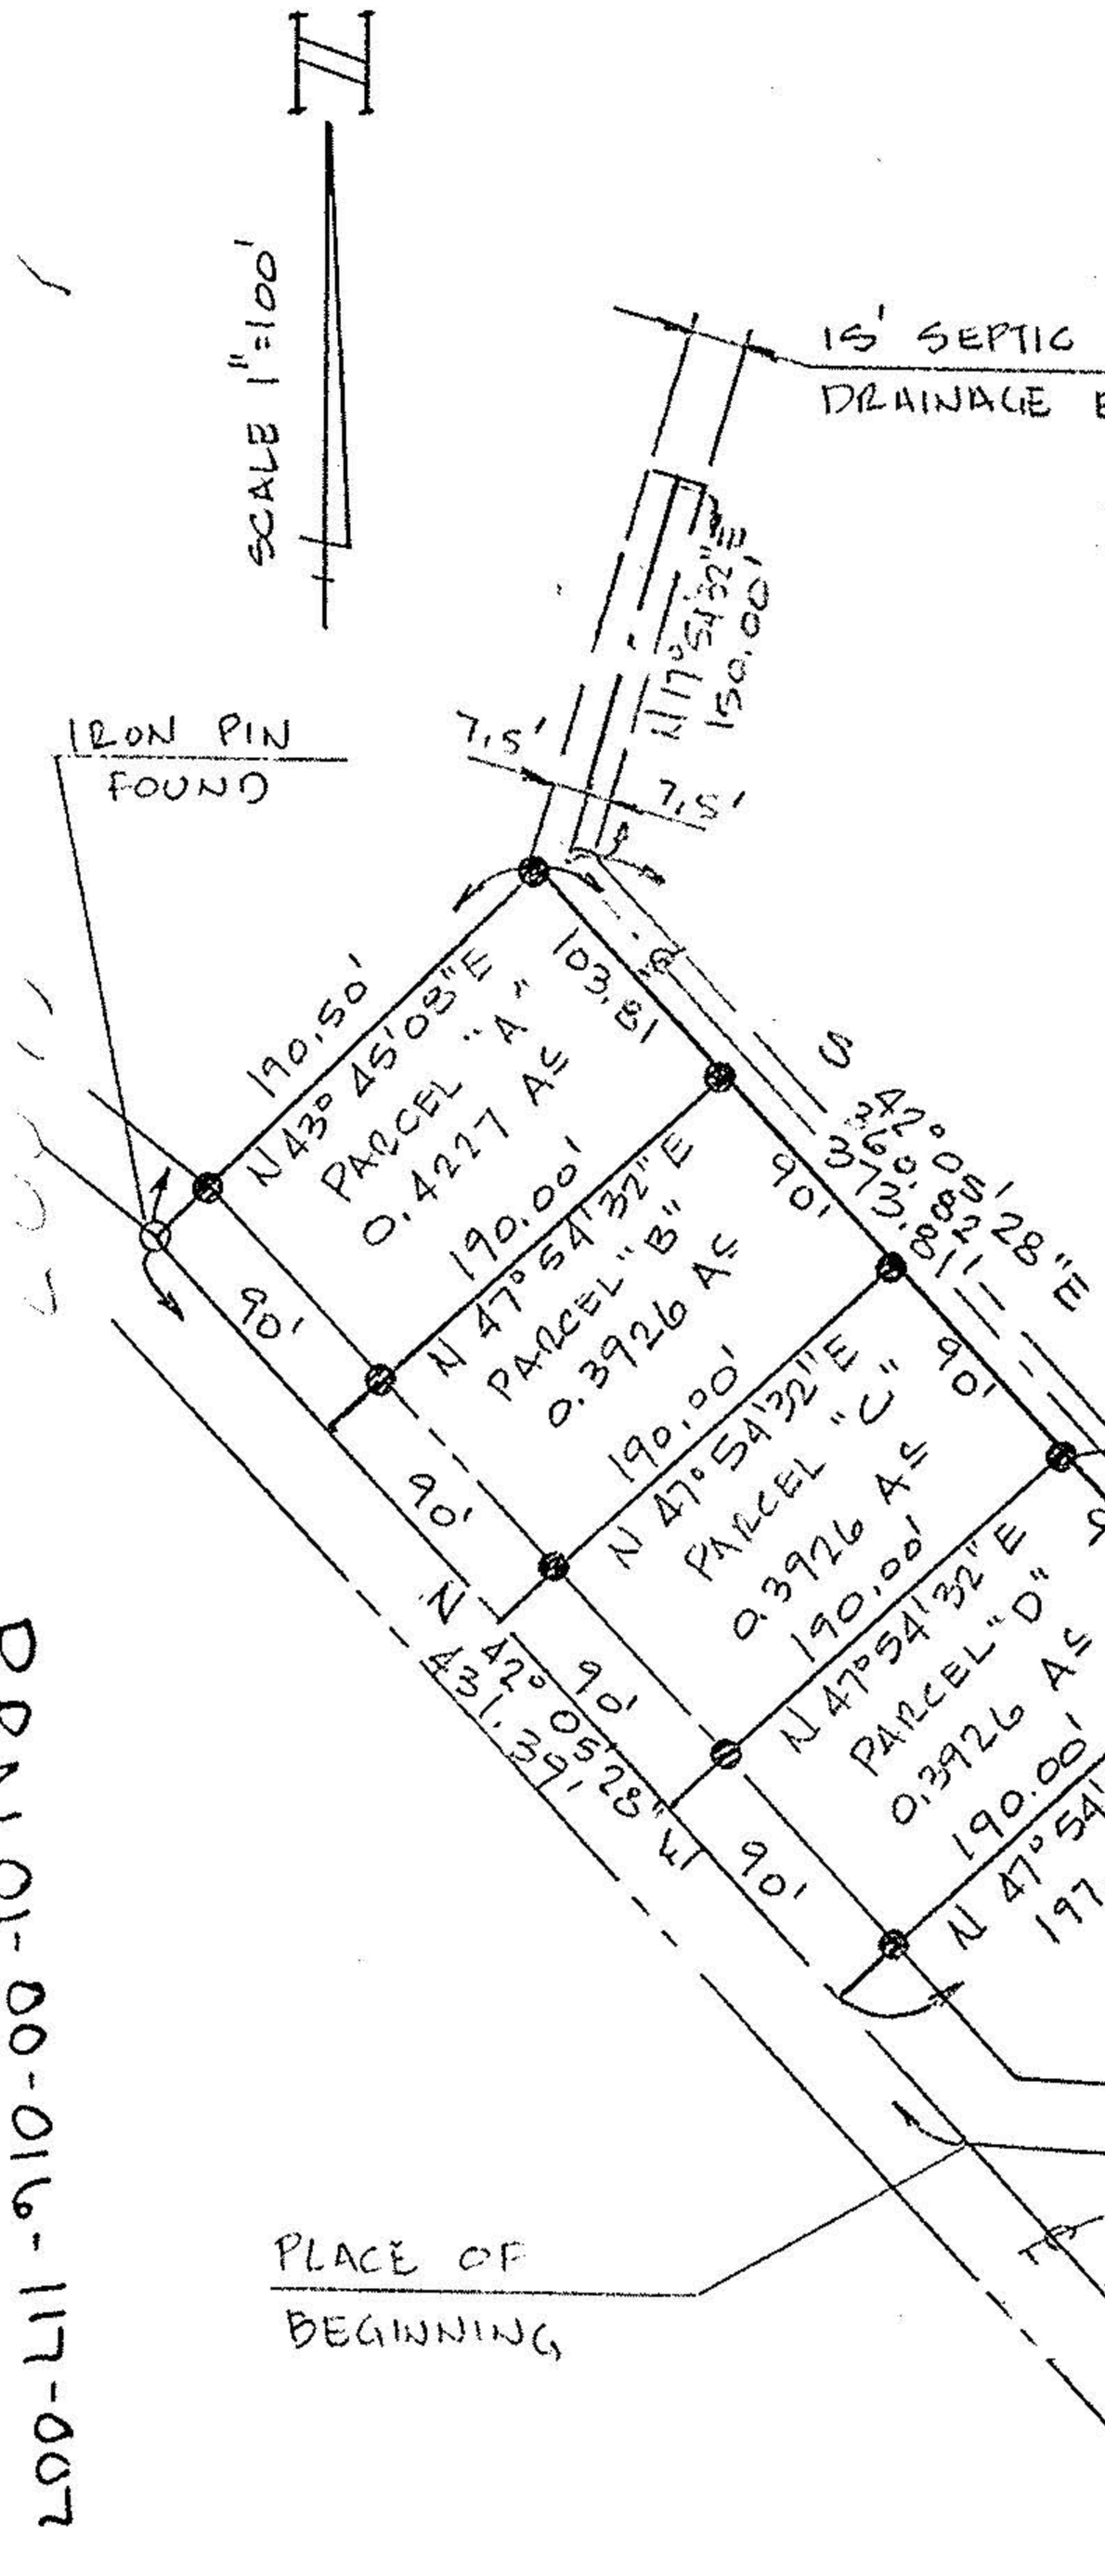

DISTANCES ARE GIVEN IN FEET & DECIMAL PARTS THEREOF. BEARINGS ARE GIVEN TO AN ASSUMED MERIDIAN FOR THE PURPOSE OF DESCRIBING ANGLES ONLY. IRON PINS WERE SET OR FOUND, AS INDICATED, ALL OF WHICH I CERTIFY TO BE CORRECT TO THE BEST OF MY PROFESSIONAL KNOWLEDGE, INFORMATION & BELIEF.

Richard Rosebeck 7/19/92

RICHARD ROSEBECK #7400 DATE

STATE OF OHIO
RICHARD A. ROSEBECK 7400 REGISTERED
PROFESSIONAL SURVEYOR

1-00-016-107.002

1-00-016-610-002

#20079