

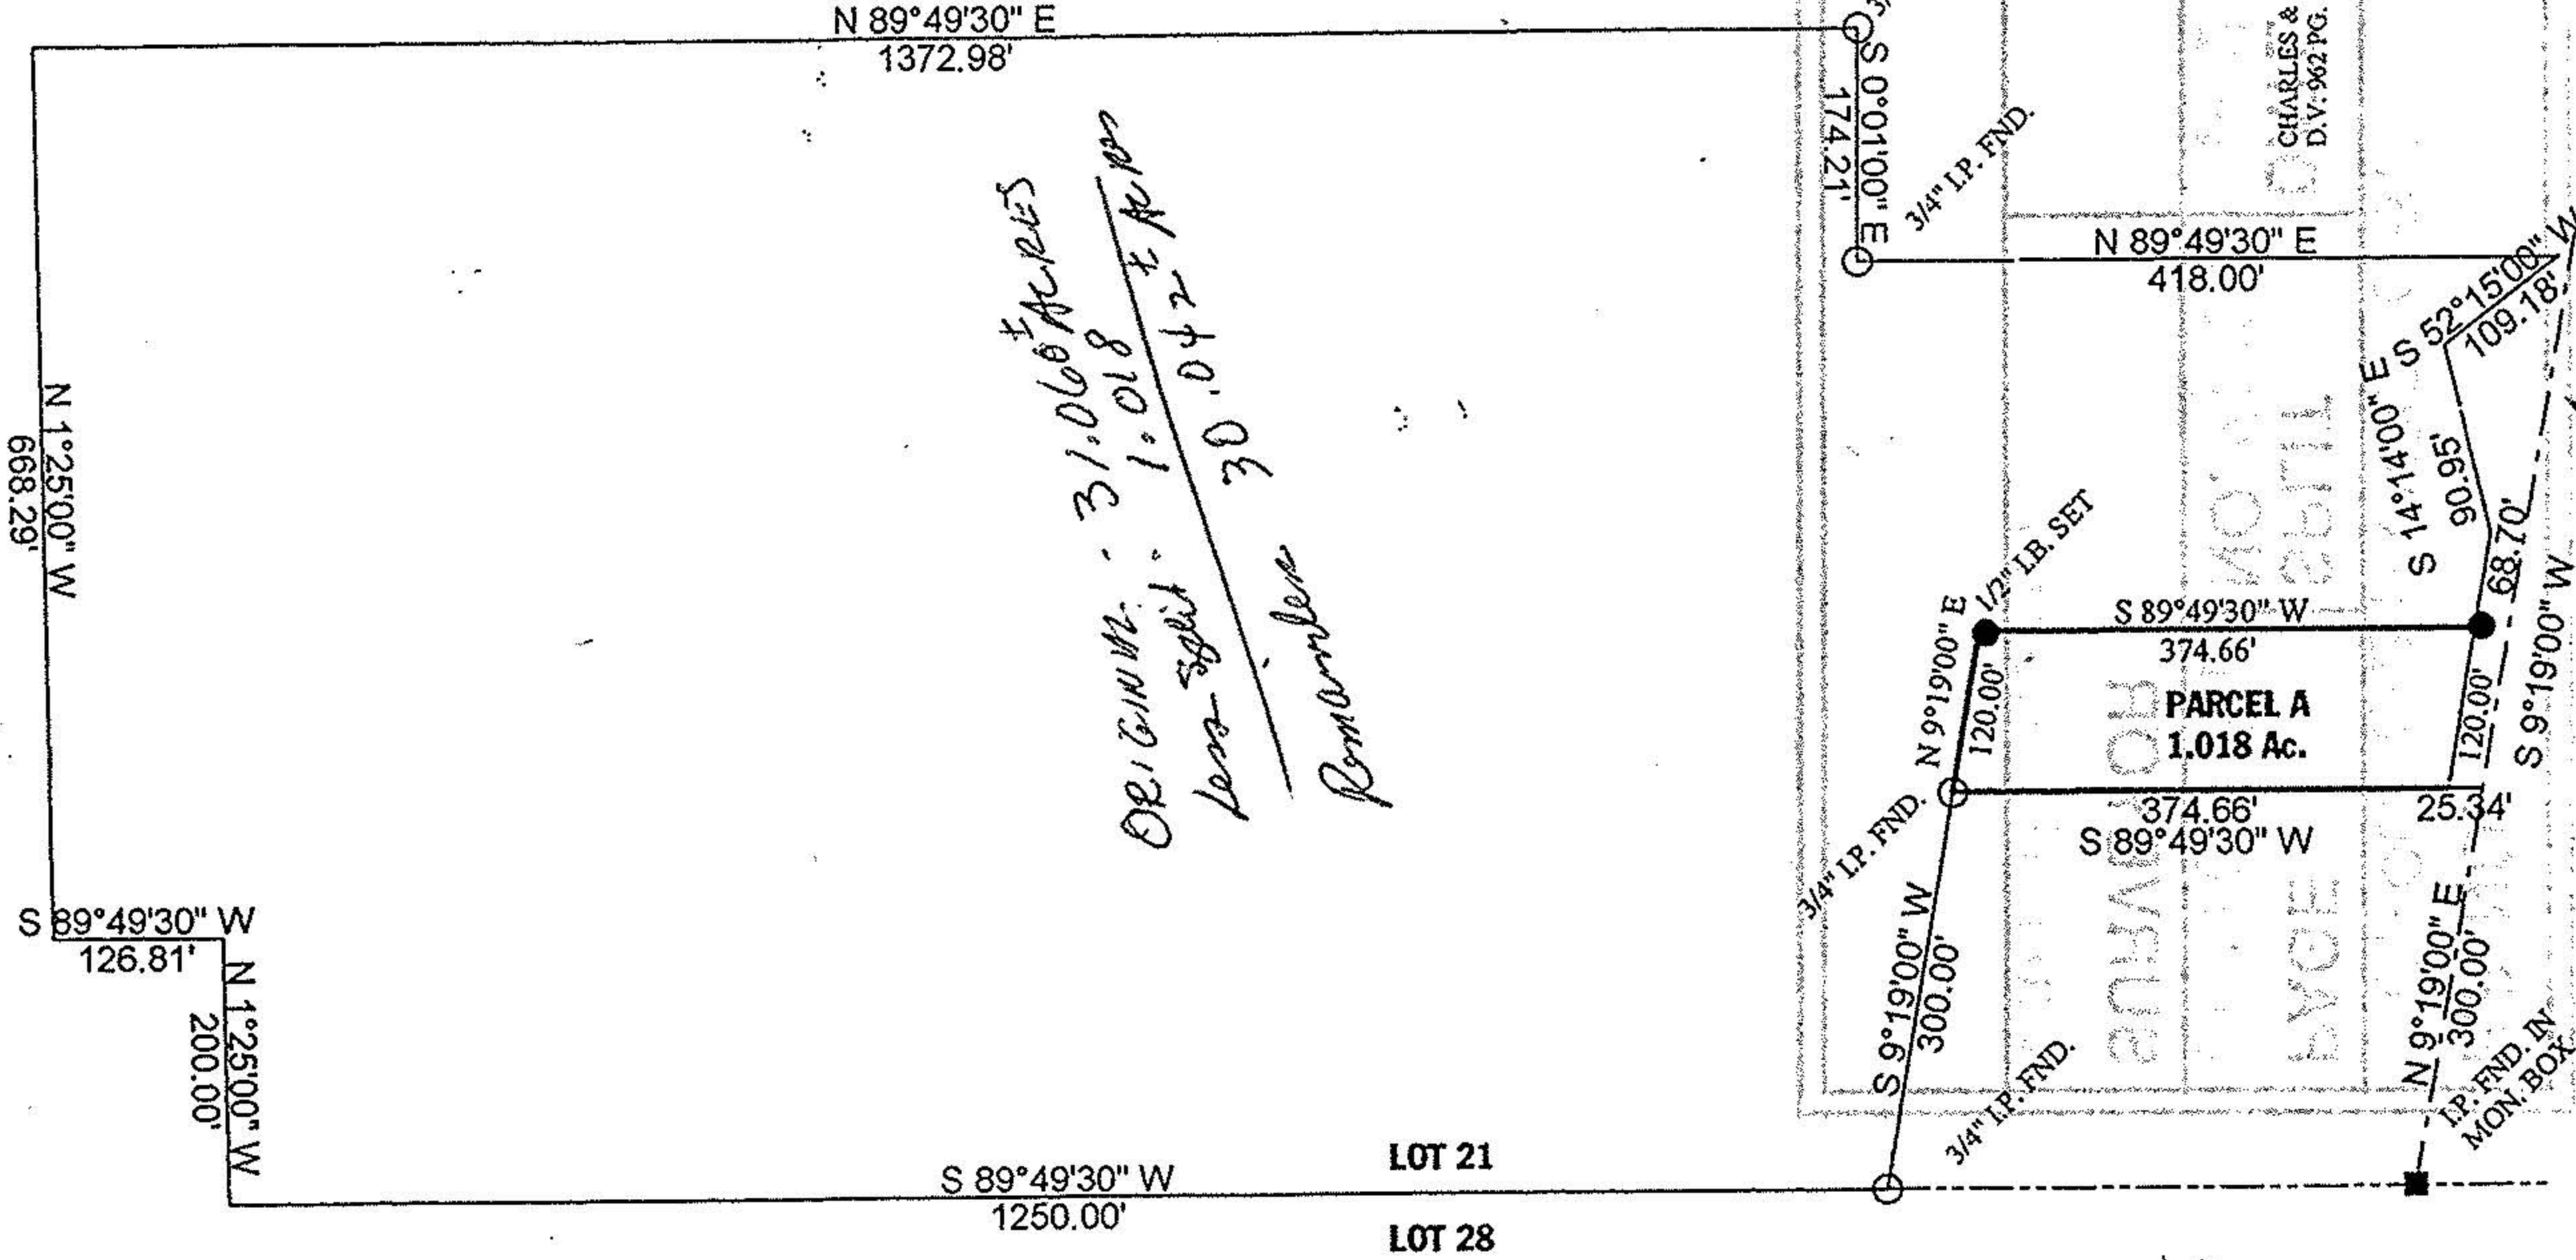
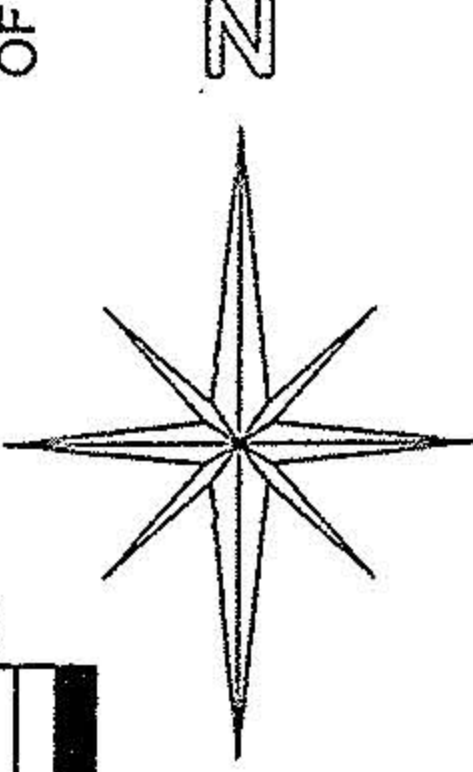


P.P.N. 01-00-021-000-053

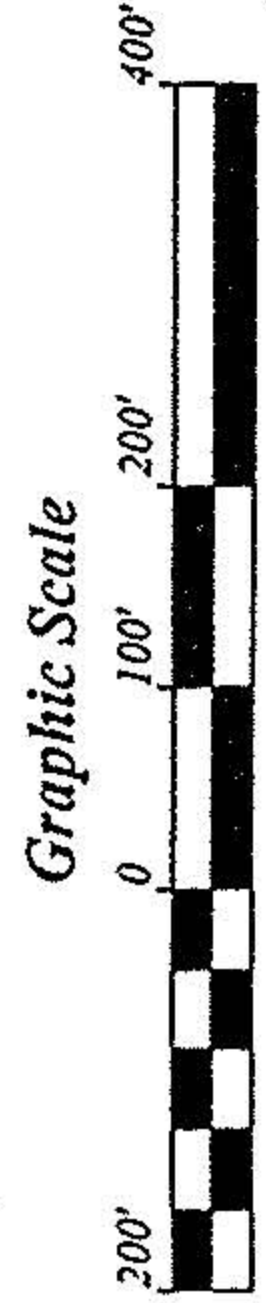

21927
APPROVED
LORAIN CO.
MAP DEPT.
DATE 9-30-96
PAGE 1-00-021-A&B
BY K.DYE
VOID AFTER # 121927

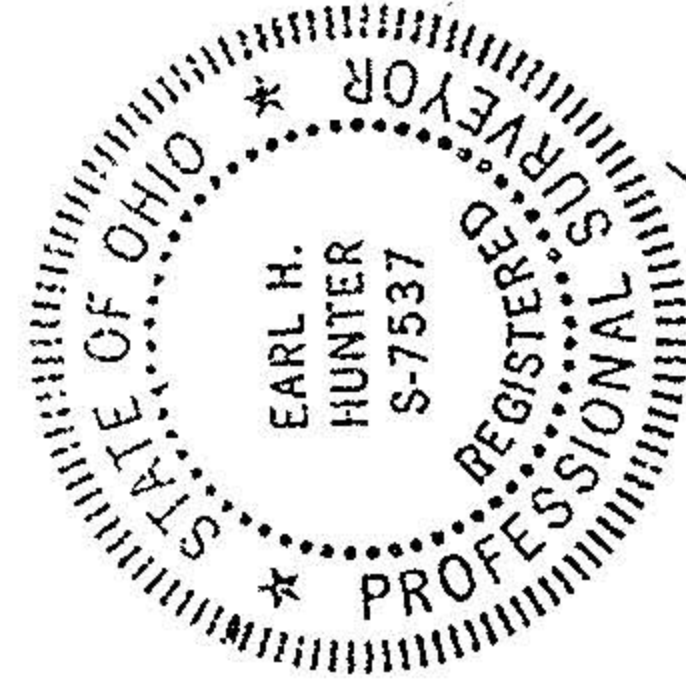

PREPARED BY: EARL H. HUNTER, P.S.  
1503 SANFORD STREET  
VERMILION, OHIO 44089  
(216) 967-2037