


JERUSALEM

01-00-028-900-001 4.32 A

RD.

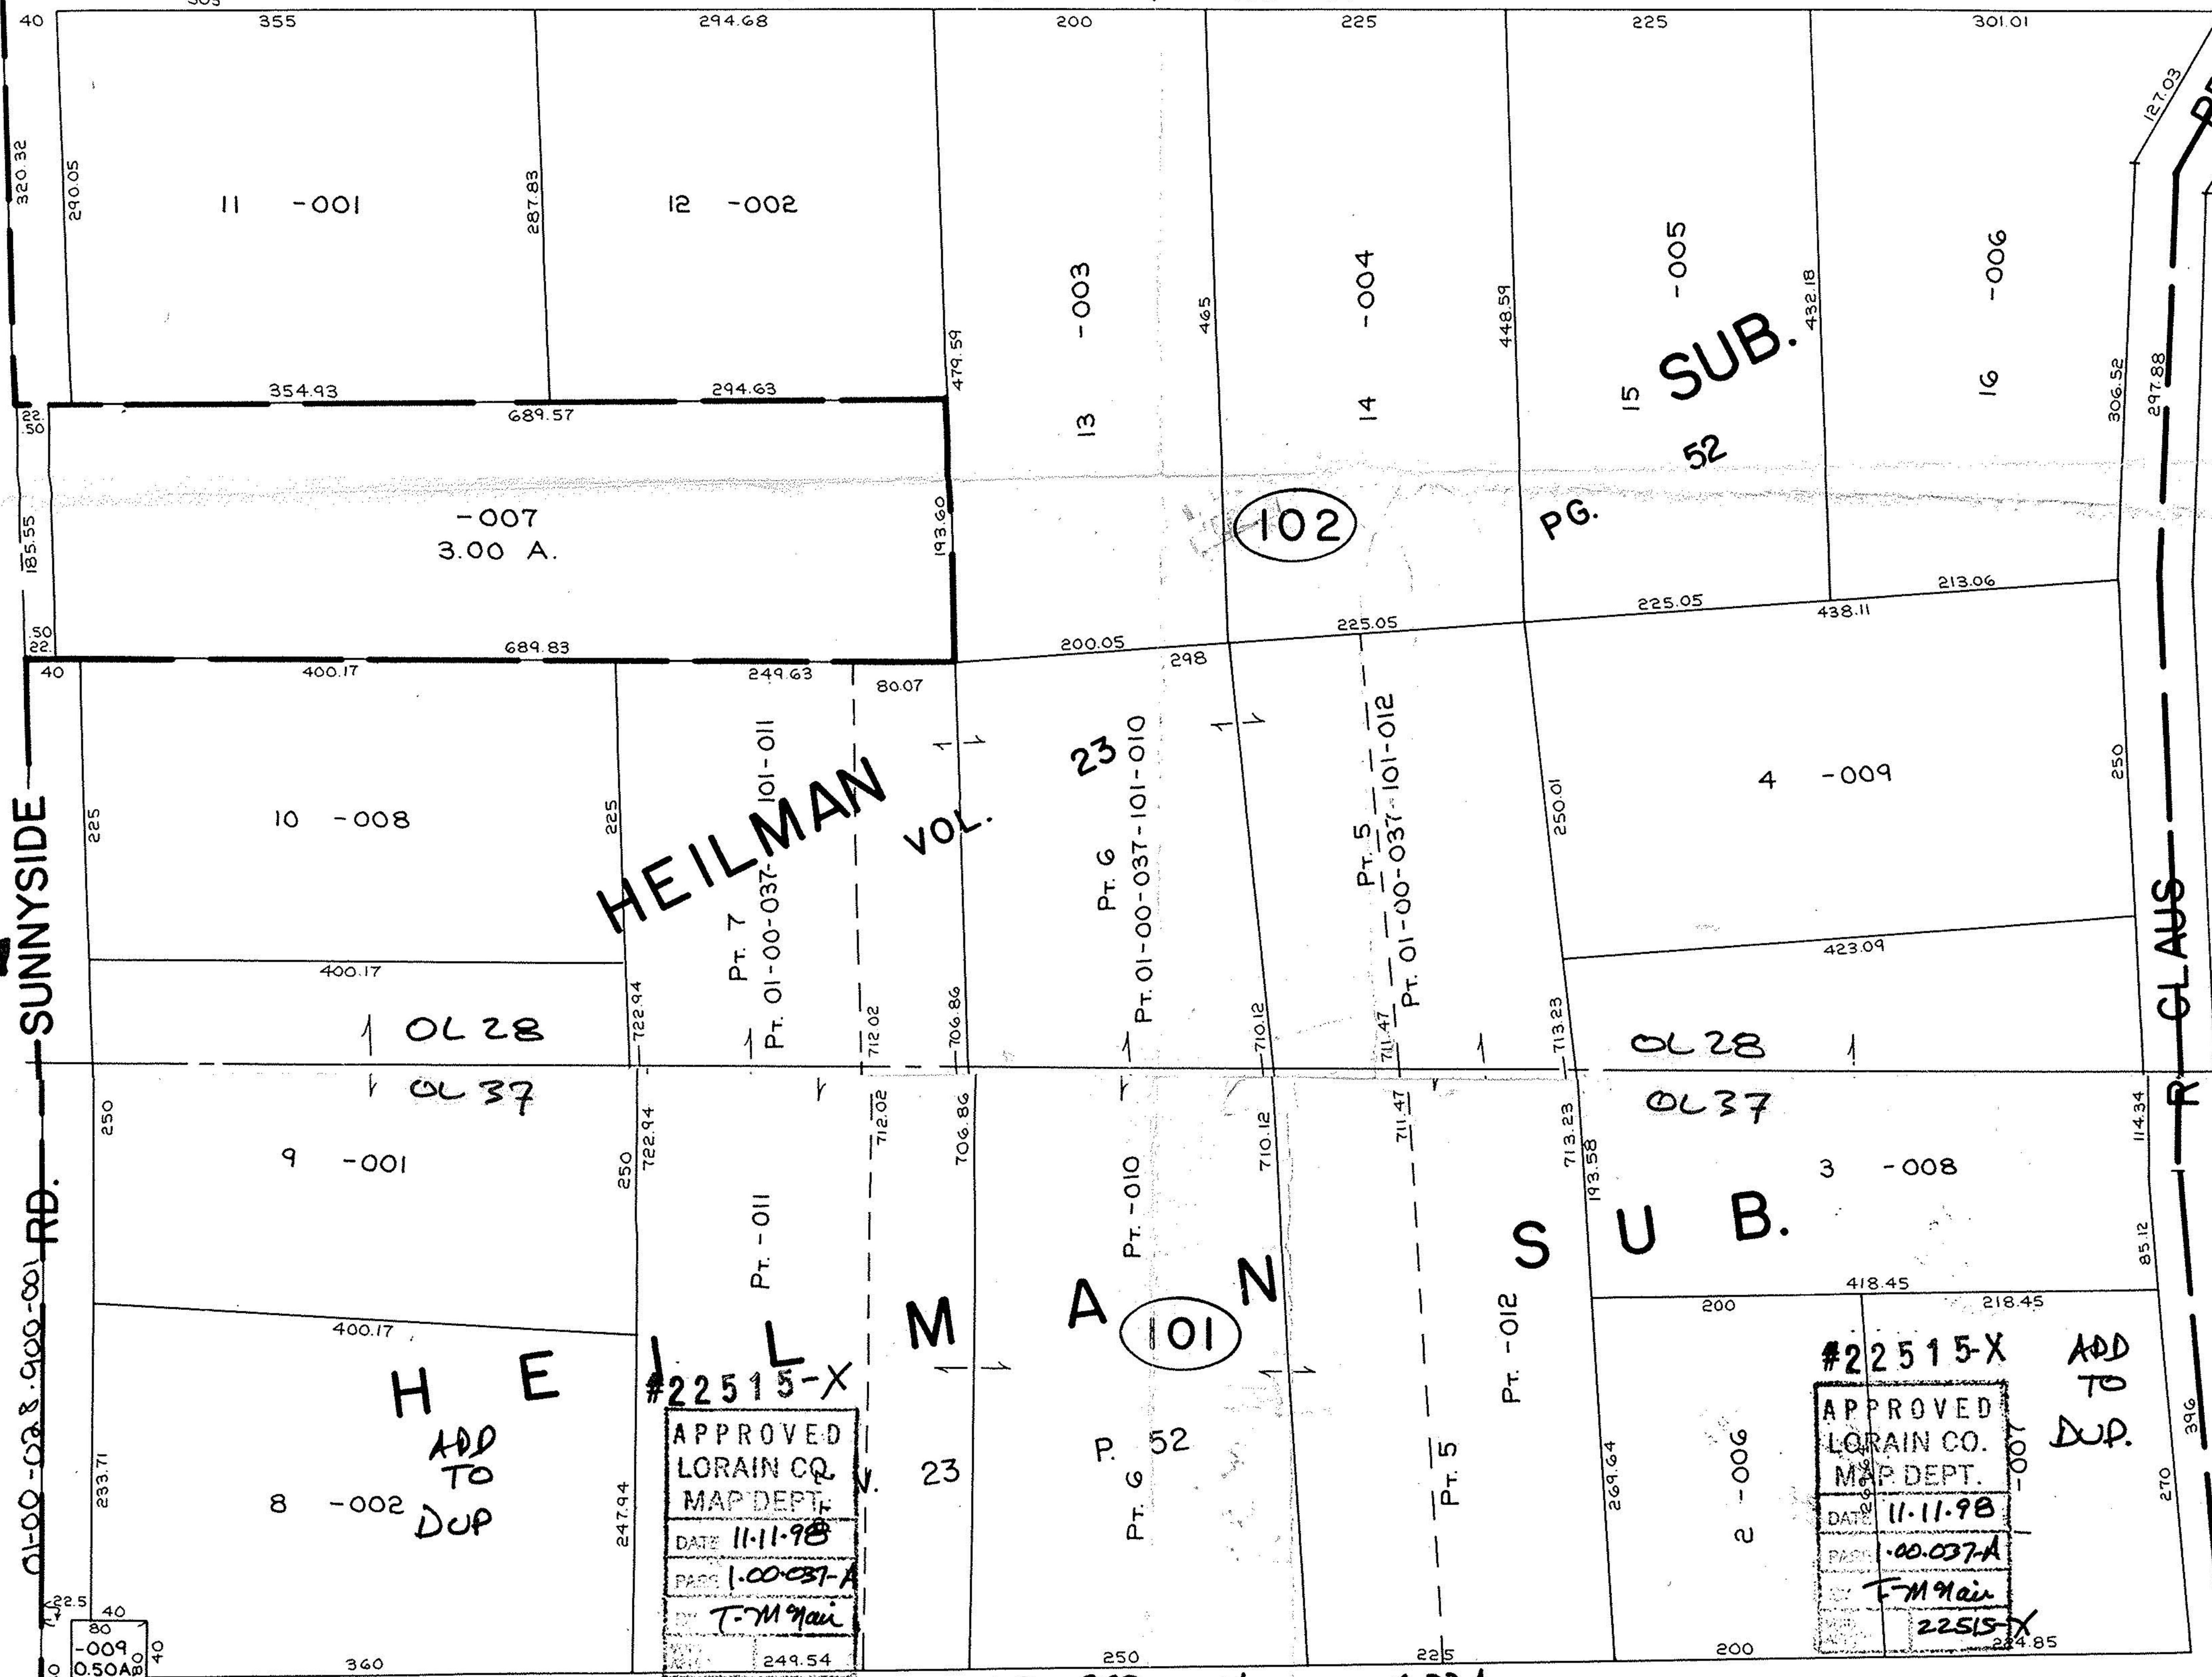

SUNNYSIDE

RD.

GLAUS

RD.

COOPER FOSTER PARK

01-00-028-900-001 4.32 A

RD.

1-00-037-A

SEE 1-00-037-B

-034