

ACREAGE Misc.
DATE 03-05-91
DRAWN MGH
SCALE 1" = 200 ft.


PREPARED FOR SHARON D. JENKINS
2218 BROWNWALKER ST. RD.
%67-7123

MICHAEL G. HURA, registered surveyor
12706 MASON RD., VERMILION, O., Ph.(216) 965 4040

PARCEL SPLIT APPROVAL

SUBLOT(s) _____ of _____ Volume _____ Page _____ of PLATS
PART OF O.L. 29 TRACT SECTION _____ OF
PERMANENT PARCEL NO. _____

CITY OF VERMILION

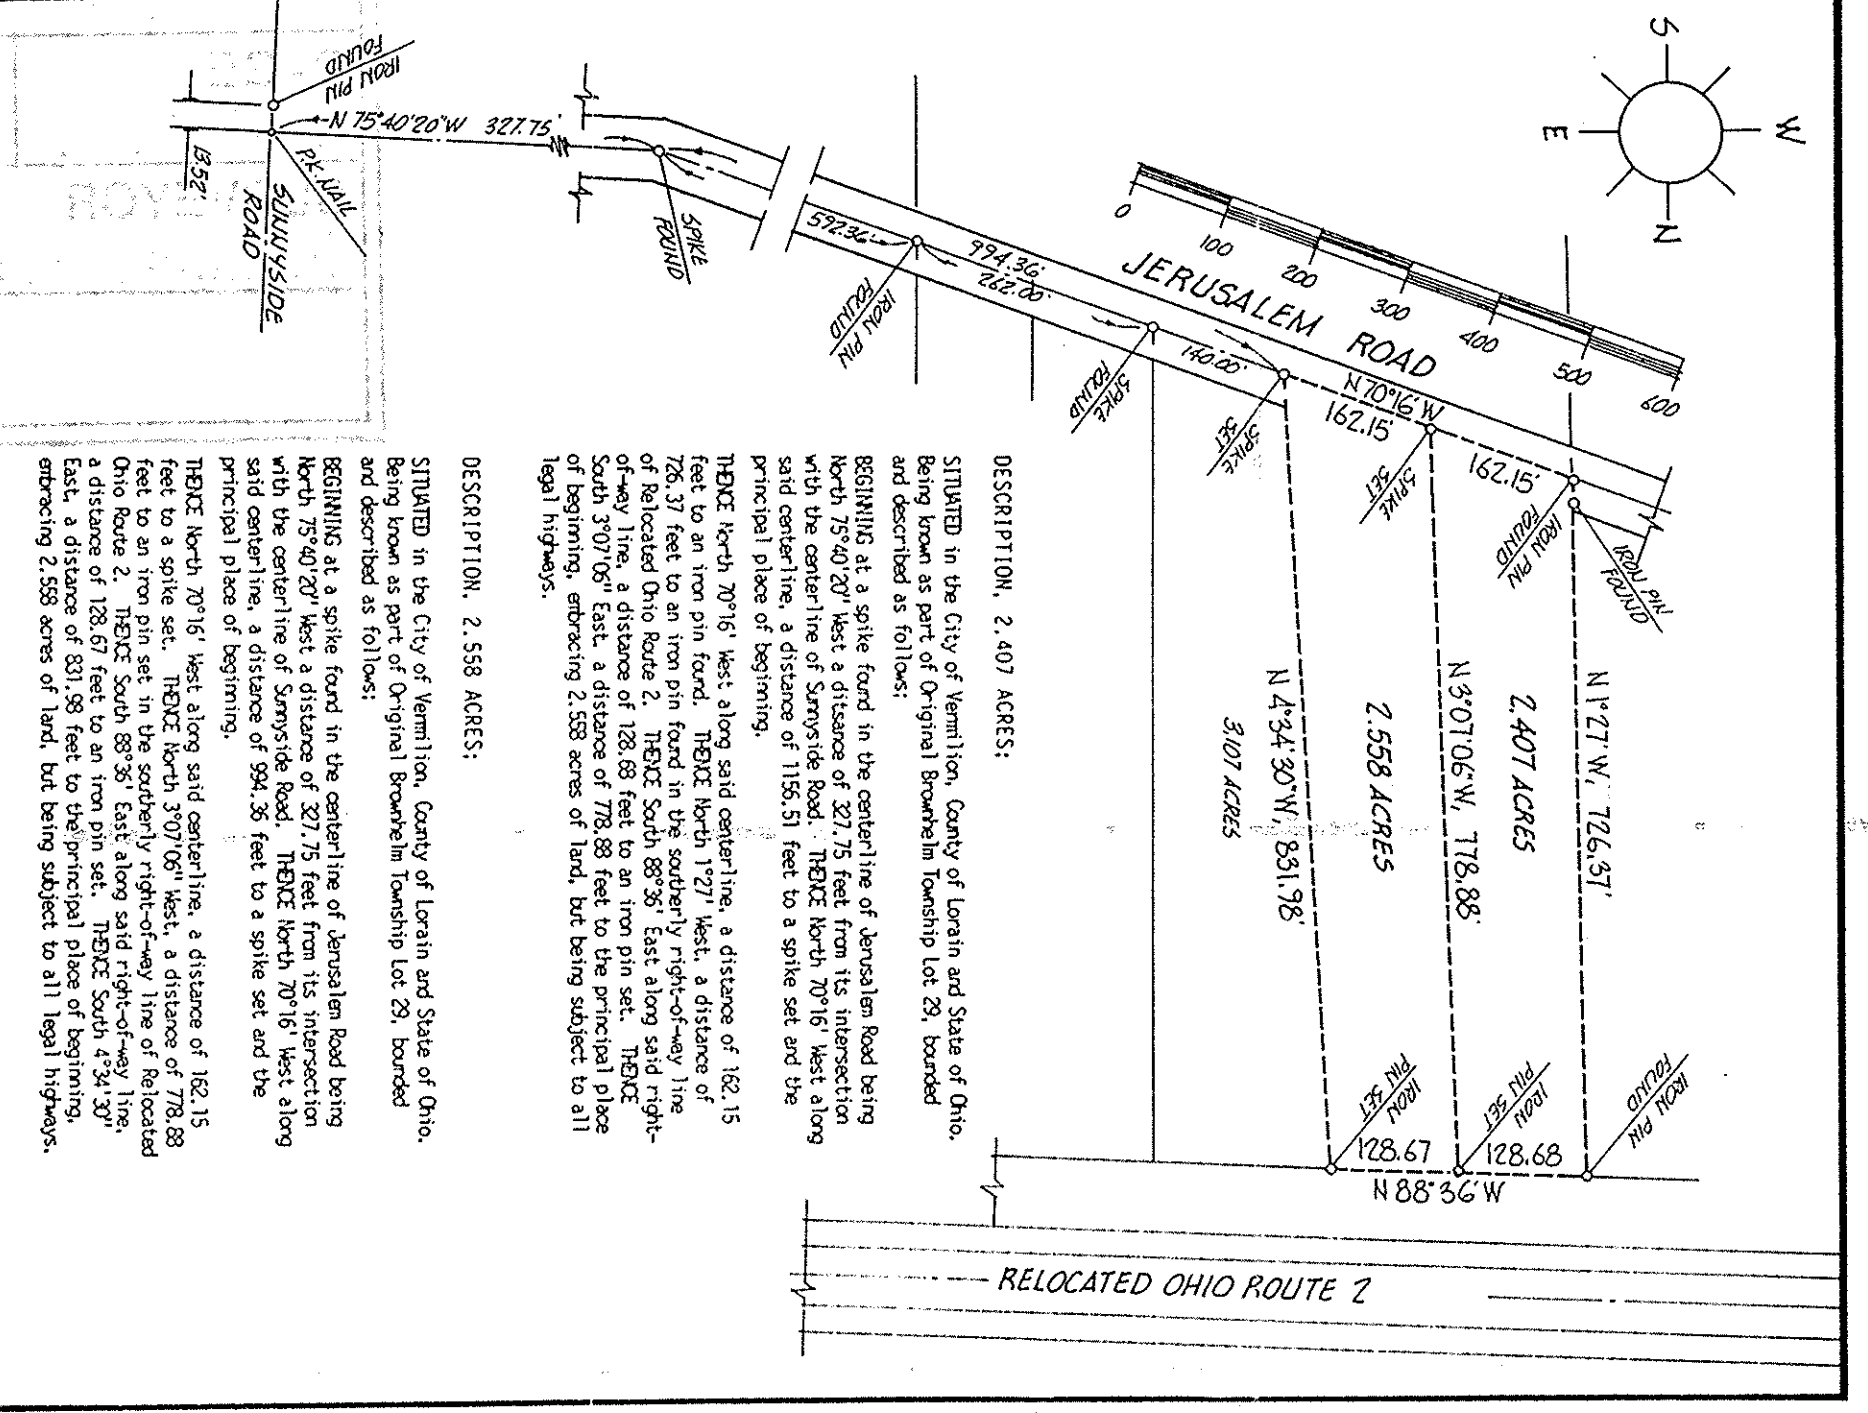

ACREAGE Misc.
DATE JULY-93
DRAWN MGH
SCALE 1" = 200 ft.

PREPARED FOR J.O. & BECKY CULP-BEPPER
%67-7455

MICHAEL G. HURA registered surveyor
12706 MASON ROAD, VERMILION, OHIO (216) 965-4040

PERIMETER SURVEY

SUBLOT _____ of _____ Volume _____ Page _____ of PLATS
PART OF O.L. 29 TRACT SECTION _____ OF
Perm. Parcel No. _____ Rel. deed: _____

CITY OF VERMILION

NOTE FROM 965-4040

THIS GUY SAYS SURETORS CHANGE TOO MUCH MONEY AND HE DONT GONNA PAY THE BILL. IF THIS COXES INTO YOU FOR TRANSFER AND YOU WANT TO TRANSFER THIS NOTE, GIVE ME A CALL.

01-00-029-000-031
01-00-029-B
MIKE

















