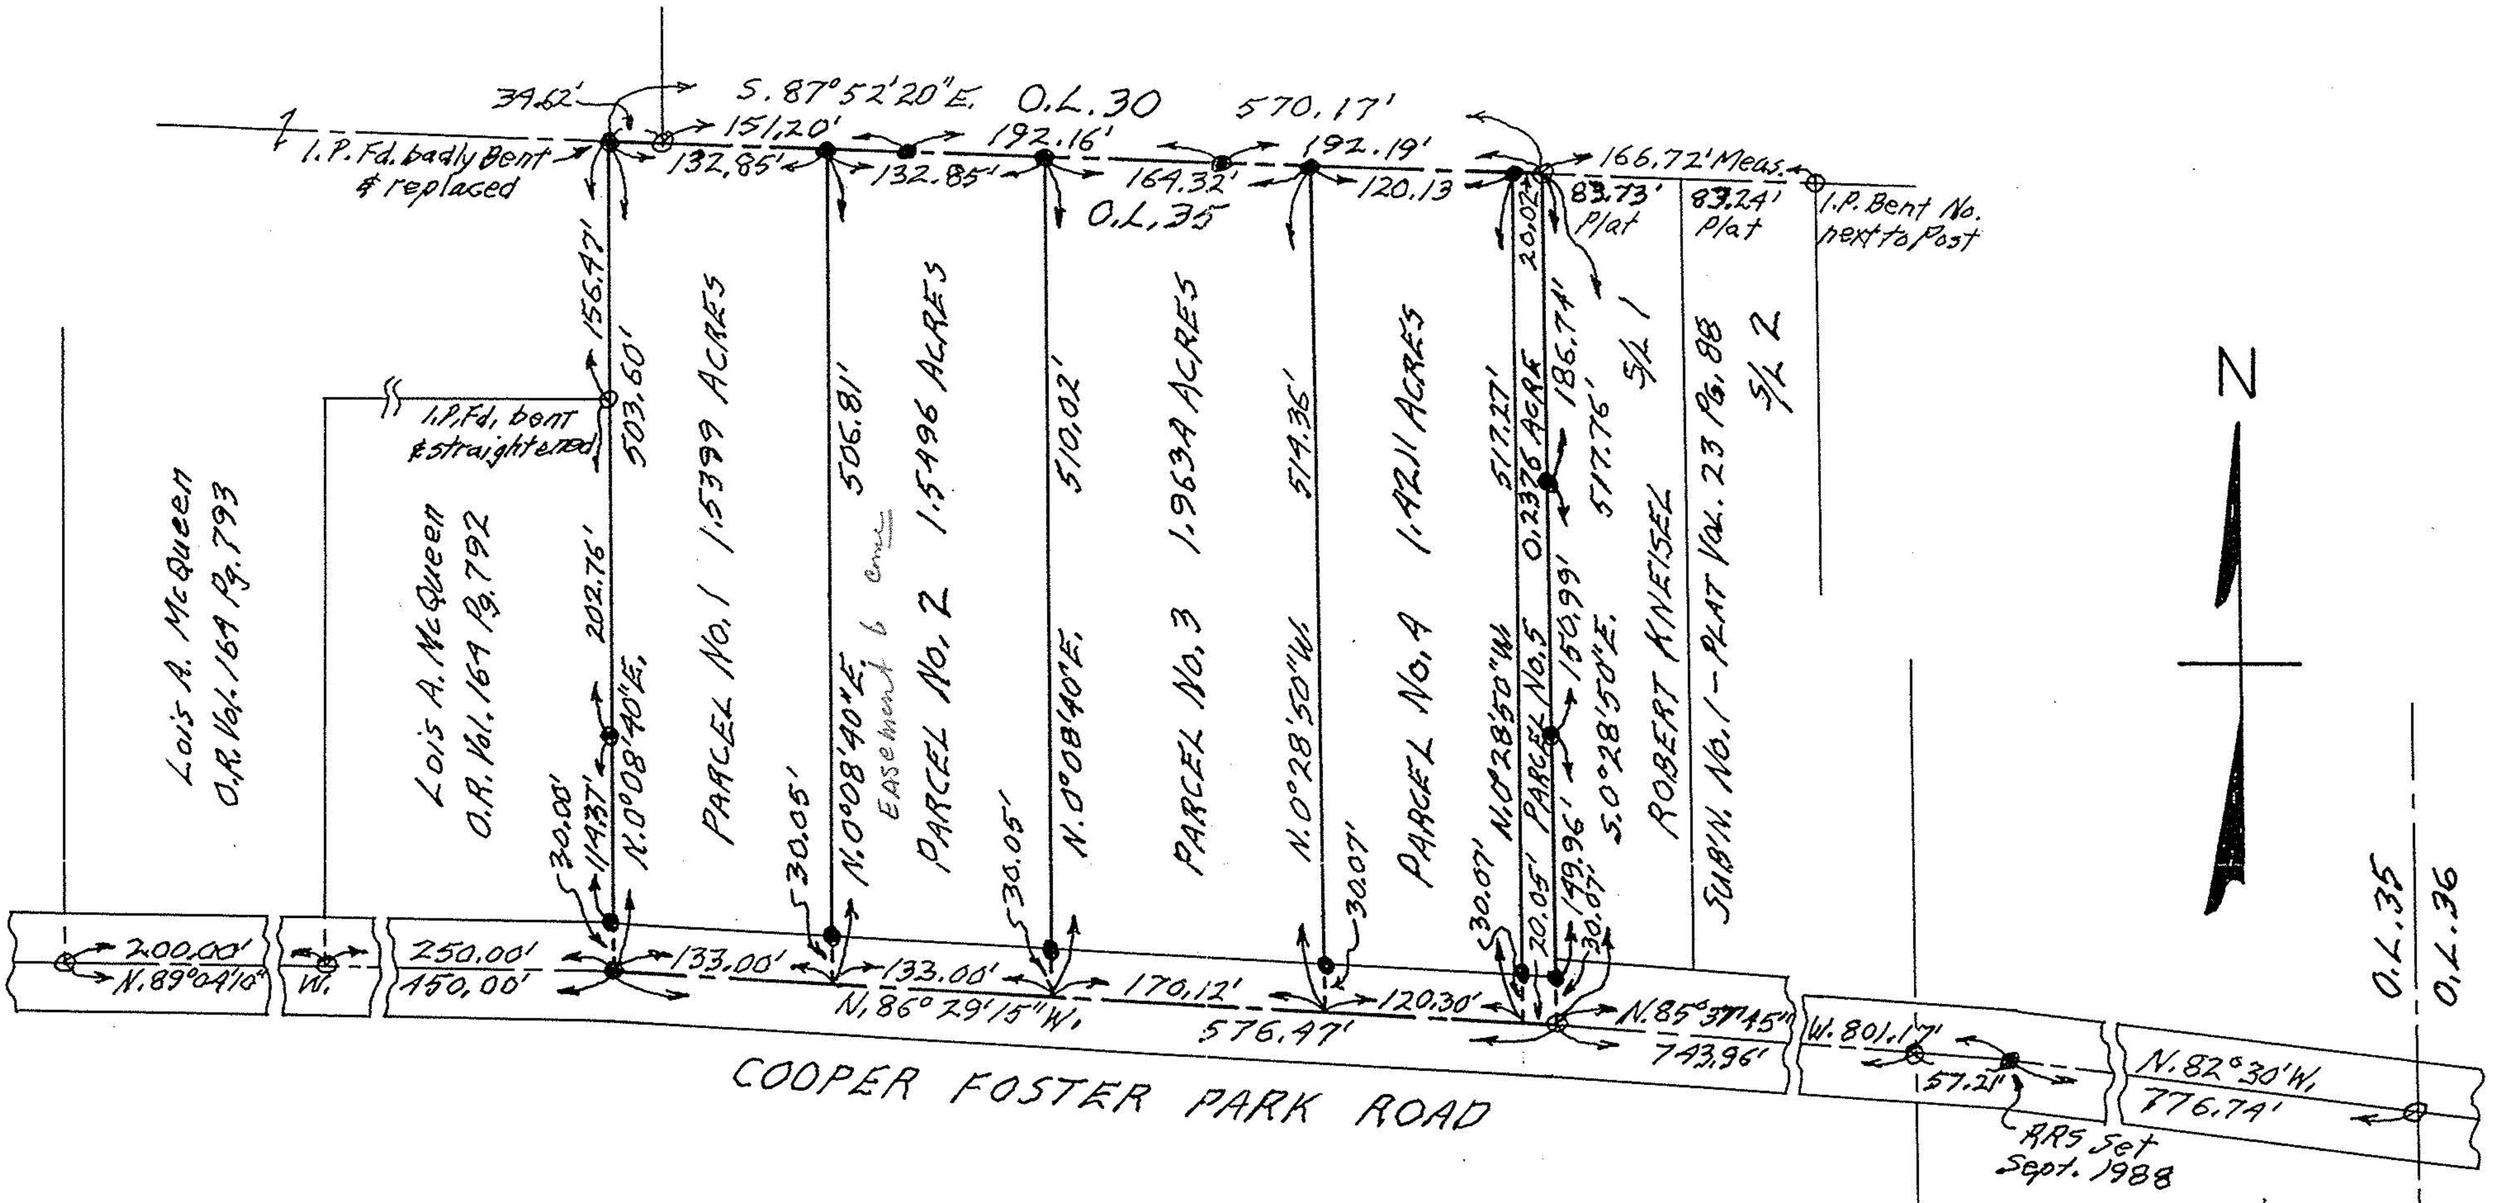

COOPER FOSTER PARK ROAD

PLAT OF SURVEYING FOR
ROBERT & JANET NEMETH
ORIGINAL LOT NO. 35 - BROWNHELM TWP.
VERMILION CITY - LORAIN COUNTY - OHIO
SCALE: 1" = 100' APRIL & MAY - 1989
Gary E. Perfound - Reg. Surveyor No. 4457
REVISED JUNE - 1990 FOR PARCELS NO'S. 1 & 2
REVISED JULY - 1990 FOR PARCELS NO'S. 3-4 & 5

NOTES: O indicates iron pin found.
● indicates iron pin set
unless otherwise designated.

#19086

APPROVED LORAIN CO. MAP DEPT.	
DATE	8-9-90
PAGE	1-00-035- A
BY	CAROLYN FRANCIS
VOID AFTER ~~#~~	19086

01-00-035-000