LAUNDON • SIMON • CAHL & ASSOC., INC.
CONSULTING ENGINEERS & SURVEYORS
110 MIDDLE AVE., ELYRIA, O. 44035

SURVEY FOR:
CARL JR. & CHLOE KOPOCS

Orig. Lot 36	City of VERMILION	Date JUNE 1, '92 Scale 1" = 100
Orig. Sec	Village of	Dwn. by R.G.S. Chkd. by R.C.
Tract	County of LORAIN	Job No. 92-2208 F.B.
Township of BROWNHELM	State of OHIO	Printed JUN 1 1992

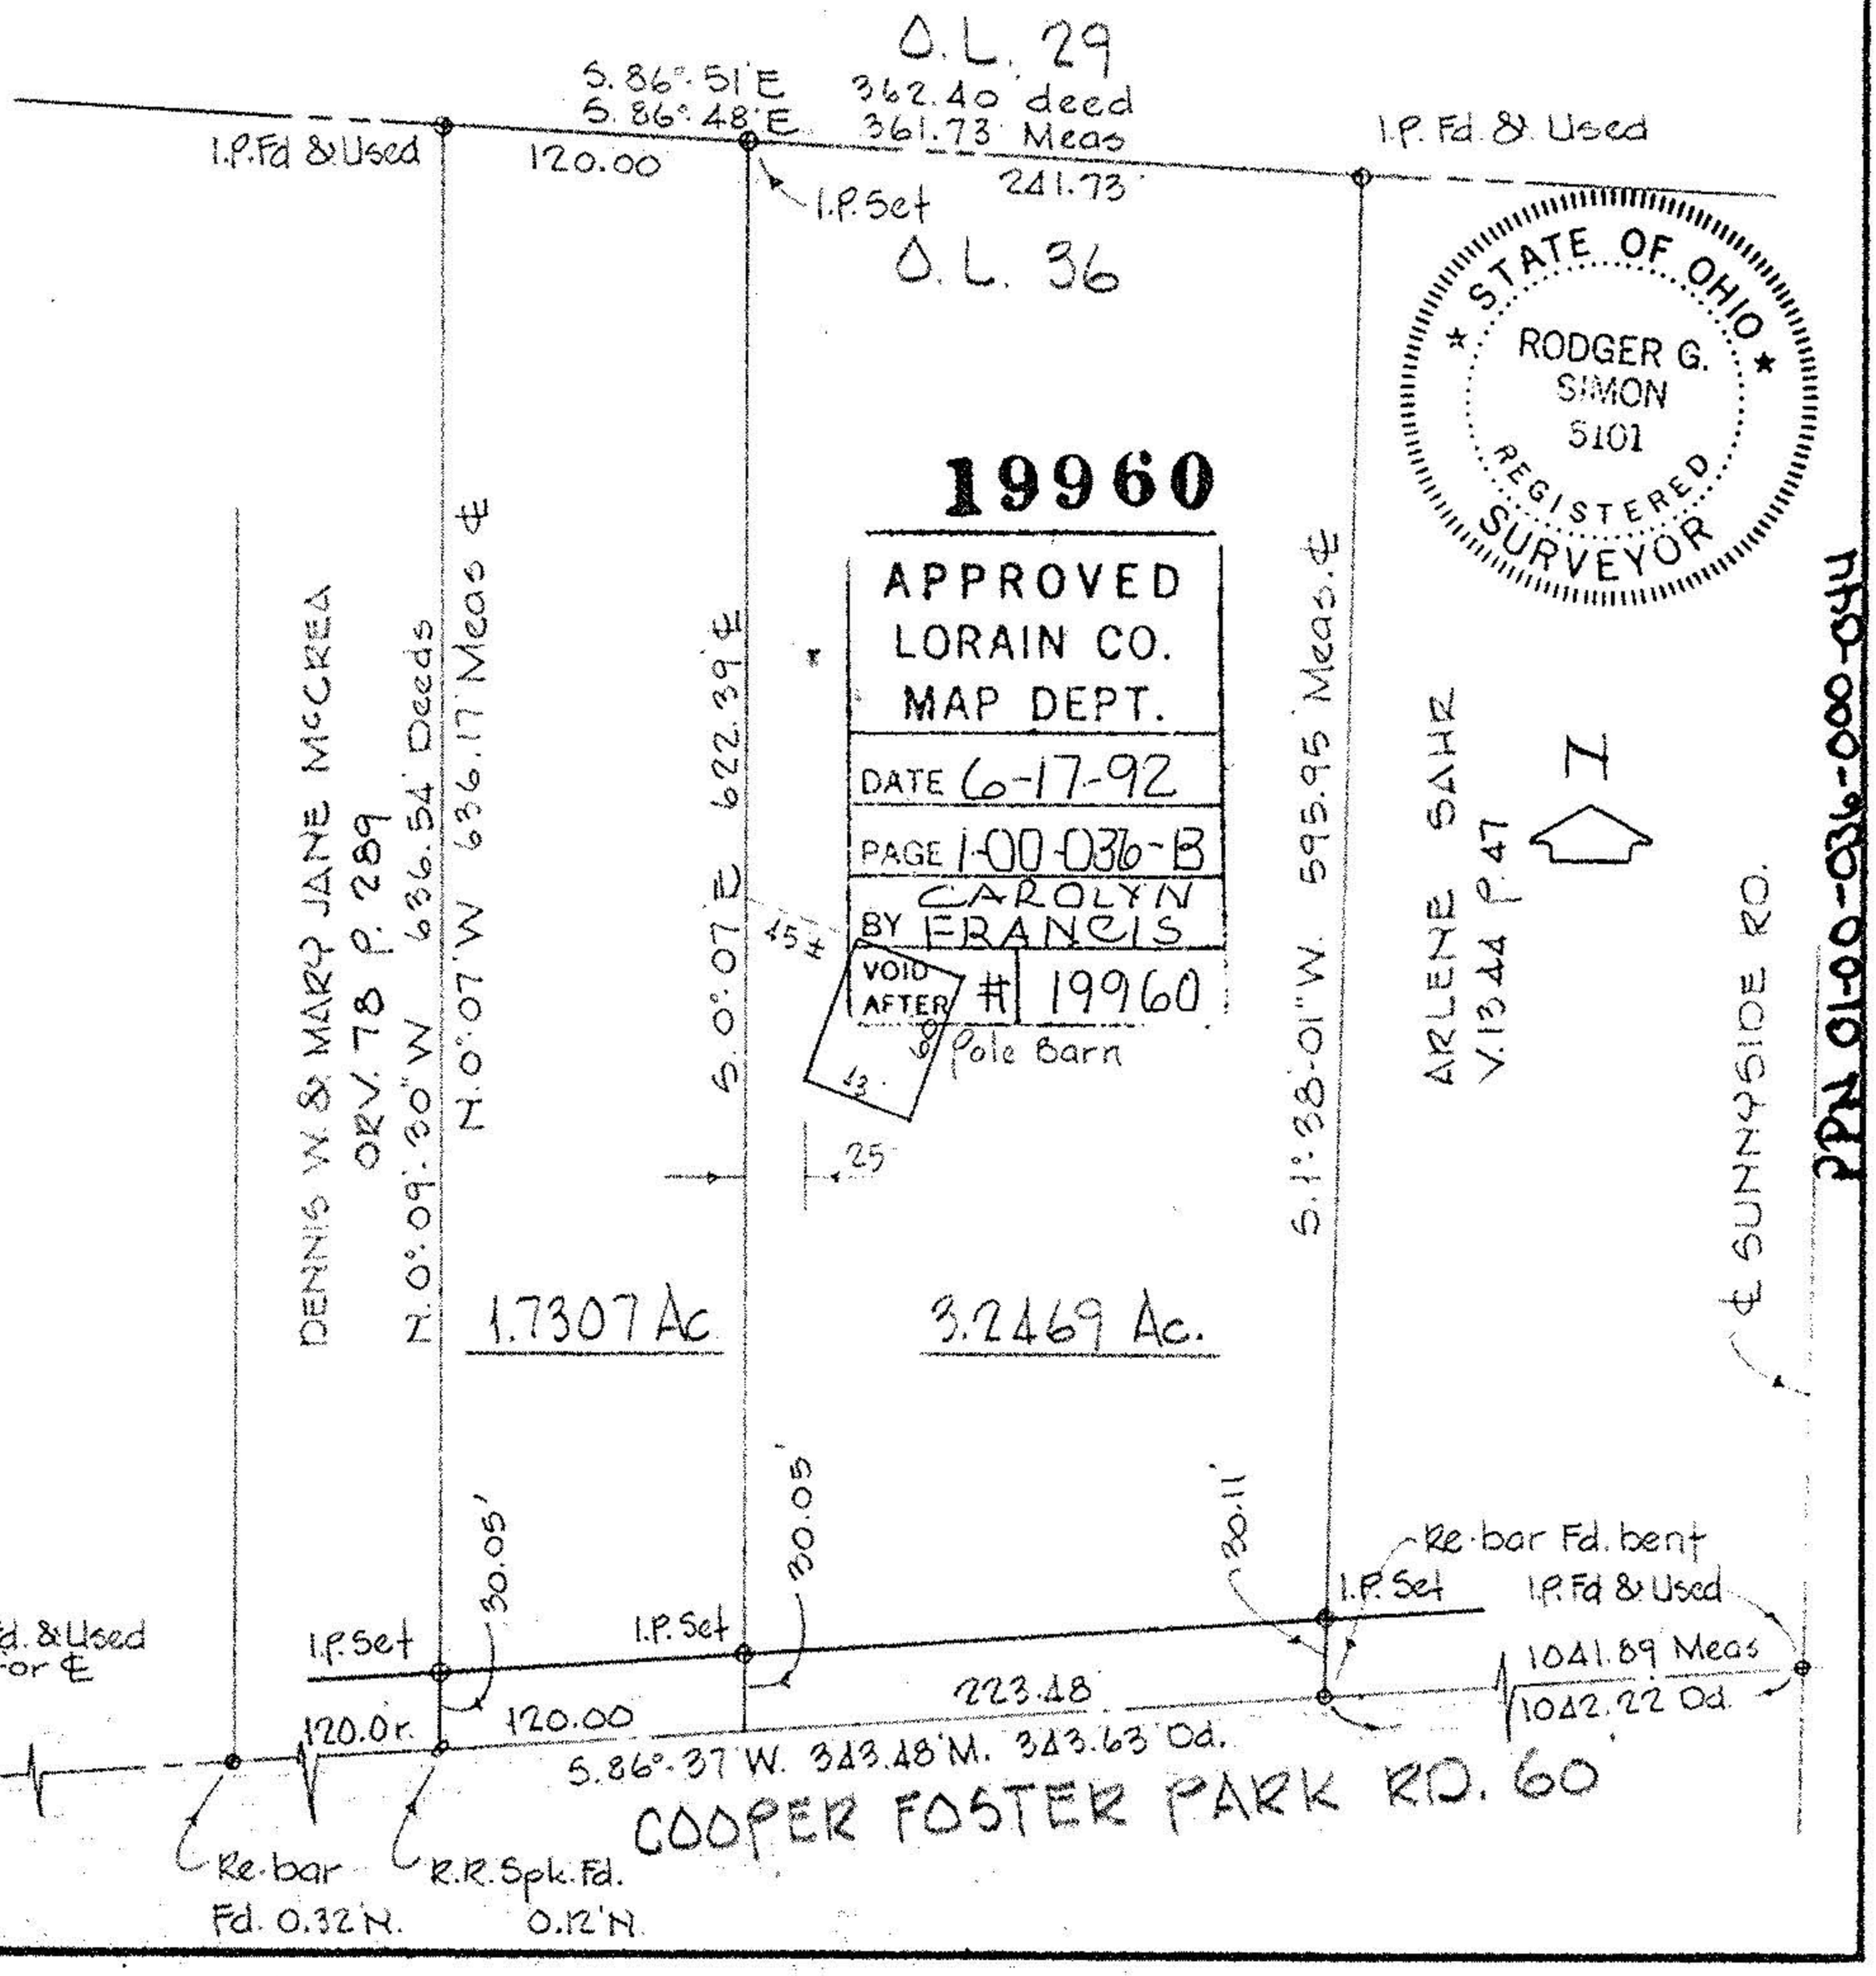

01-00-036-000-

19960

1-00-036-B

PPN 01-00-036-000-040