Map of Part of O.L. 36 Brownhelm Twp. now City of Vermilion Co. of Lorain
Scale 1" 400' July 15, 1985
By Arnold F. Koepp Reg. Surveyor No. 4306

CORRECTIONS MADE PER
A. KOEPP 8/3/88

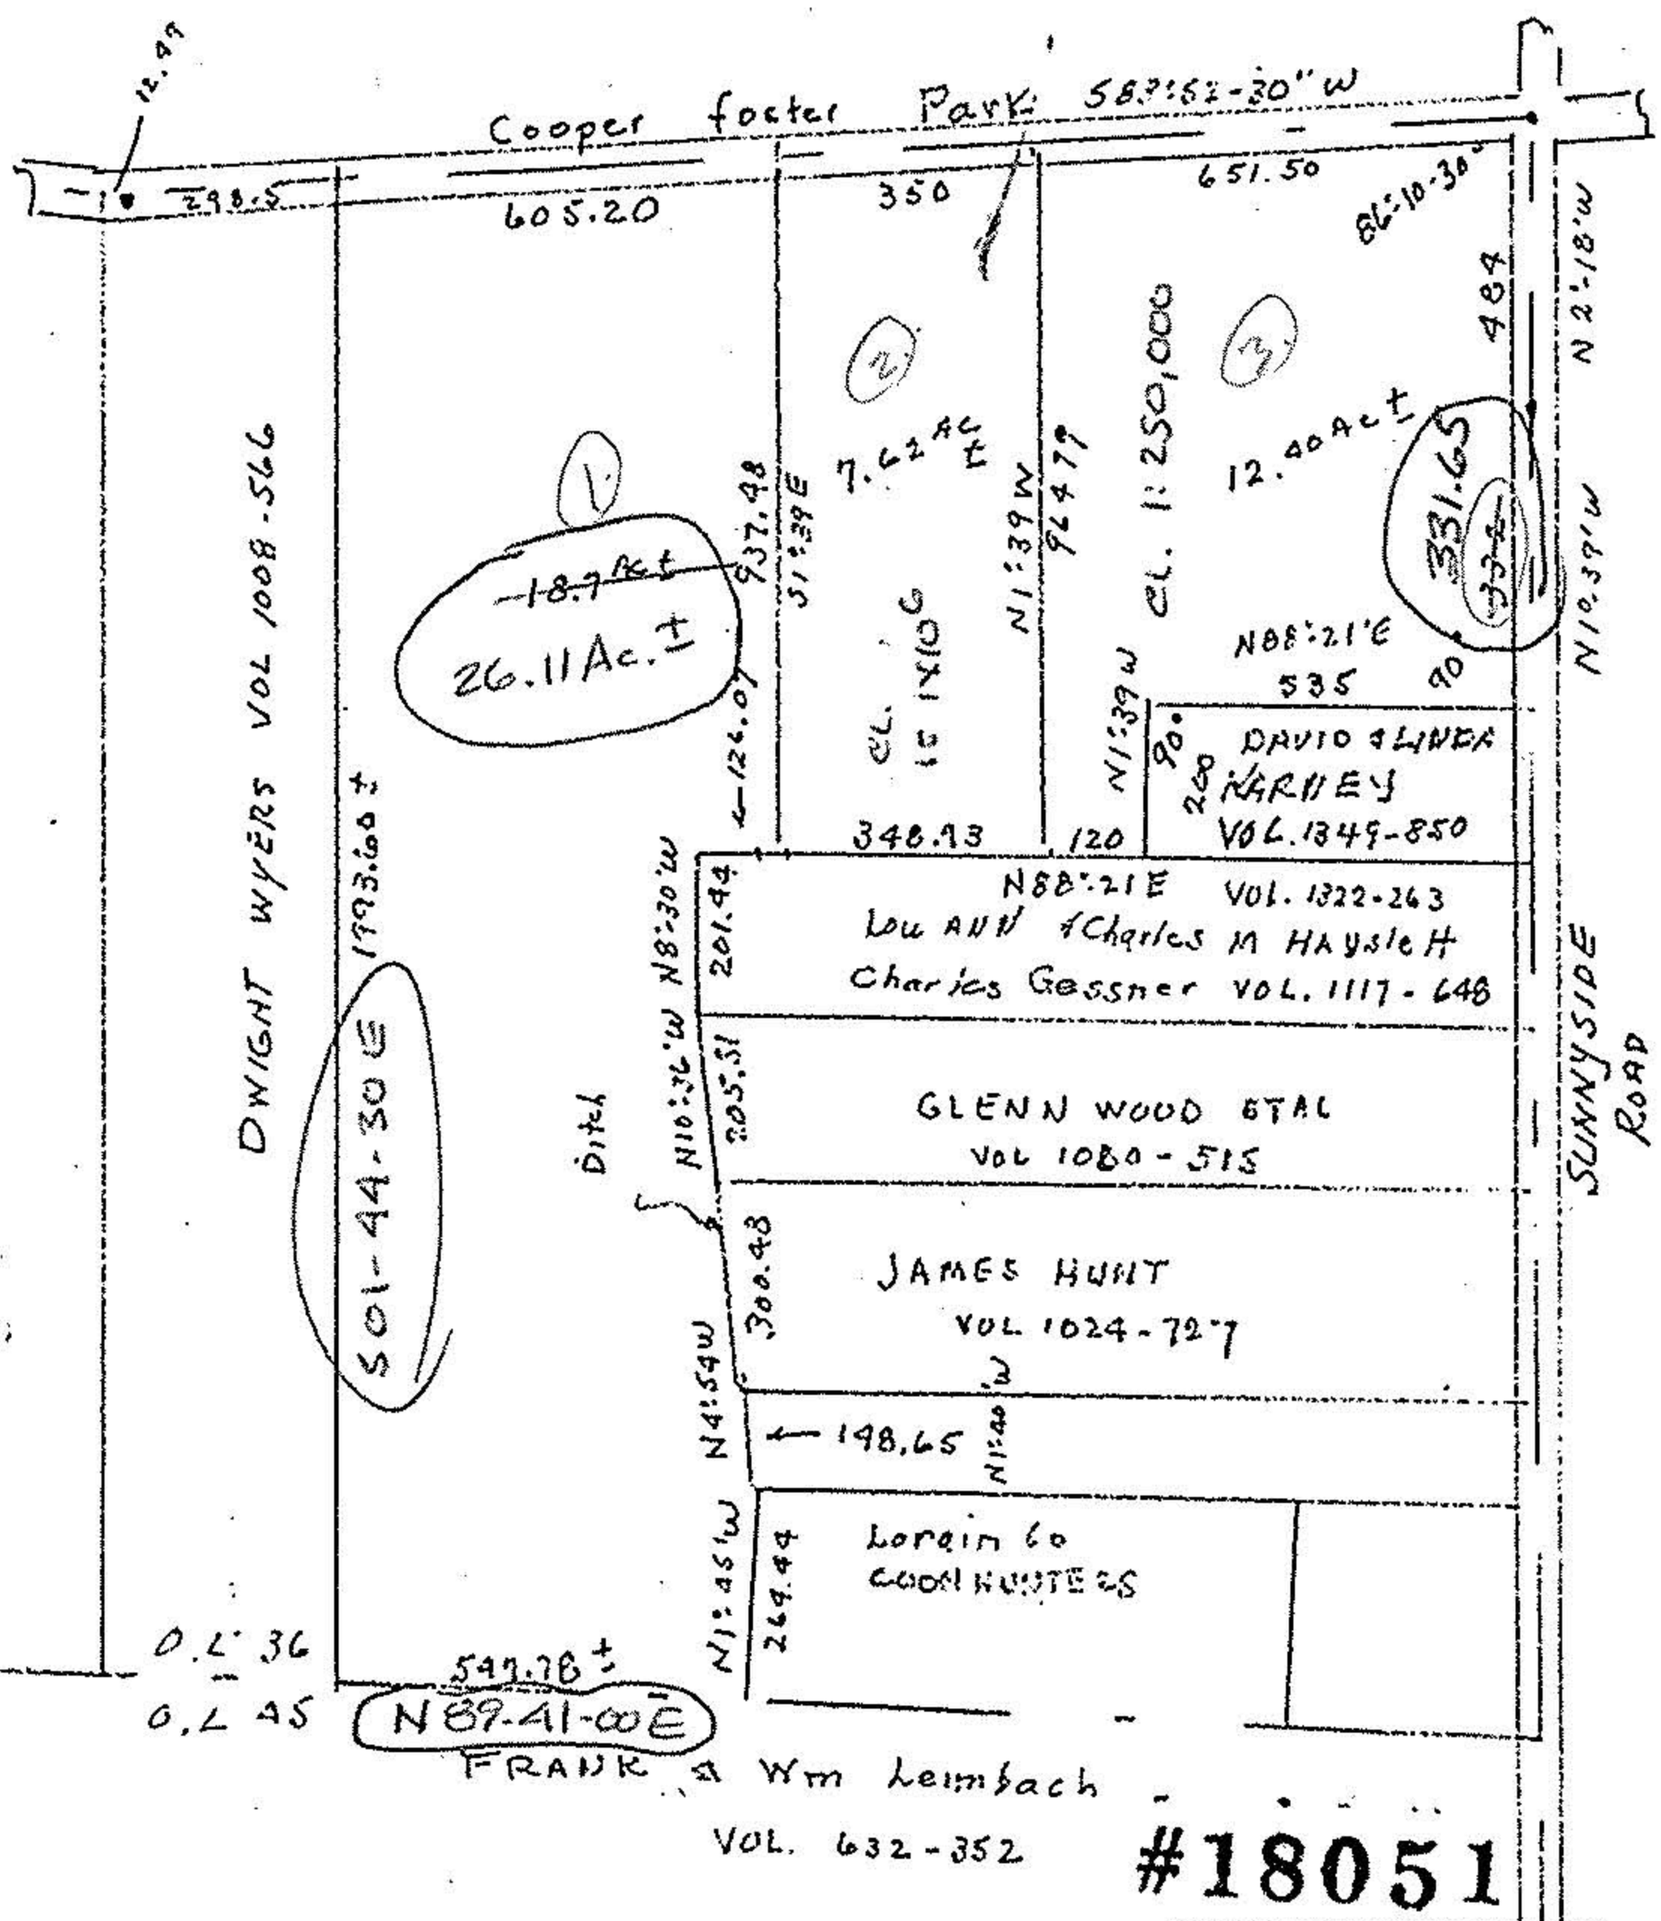

PPN 01-00-036-000-041

18051