1-00-027-A
028-B

Daly To Dil, Ref Pg 1-G Brownhelm

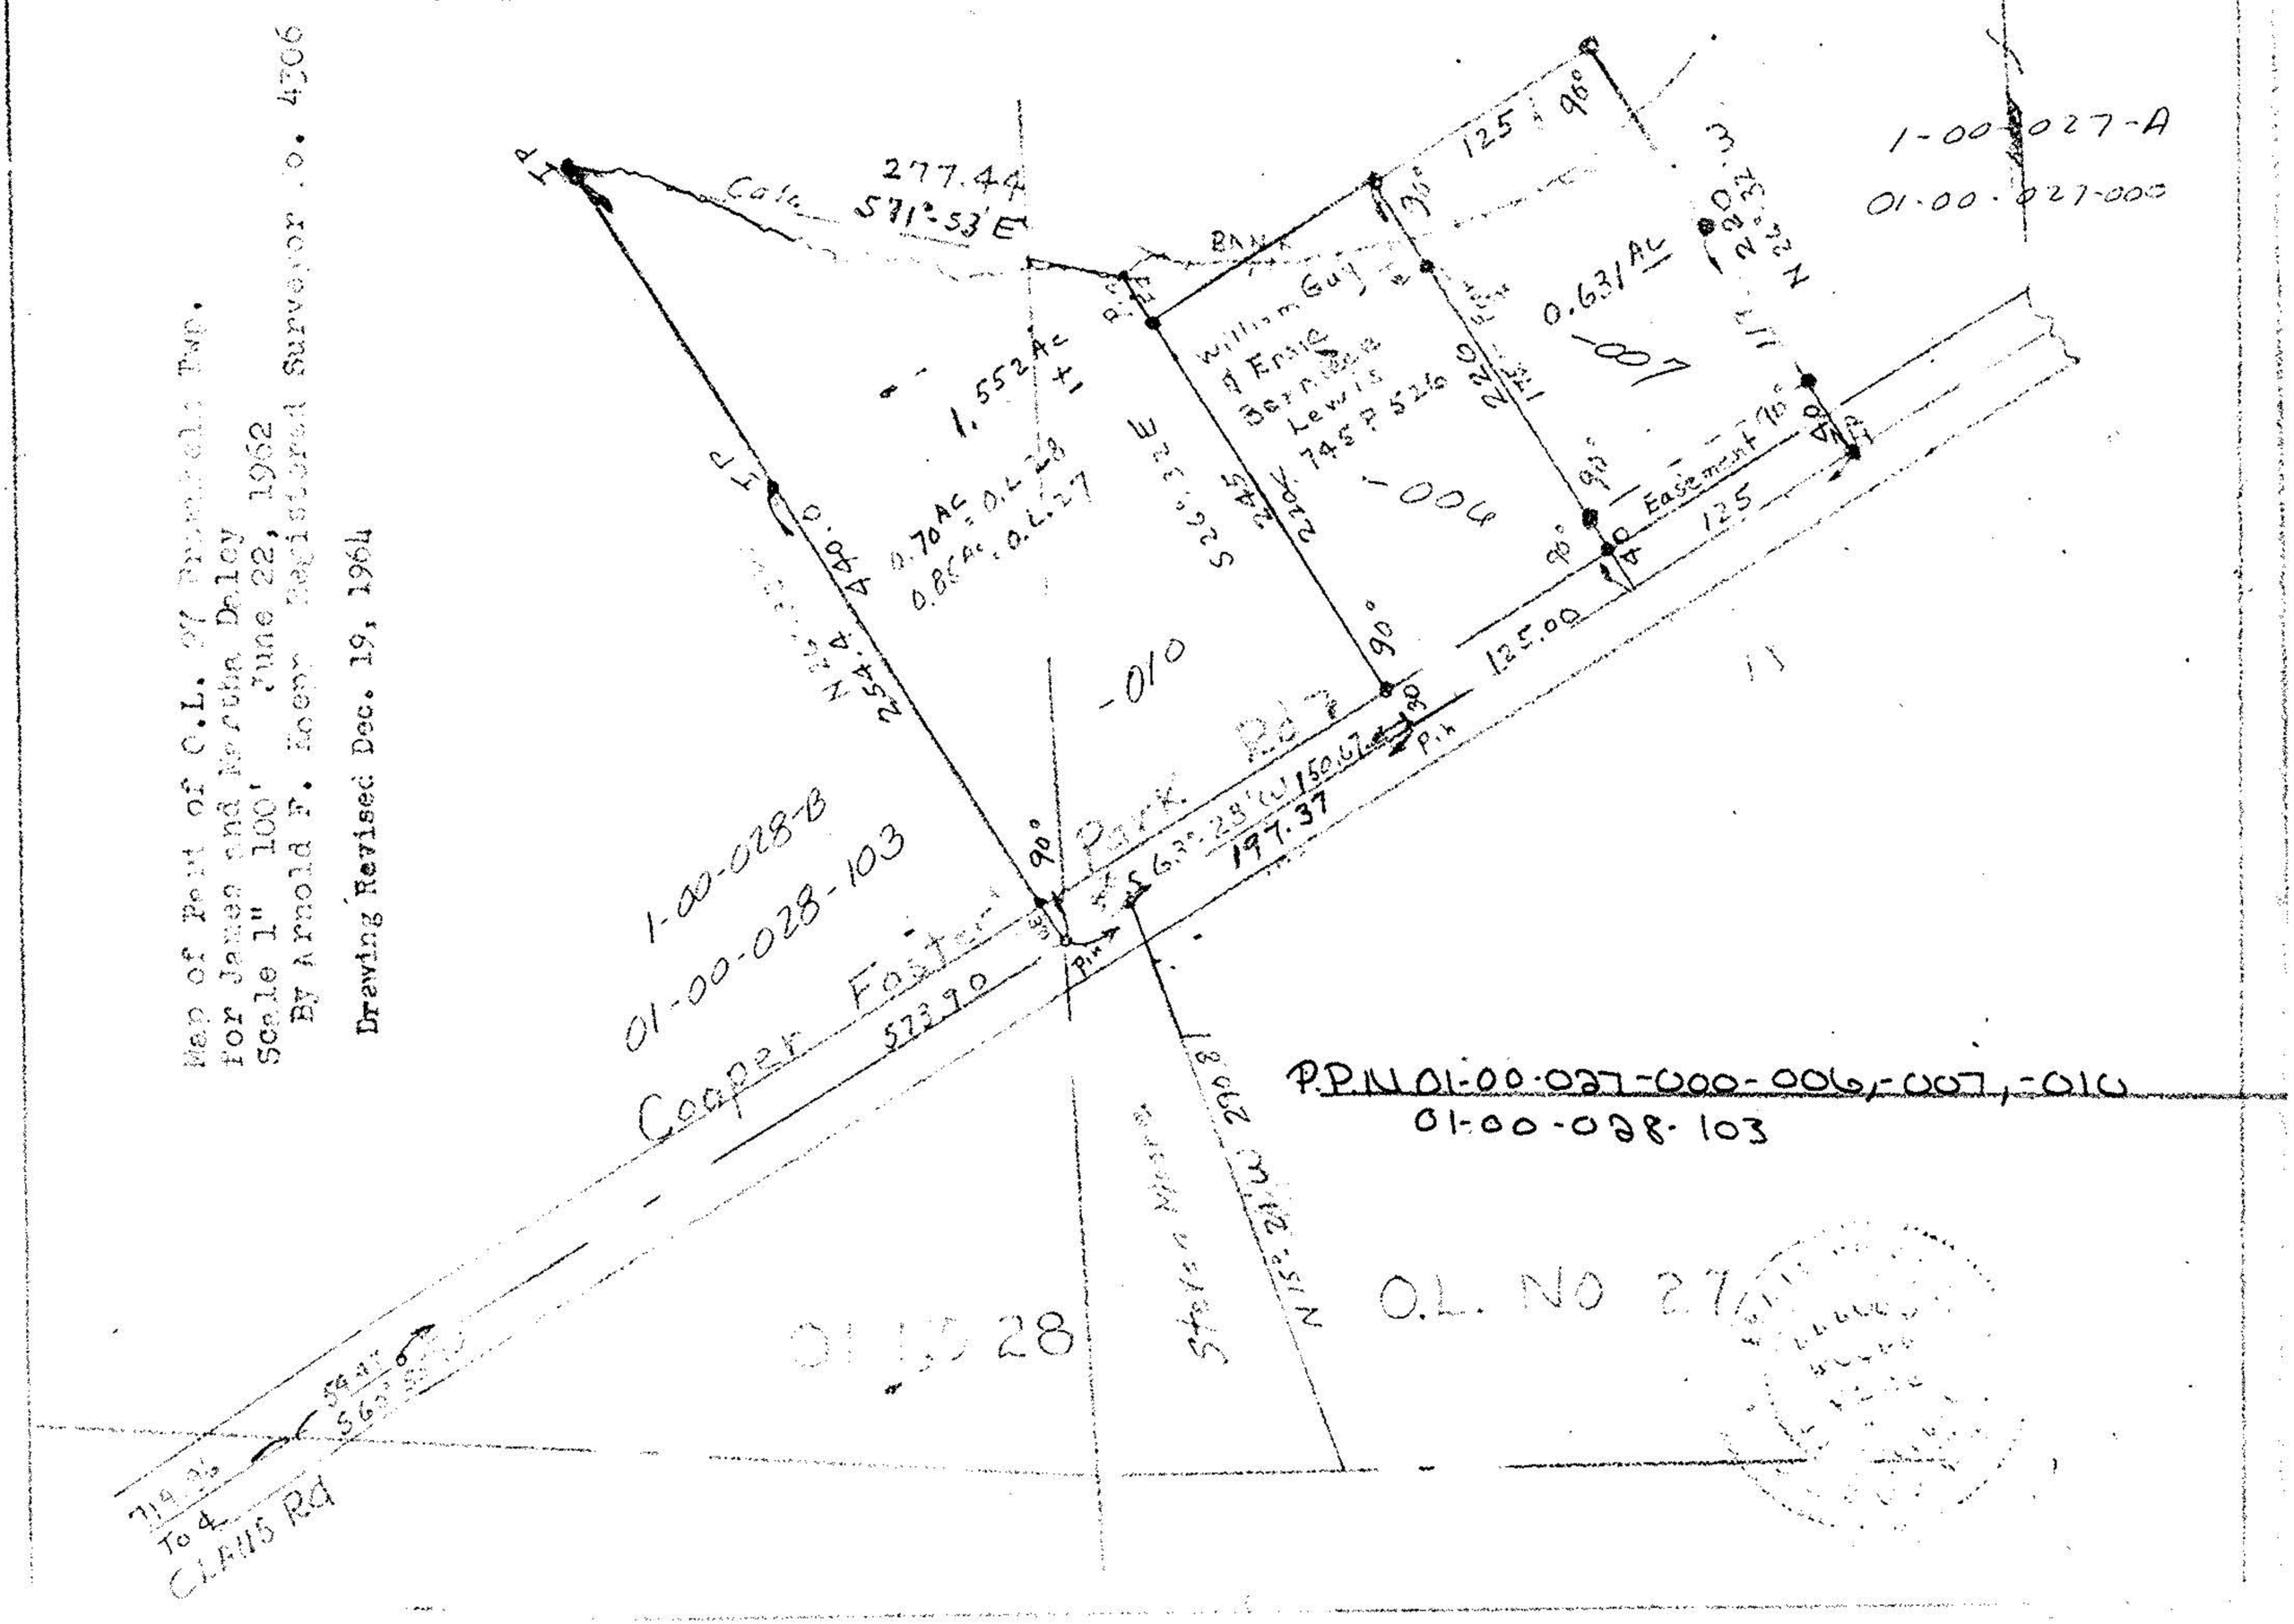

Map of Part of O.L. 27 Brownhelm Twp.
For James and Martha Daley
Scale 1" 100' June 22, 1962
By Arnold F. Koepp Registered Surveyor No. 4306

Drawing Revised Dec. 19, 1964