SURVEY

OF PART OF

ORIGINAL BROWNHELM TWP. LOT NO. 27

CITY OF VERMILLION COUNTY OF LORAIN

STATE OF OHIO

PREPARED BY:
HAPONEK AND ASSOCIATES INC.
ENGINEERS & SURVEYORS

STATE OF OHIO
GARY A. HAPONEK
S-6211
REGISTERED SURVEYOR

PREPARED FOR:
MRS. GAMMONS
1610 COOPER FOSTER PARK RD.
VERMILLION, OH

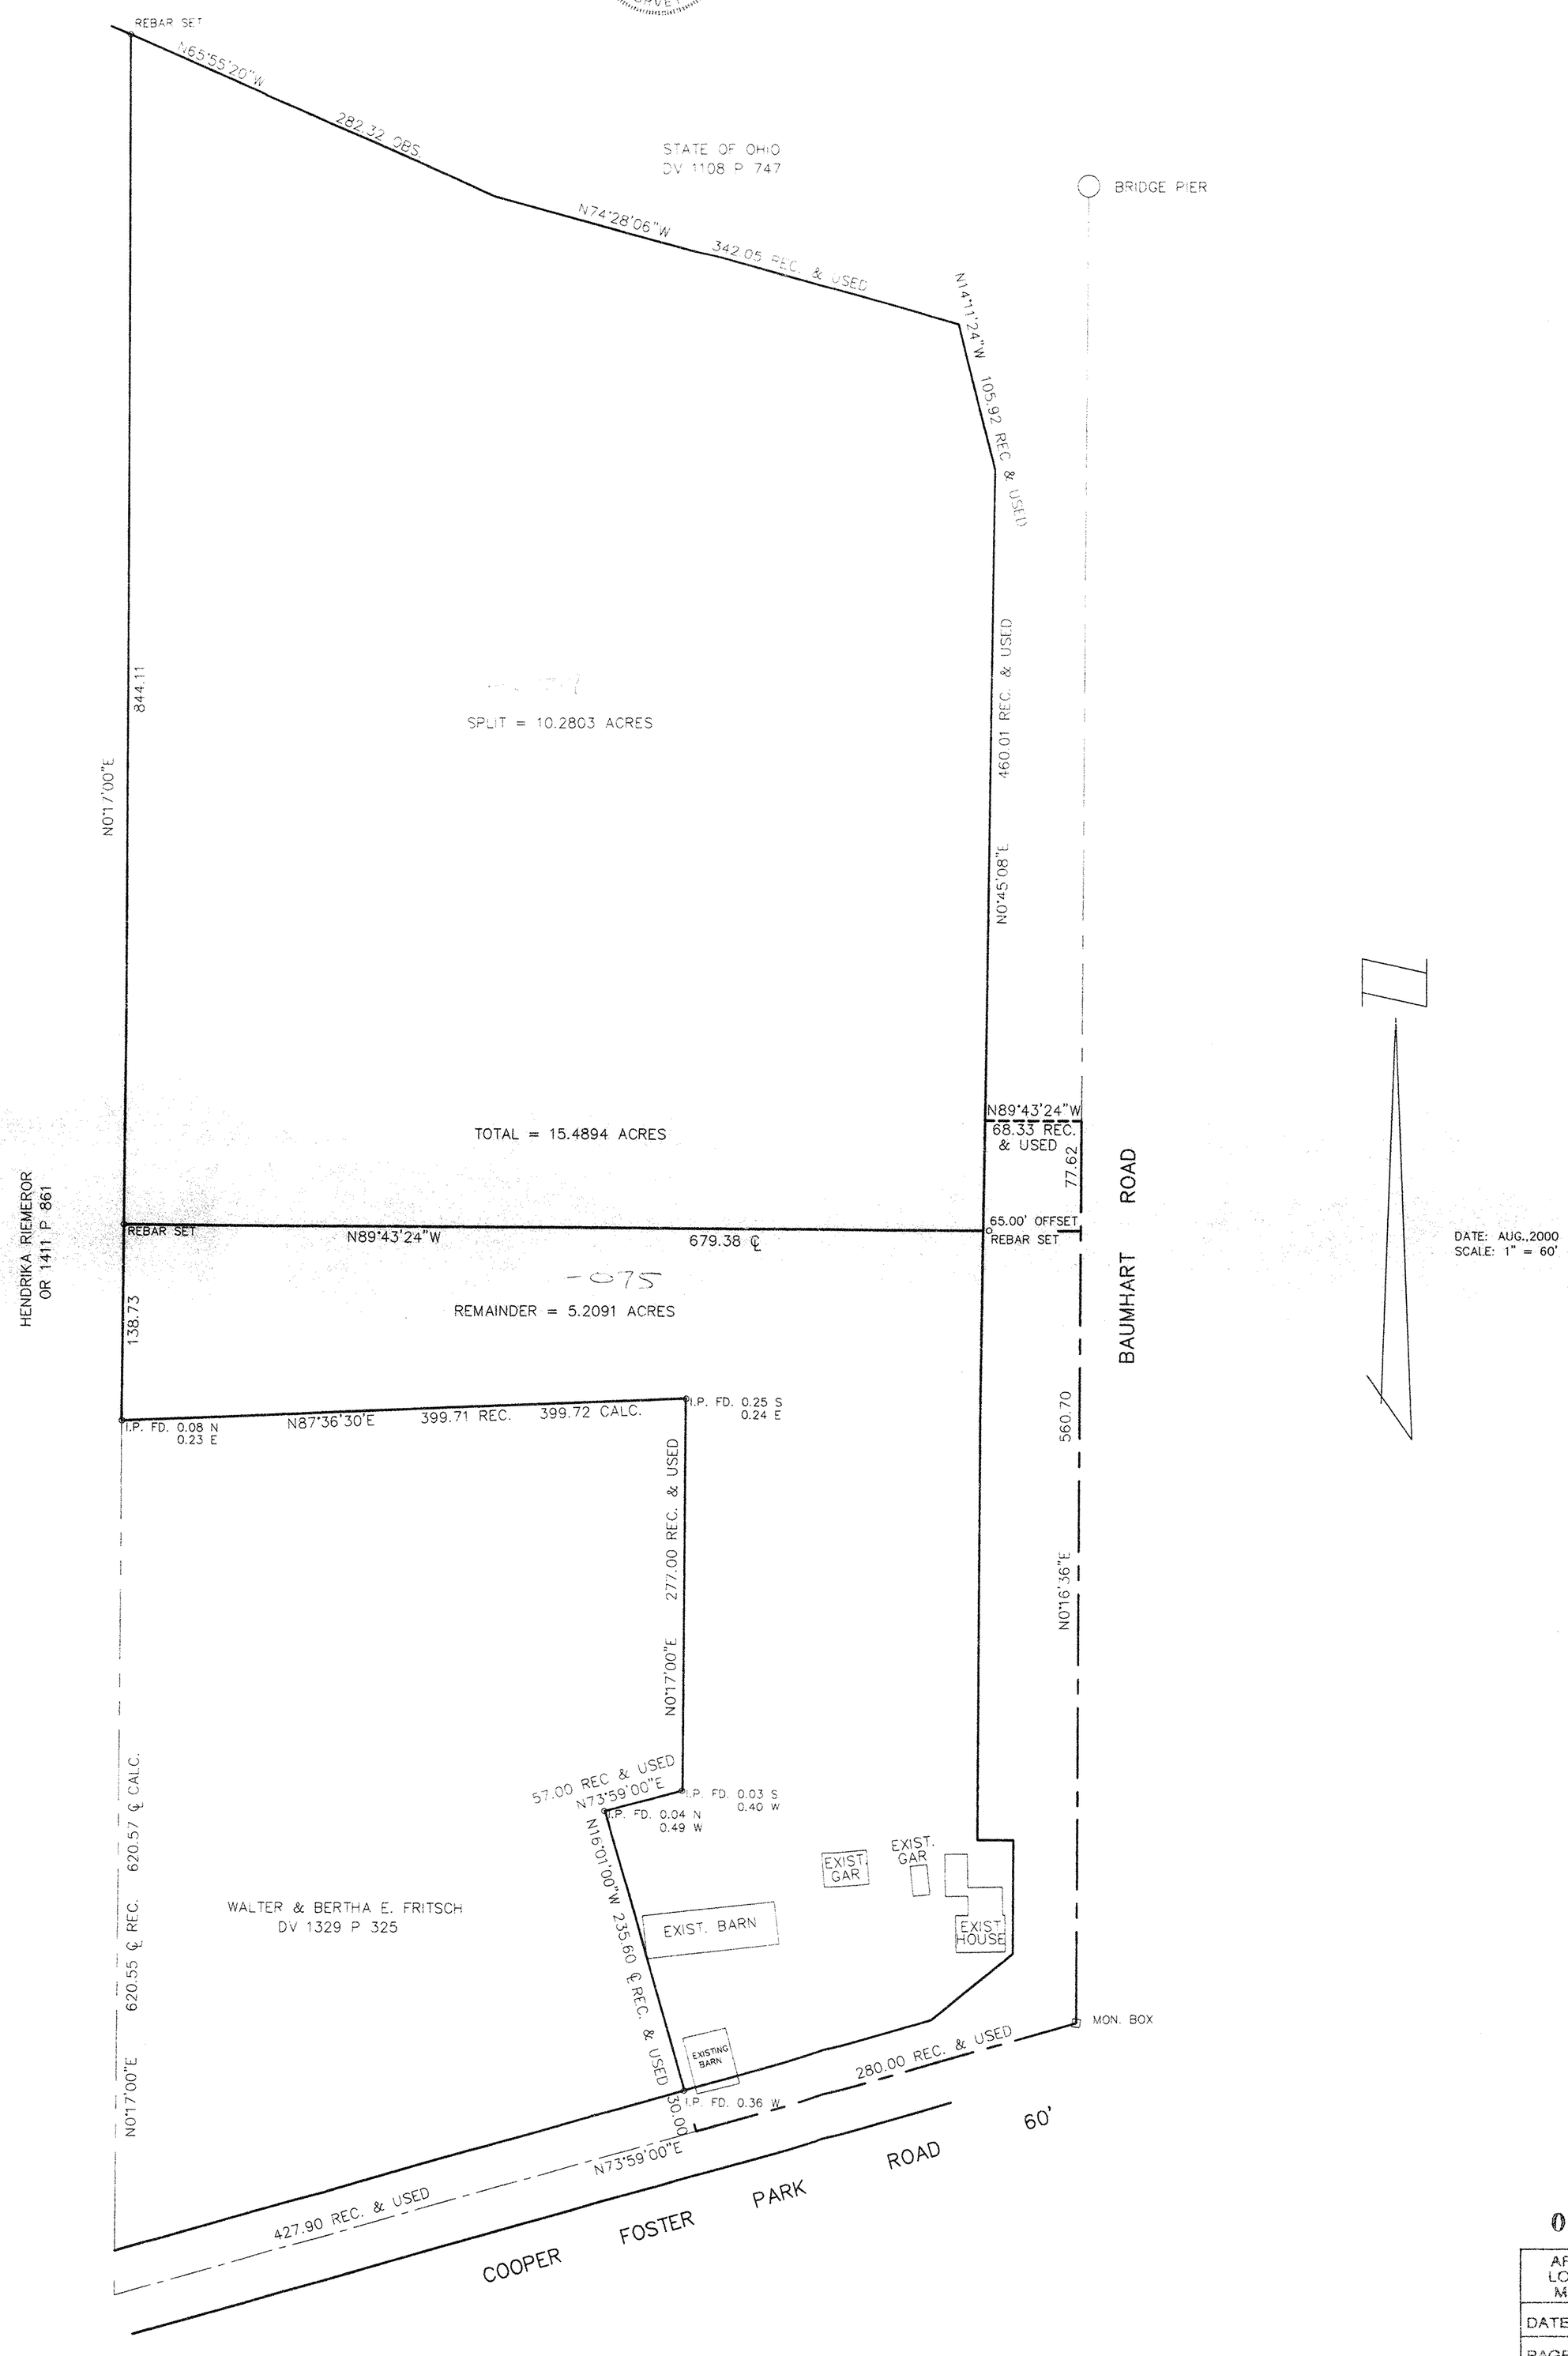

00753

APPROVED LORAIN CO. MAP DEPT
DATE 5-21-01
PAGE 1-00-027-B
BY JHatfield
01-00753

REVISED: SPLIT OCT. 9, 2000

PPN 01-00-027-000-075 074 057

00-05