

P.P.N 01-00-037-102-001

088

FRED G & MARION GRINGLE
V.465 P.213

SANDRA K STARK
V.1121 P.722

DAVID TOMSCO
V.1176 P.152

RAYMOND G & SHIRLEY
A. STERK
V.1140 P.943

RAYMOND E & LINDA RENDE BORN
V.1349 P.771

5.89° 55' 00"E.

1.P.Fd.

142.70'

408.66 Calc.

5.89° 55' 00"E.

142.70'


1.P.Fd.

100.0

GLENN E. SEIBERT
V.1118 P.606

1.P.Fd. 30.21'

100.0

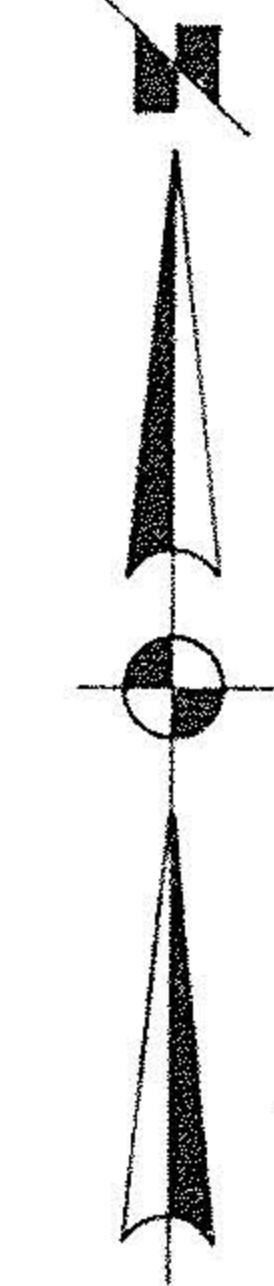

BERNARD N & KAREN L. KAUK
V.1265 P.674

N.1° 44' 40"W. 450.0 rec.
451.07 Calc.

PARCEL No 3
4.0823 Ac.

SETH D & RUTH A.
STEVENSON
V.1208 P.775

100.0' R. & R.
1.P.Fd.

BERNARD N & KAREN L. KAUK
V.1372 P.541

WM. & LUTIGARD
BRINGMAN
V.755 P.315

155.0' R. & R.
1.P.Fd.
N.1° 44' 40"W.
167.60 m.
162.50± rec.

PARCEL No 2
1.3300 Ac.

393.53'
5.87° 33' 50"W. 434.56' R.

MICHAEL KOTORA
V.774 P.497

138.10'
138.10 m.
1.P.Fd.

1.P.set
N.88° 35' 30"E.
112.58'

1.P.set

PARCEL No 1
2.6976 Ac.

5.89° 49' 28"W. 848.56' m. &
5.89° 59' 00"W. 848.10' rec.

5.89° 49' 28"W. 491.40' E

30.20'


1.P.Fd.

RUTH J. & RICHARD J. REED
V.790 P.86
(Rmdr.)

DON M. & LINDA D. BETTS
O.R.V. 46 P.833

SURVEY FOR

BERNARD & KAREN L. KAUK

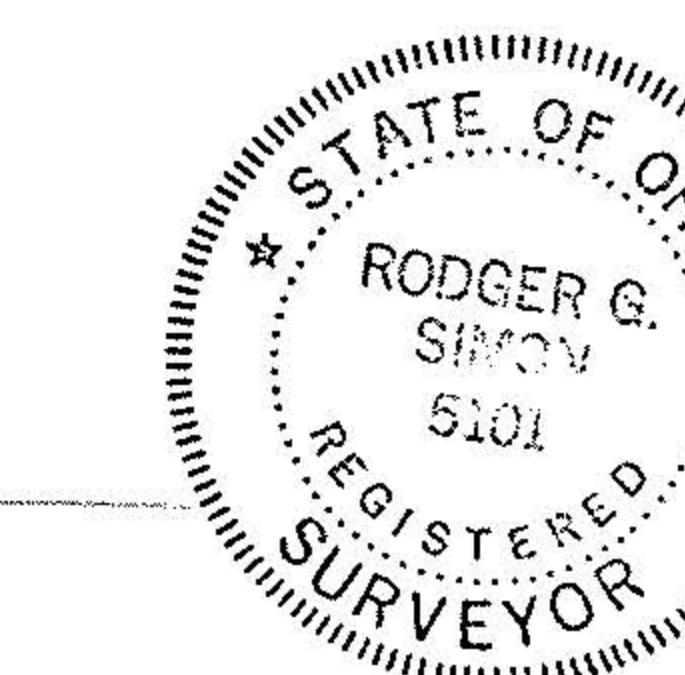

PART OF O.L.37
COUNTY OF LORAIN
SCALE 1"=50
LAUDON • SIMON • CAHL & ASSOC.

BROWNSVILLE TWP.
STATE OF OHIO
DEC., 1988
ENGINEERS SURVEYORS
Job No. 88-4783

#18799

APPROVED
LORAIN CO.
MAP DEPT.

DATE 1-3-90

PAGE 1-00-037-B

CAROLYN
BY FRANCIS

VOID AFTER #

18799

470.52 rec.

56.40'

41.03 m

1.P.set
I.P.Fd.

393.53'

5.87° 33' 50"W. 434.56' R.

138.10'

138.10 m.

1.P.Fd.

23.76 m.

1.P.Fd.

138.10'

138.10 m.

1.P.Fd.