


60400  
095

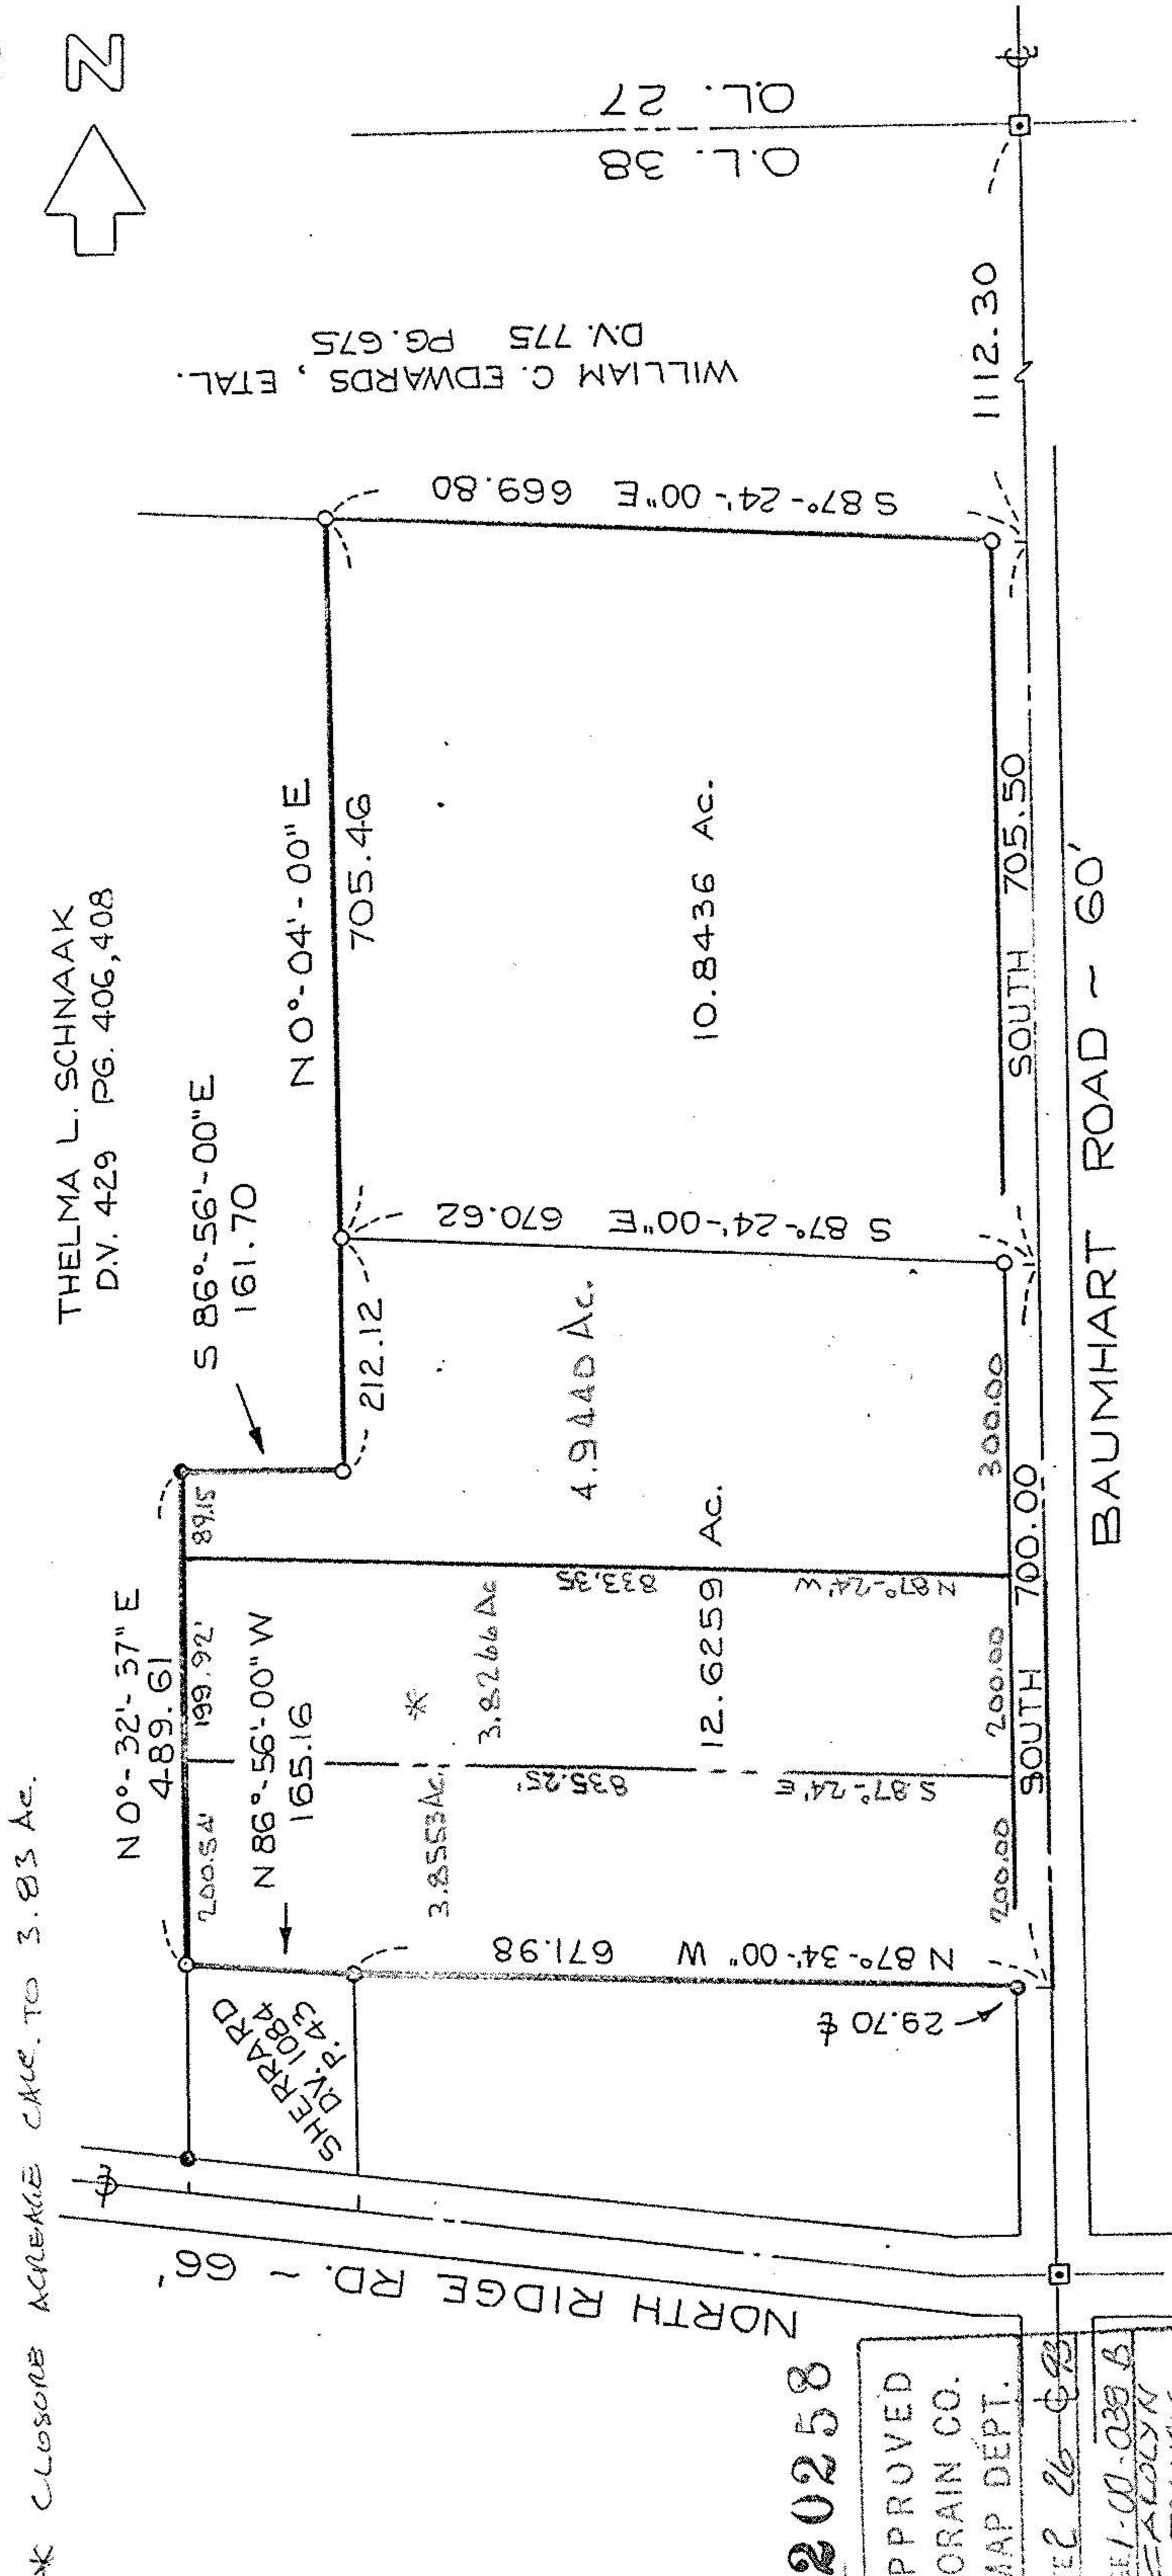


PLAT OF SURVEY FOR  
LADDIE J. and NELLIE MITSKA  
BEING PT. OF LOT 38 BROWNHELM TWP.  
LORAIN CO. STATE OF OHIO  
SCALE 1" = 200' DECEMBER 1976

Richard A. Mitiska  
Registered Surveyor No. 5412

LEGEND  
● IRON PIN FOUND  
○ IRON PIN SET  
☐ MON. BOX / IRON PIN

APPROVED  
LORAIN CO.  
MAP DEPT.  
DATE 2-26-93  
PAGE 1-00-038-C  
BY FRANCIS  
VOID AFTER # 20258

20258

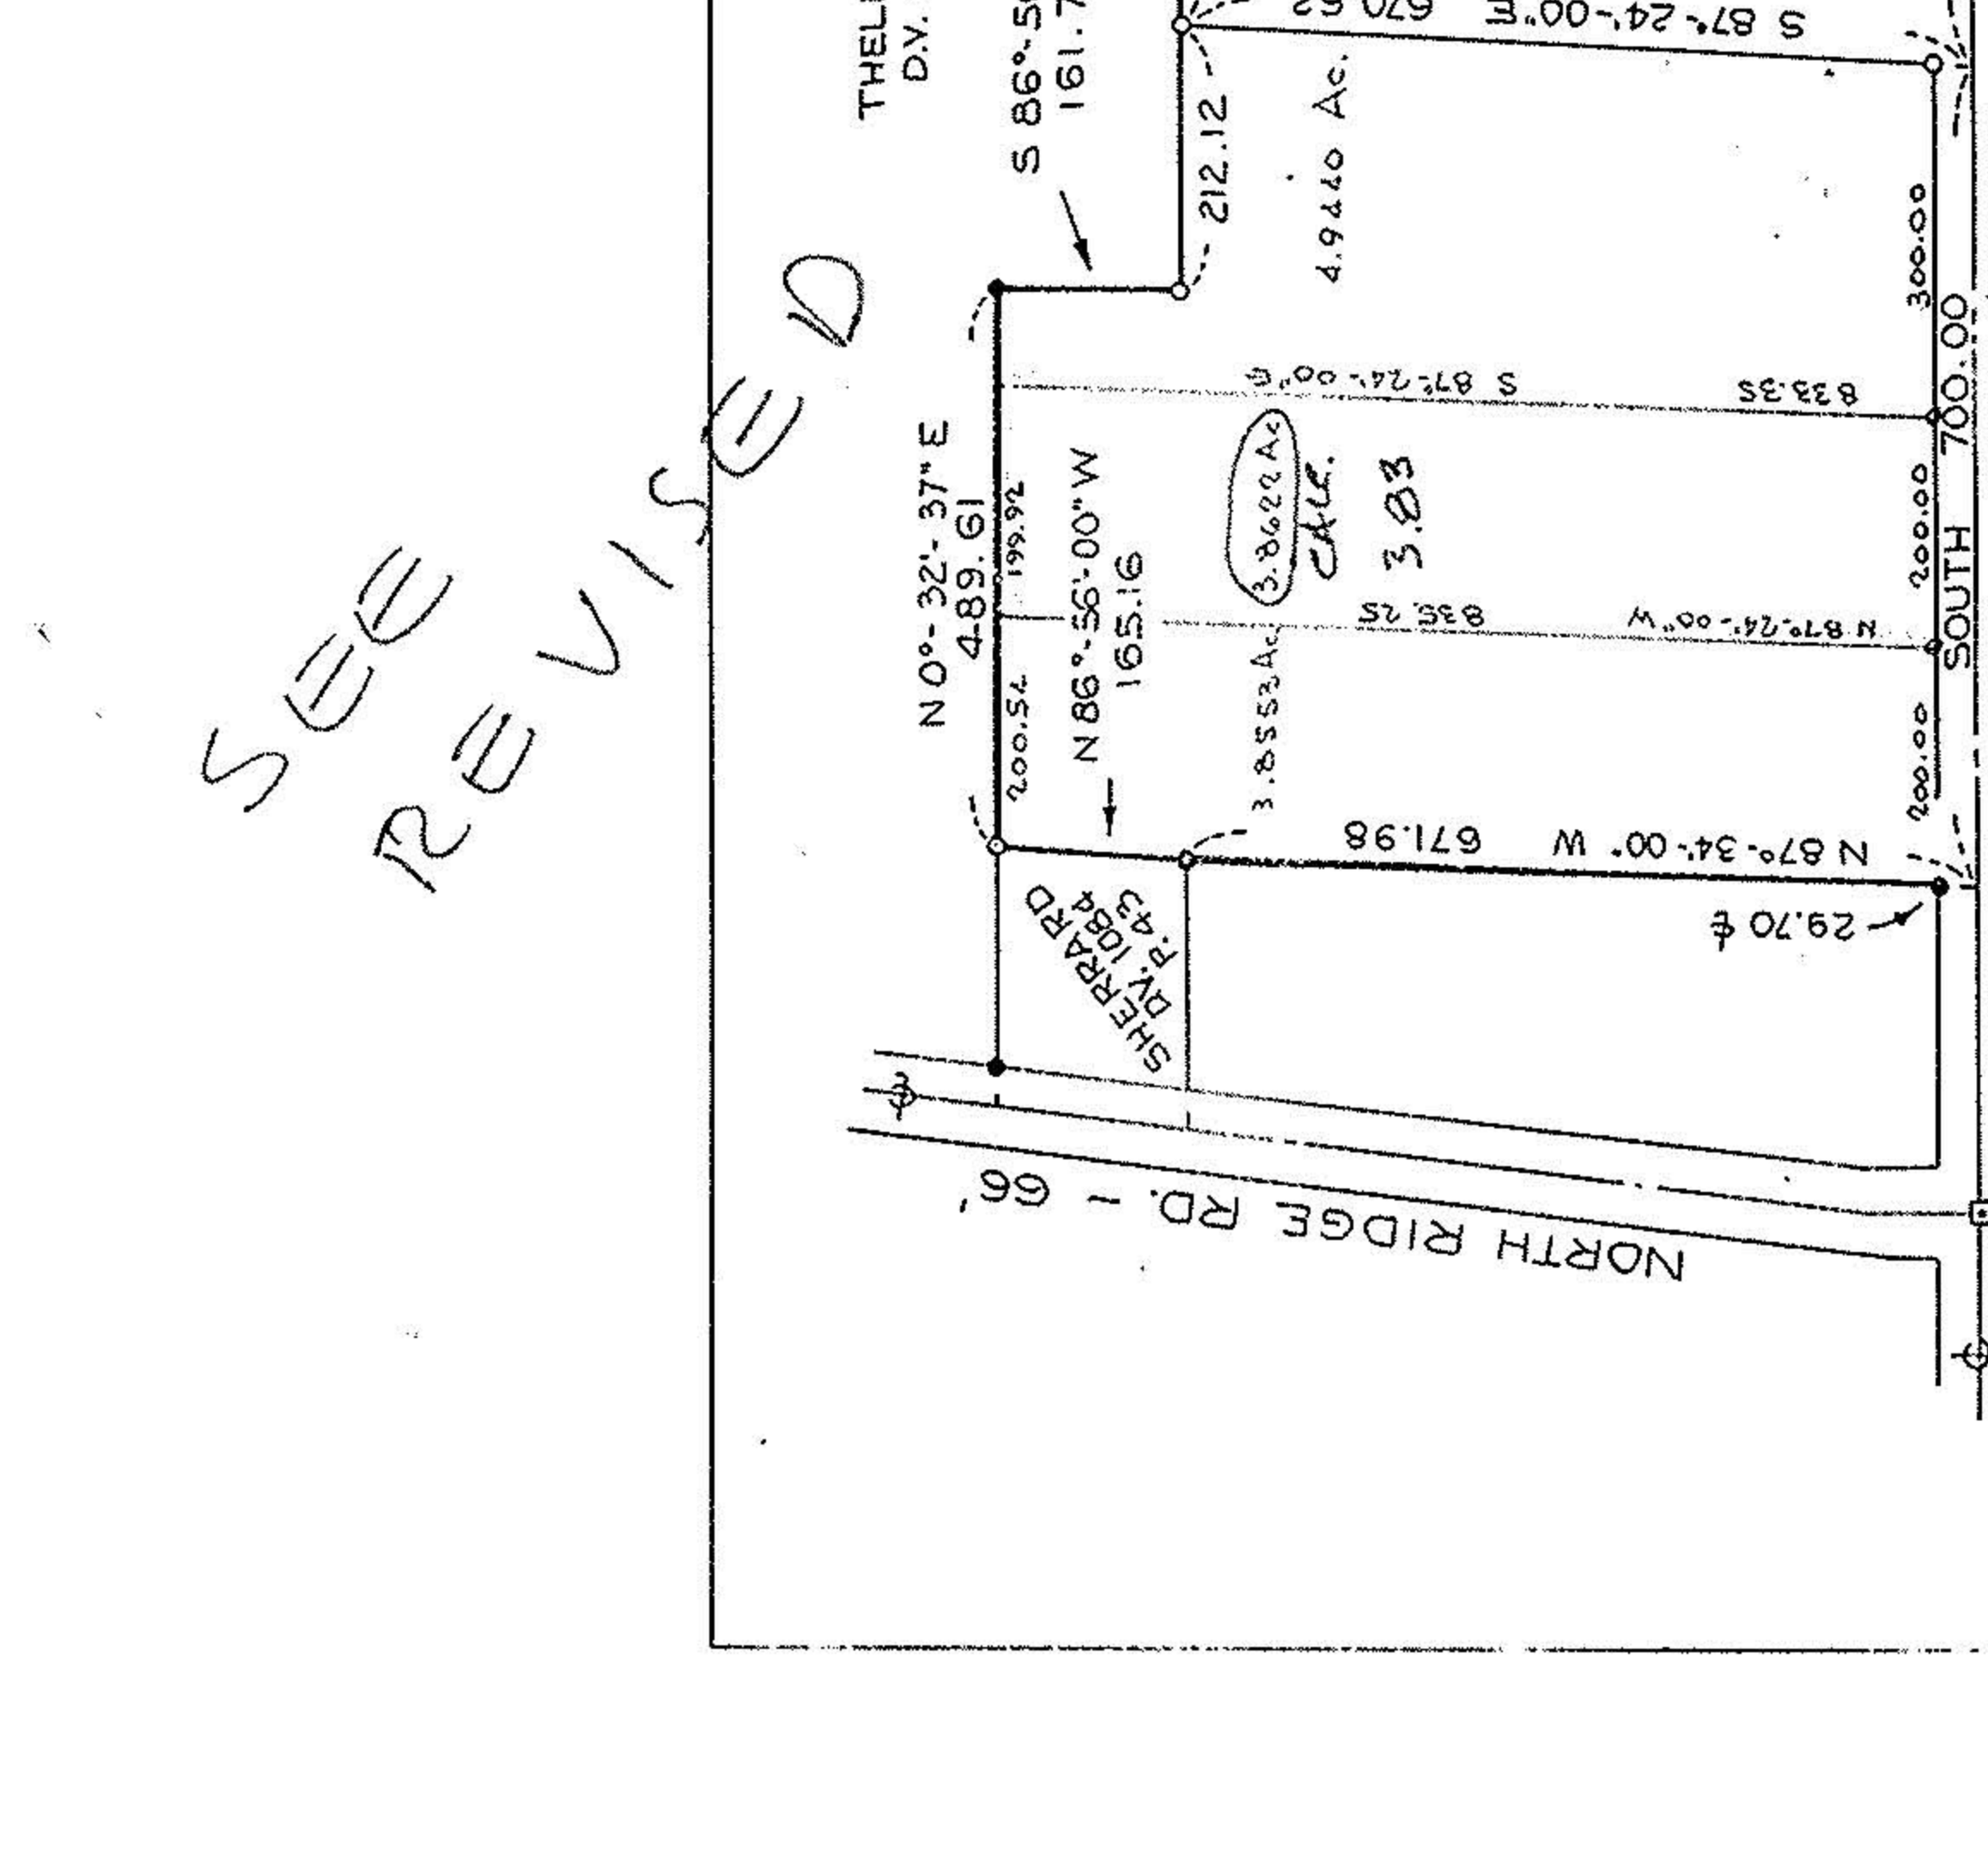

PLAT OF SURVEY FOR  
LADDIE J. and NELLIE MITSKA  
BEING PT. OF LOT 38 BROWNHELM TWP.  
LORAIN CO. STATE OF OHIO  
SCALE 1" = 200' DECEMBER 1976

Richard A. Mitiska  
Registered Surveyor No. 5412

LEGEND  
● IRON PIN FOUND  
○ IRON PIN SET  
☐ MON. BOX / IRON PIN

APPROVED  
LORAIN CO.  
MAP DEPT.  
DATE 2-26-93  
PAGE 1-00-038-C  
BY FRANCIS  
VOID AFTER # 20258

SEE REVISED