THOMAS SIMON & ASSOCIATES, INC.
PROFESSIONAL LAND SURVEYORS
COBBLESTONE CORNER PROFESSIONAL CENTER
39069 CENTER RIDGE RD.
NORTH RIDGEVILLE, OH. 44039
(440) 327-2925
FAX 327-2964

SURVEY FOR: TIMOTHY & GREGORY ABRAHAM

ORIG. LOT 41 & 56	CITY OF	DATE 9-2001 SCALE: 1"=200'
ORIG. SEC.	VILLAGE OF	DWN. BY TAS
TRACT	COUNTY OF LORAIN	JOB NO. 2000-030B
TOWNSHIP OF BROWNHELM	STATE OF OHIO	

DIMENSIONS SHOWN ON THIS PLAT ARE EXPRESSED IN FEET AND DECIMAL PARTS THEREOF. ALL BEARINGS ARE TO AN ASSUMED MERIDIAN AND ARE USED TO DESCRIBE ANGLES ONLY. PERMANENT MONUMENTS WERE FOUND OR SET AS INDICATED, ALL OF WHICH I CERTIFY TO BE CORRECT.

THOMAS A. SIMON
REG. PROFESSIONAL
SURVEYOR NO. S-7775

BASIS OF BEARINGS IS THE CENTERLINE OF RICE ROAD N. 67°49'12" W. IRON PIND SET AKE 5/8" DIA. 30" LONG WITH PLASTIC CAPS "T. SIMON S-7775".

STATE OF OHIO * THOMAS A. SIMON S-7775 REGISTERED PROFESSIONAL SURVEYOR

STATE OF OHIO * THOMAS A. SIMON S-7775 REGISTERED PROFESSIONAL SURVEYOR

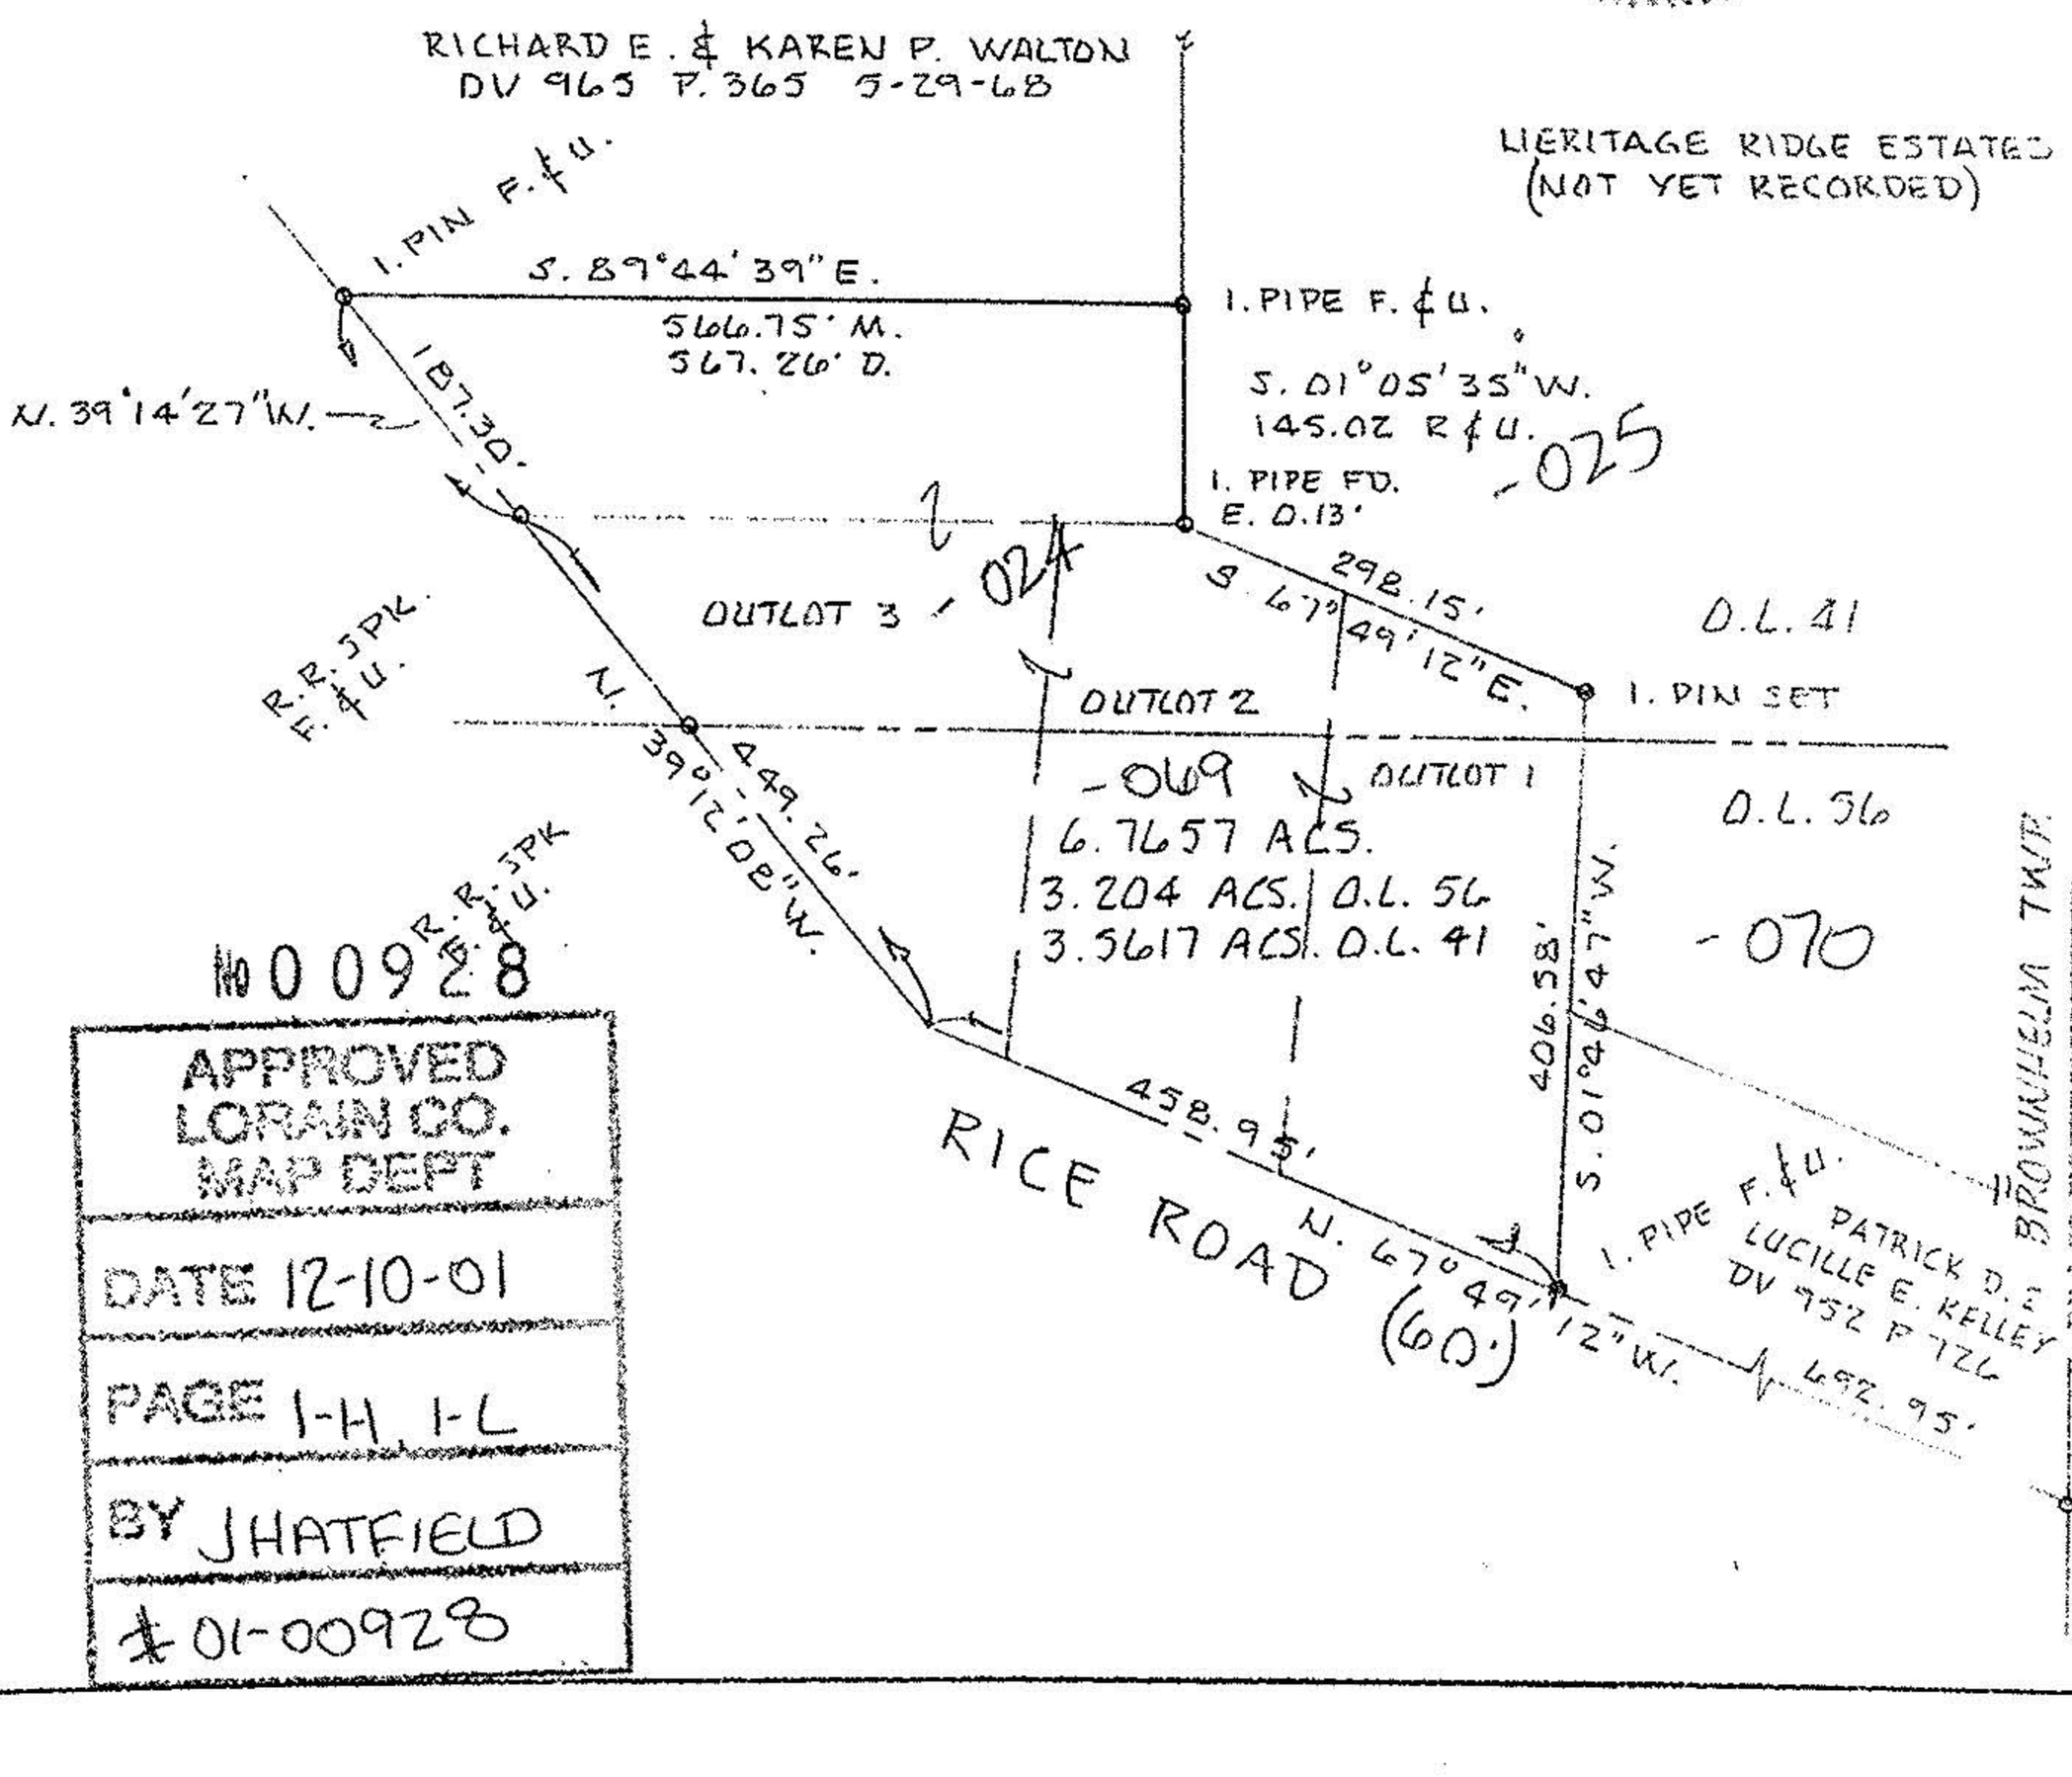

P.P.N 01-00-041-000-005, 01-00-056-000-046, 070-069-00-012, -013, -021, -029

#00928

APPROVED
LORAIN CO.
MAP DEPT

DATE 12-10-01

PAGE 1-H, 1-L

BY JHATFIELD

#01-00928