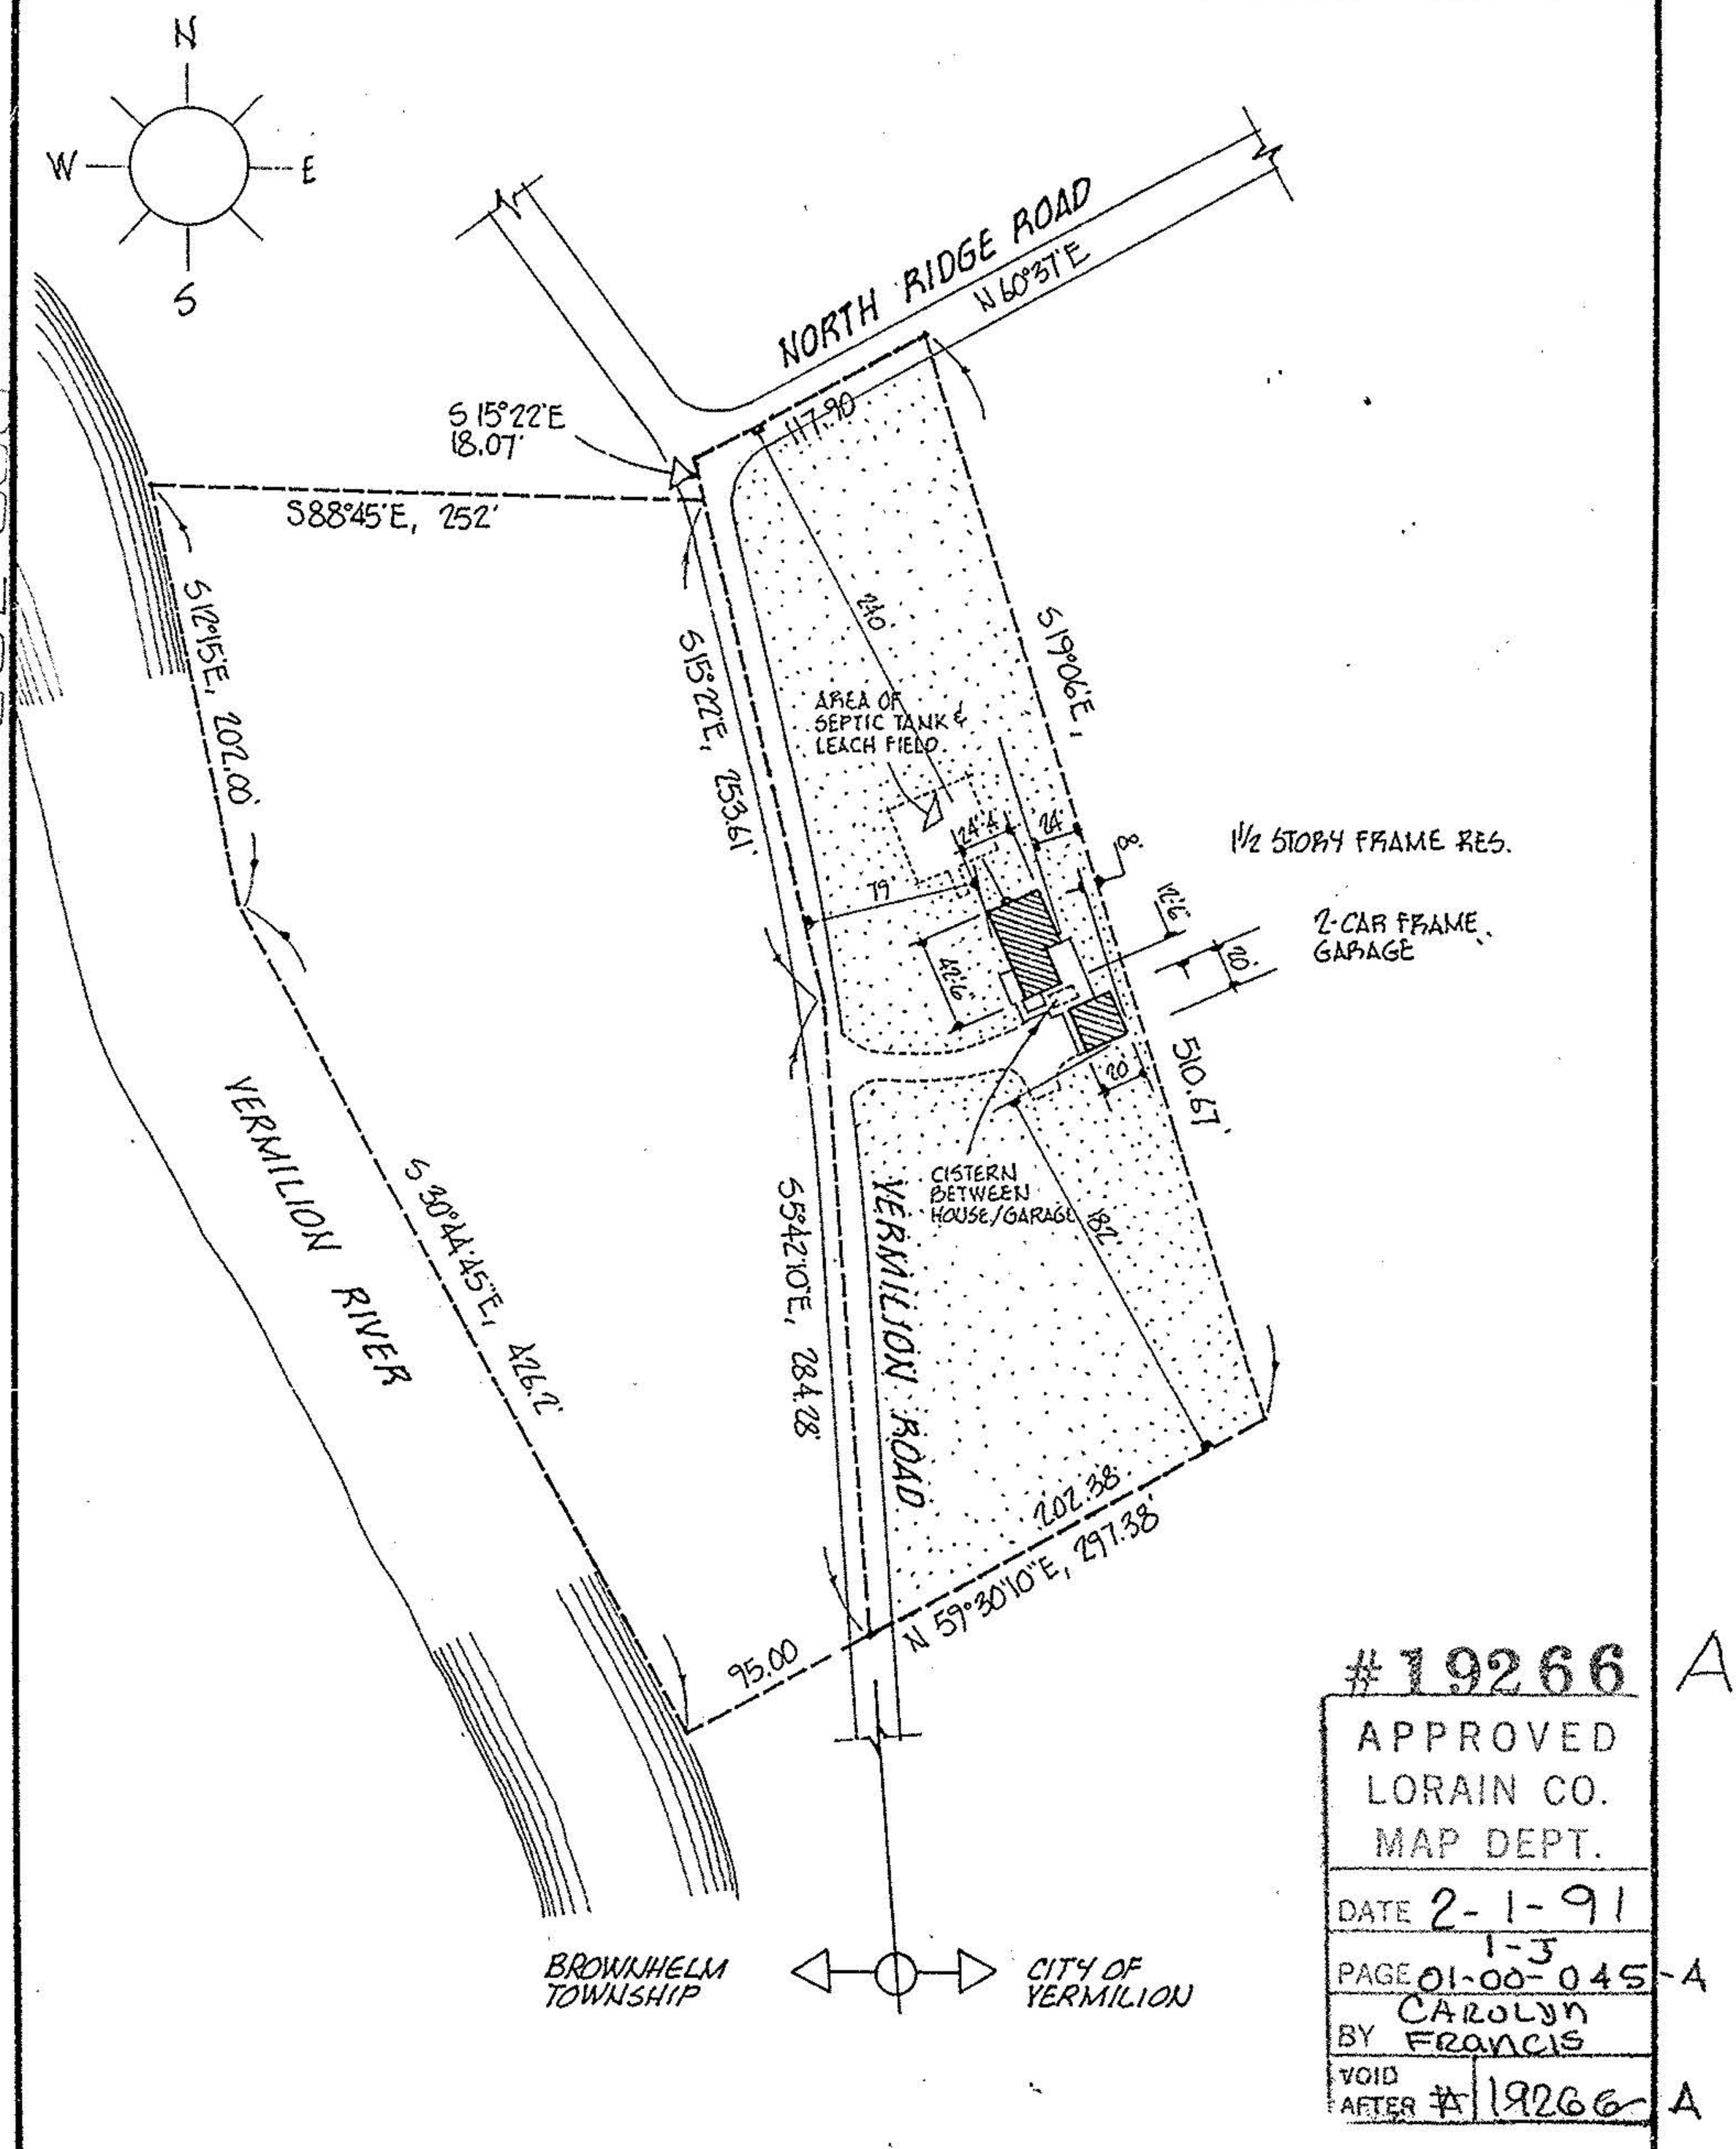

#19266 A

APPROVED
LORAIN CO.
MAP DEPT.

DATE 2-1-91

PAGE 01-00-045 1-3 -A

BY CAROLYN FRANCIS

VOID AFTER # 19266 A

ACREAGE	4.2948
DATE	OCT-90
DRAWN	MGH
SCALE	1" = 100 ft.

PREPARED FOR CHERNEY-HARTLE

MICHAEL G. HURA registered surveyor
12706 MASON ROAD, VERMILION, OHIO [216] 965-4040

PERIMETER SURVEY

SUBLOT _____ OF _____

_____ Volume ____ Page ____ of PLATS

PART OF O.L. 45-52 TRACT ____ SECTION _____ OF

BROWNHELM TOWNSHIP LORAIN CO., OHIO

Perm. Parcel No _____ Ref. deed:

CITY OF

STATE OF OHIO
MICHAEL G. HURA
No. 4712
REGISTERED SURVEYOR