


P.P.N  
 01-00-013-000-045  
 01-00-013-000-046

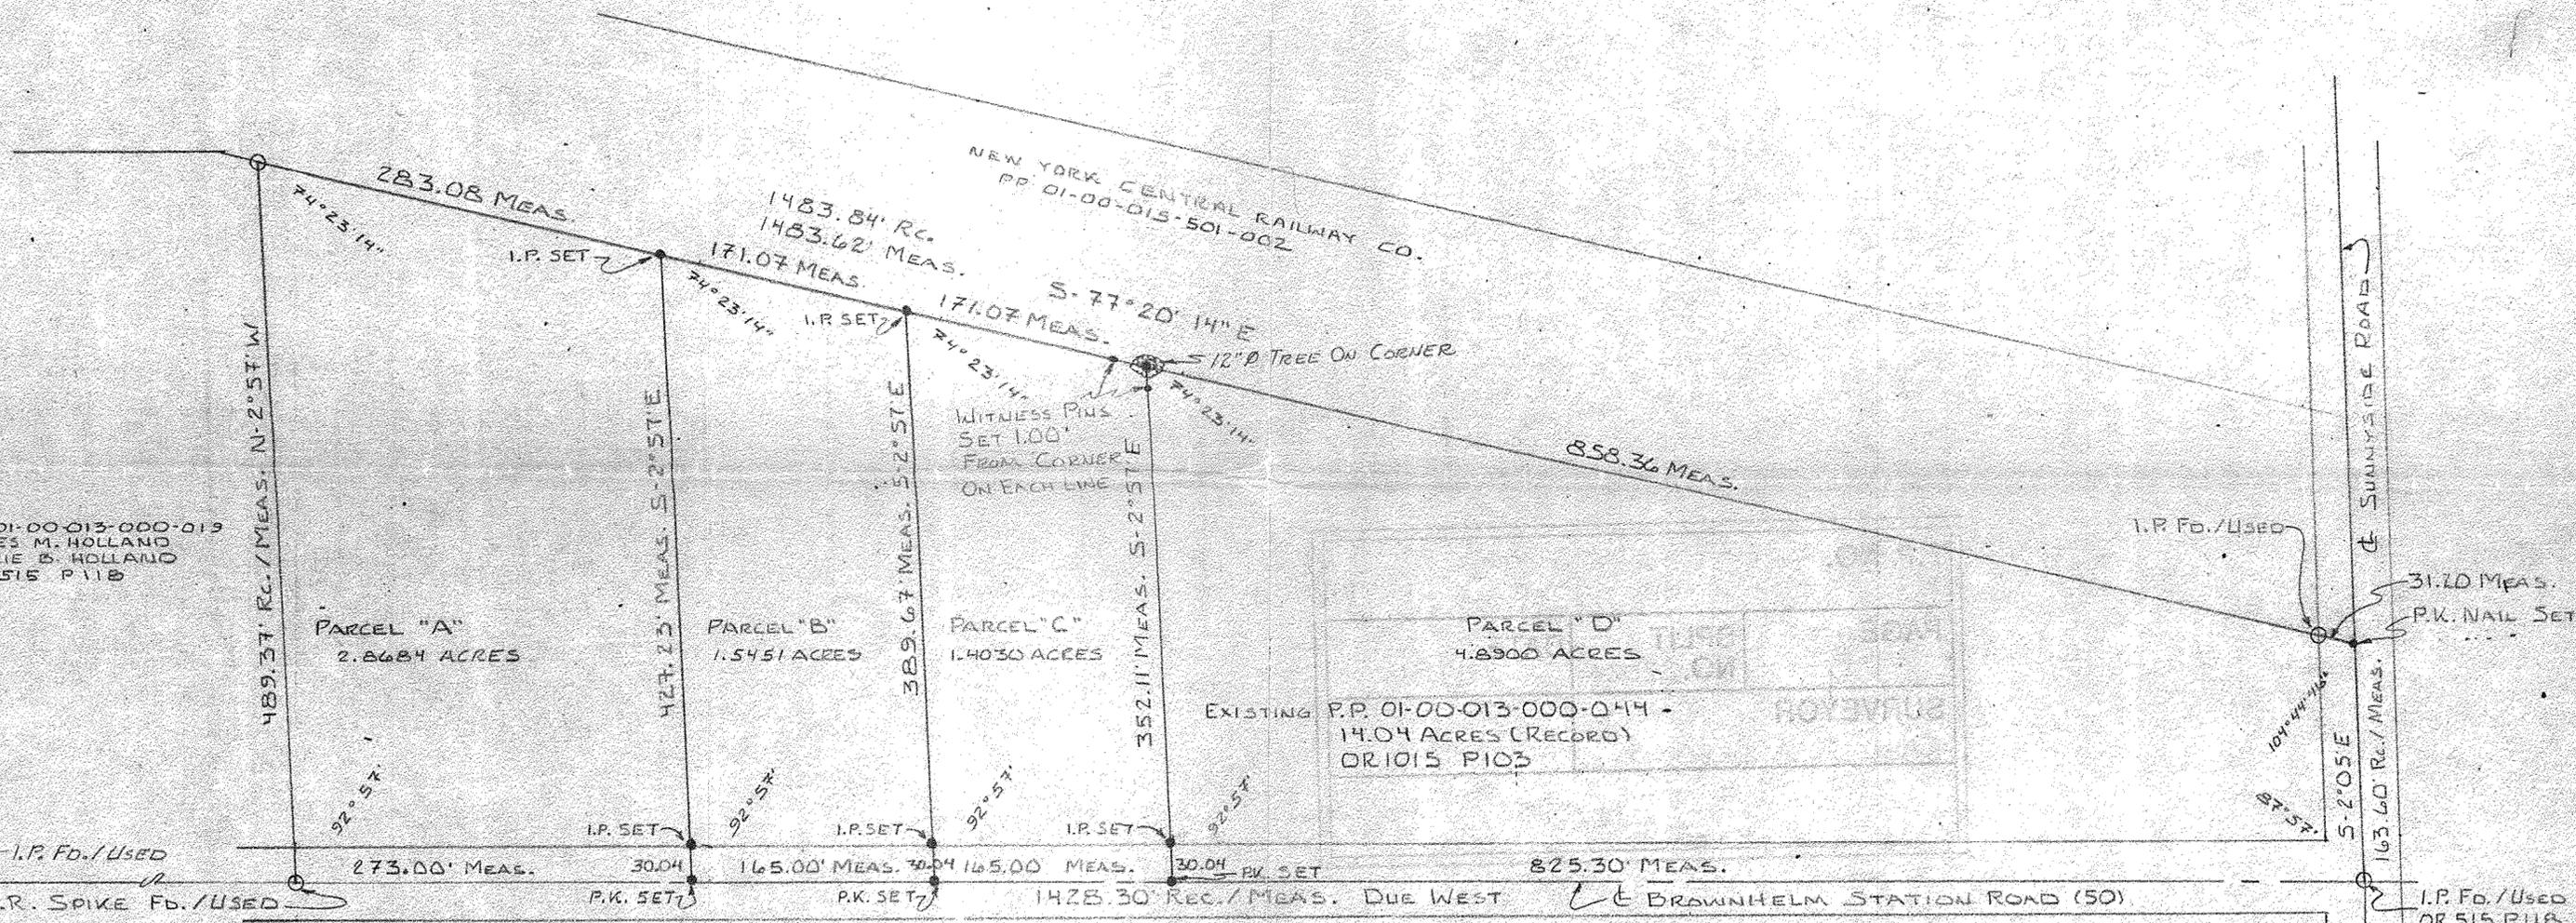

P.P. 01-00-013-000-019  
 JAMES M. HOLLAND  
 MARIE B. HOLLAND  
 OR 515 P118

I.P. Fd./USED  
 R.R. SPIKE Fd./USED



*Carl R. Anderson P.S.*

22024


APPROVED  
 LORAIN CO.  
 MAP DEPT.  
 DATE 12-30-96  
 PAGE 1-B  
 BY P. BELL  
 WORD # 22024

STATE OF OHIO  
 COUNTY OF LORAIN  
 CITY OF VERMILION  
 ORIGINAL BROWNHELM TOWNSHIP LOT 13

REFERENCE MATERIAL  
 TAX MAPS 1B AND 1F  
 OR 515 P118  
 OR 1015 P103  
 DV 1150 P321

RECORD ACRES = 14.04 ACRES  
 ACTUAL ACRES = 10.7065 ACRES

IRON PINS SET WERE 3/4" Ø REBAR \* 30" LONG  
 BEARINGS WERE ASSUMED.

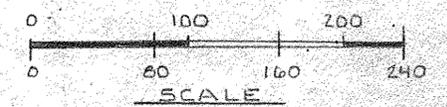

PREPARED BY CARL R. ANDERSON P.S. 866 SALEM AVE., ELYRIA, OHIO 44035-1824		
SCALE: AS NOTED	APPROVED BY	DRAWN BY CRA
DATE: 11-5-96		(216) 365-8104
PREPARED FOR JAMES M. AND MARIE B. HOLLAND		
SPLIT PARCEL 01-00-013-000-044		DRAWING NUMBER 765-96