


Comm. parcel

PPN 01-00-050-000-063

WILLIAM B. BARTON
Reg. Land Surveyor No. 4438
188 PARKWOOD AVENUE
AVON LAKE, OHIO 44012
TELEPHONE (216) 933-6662

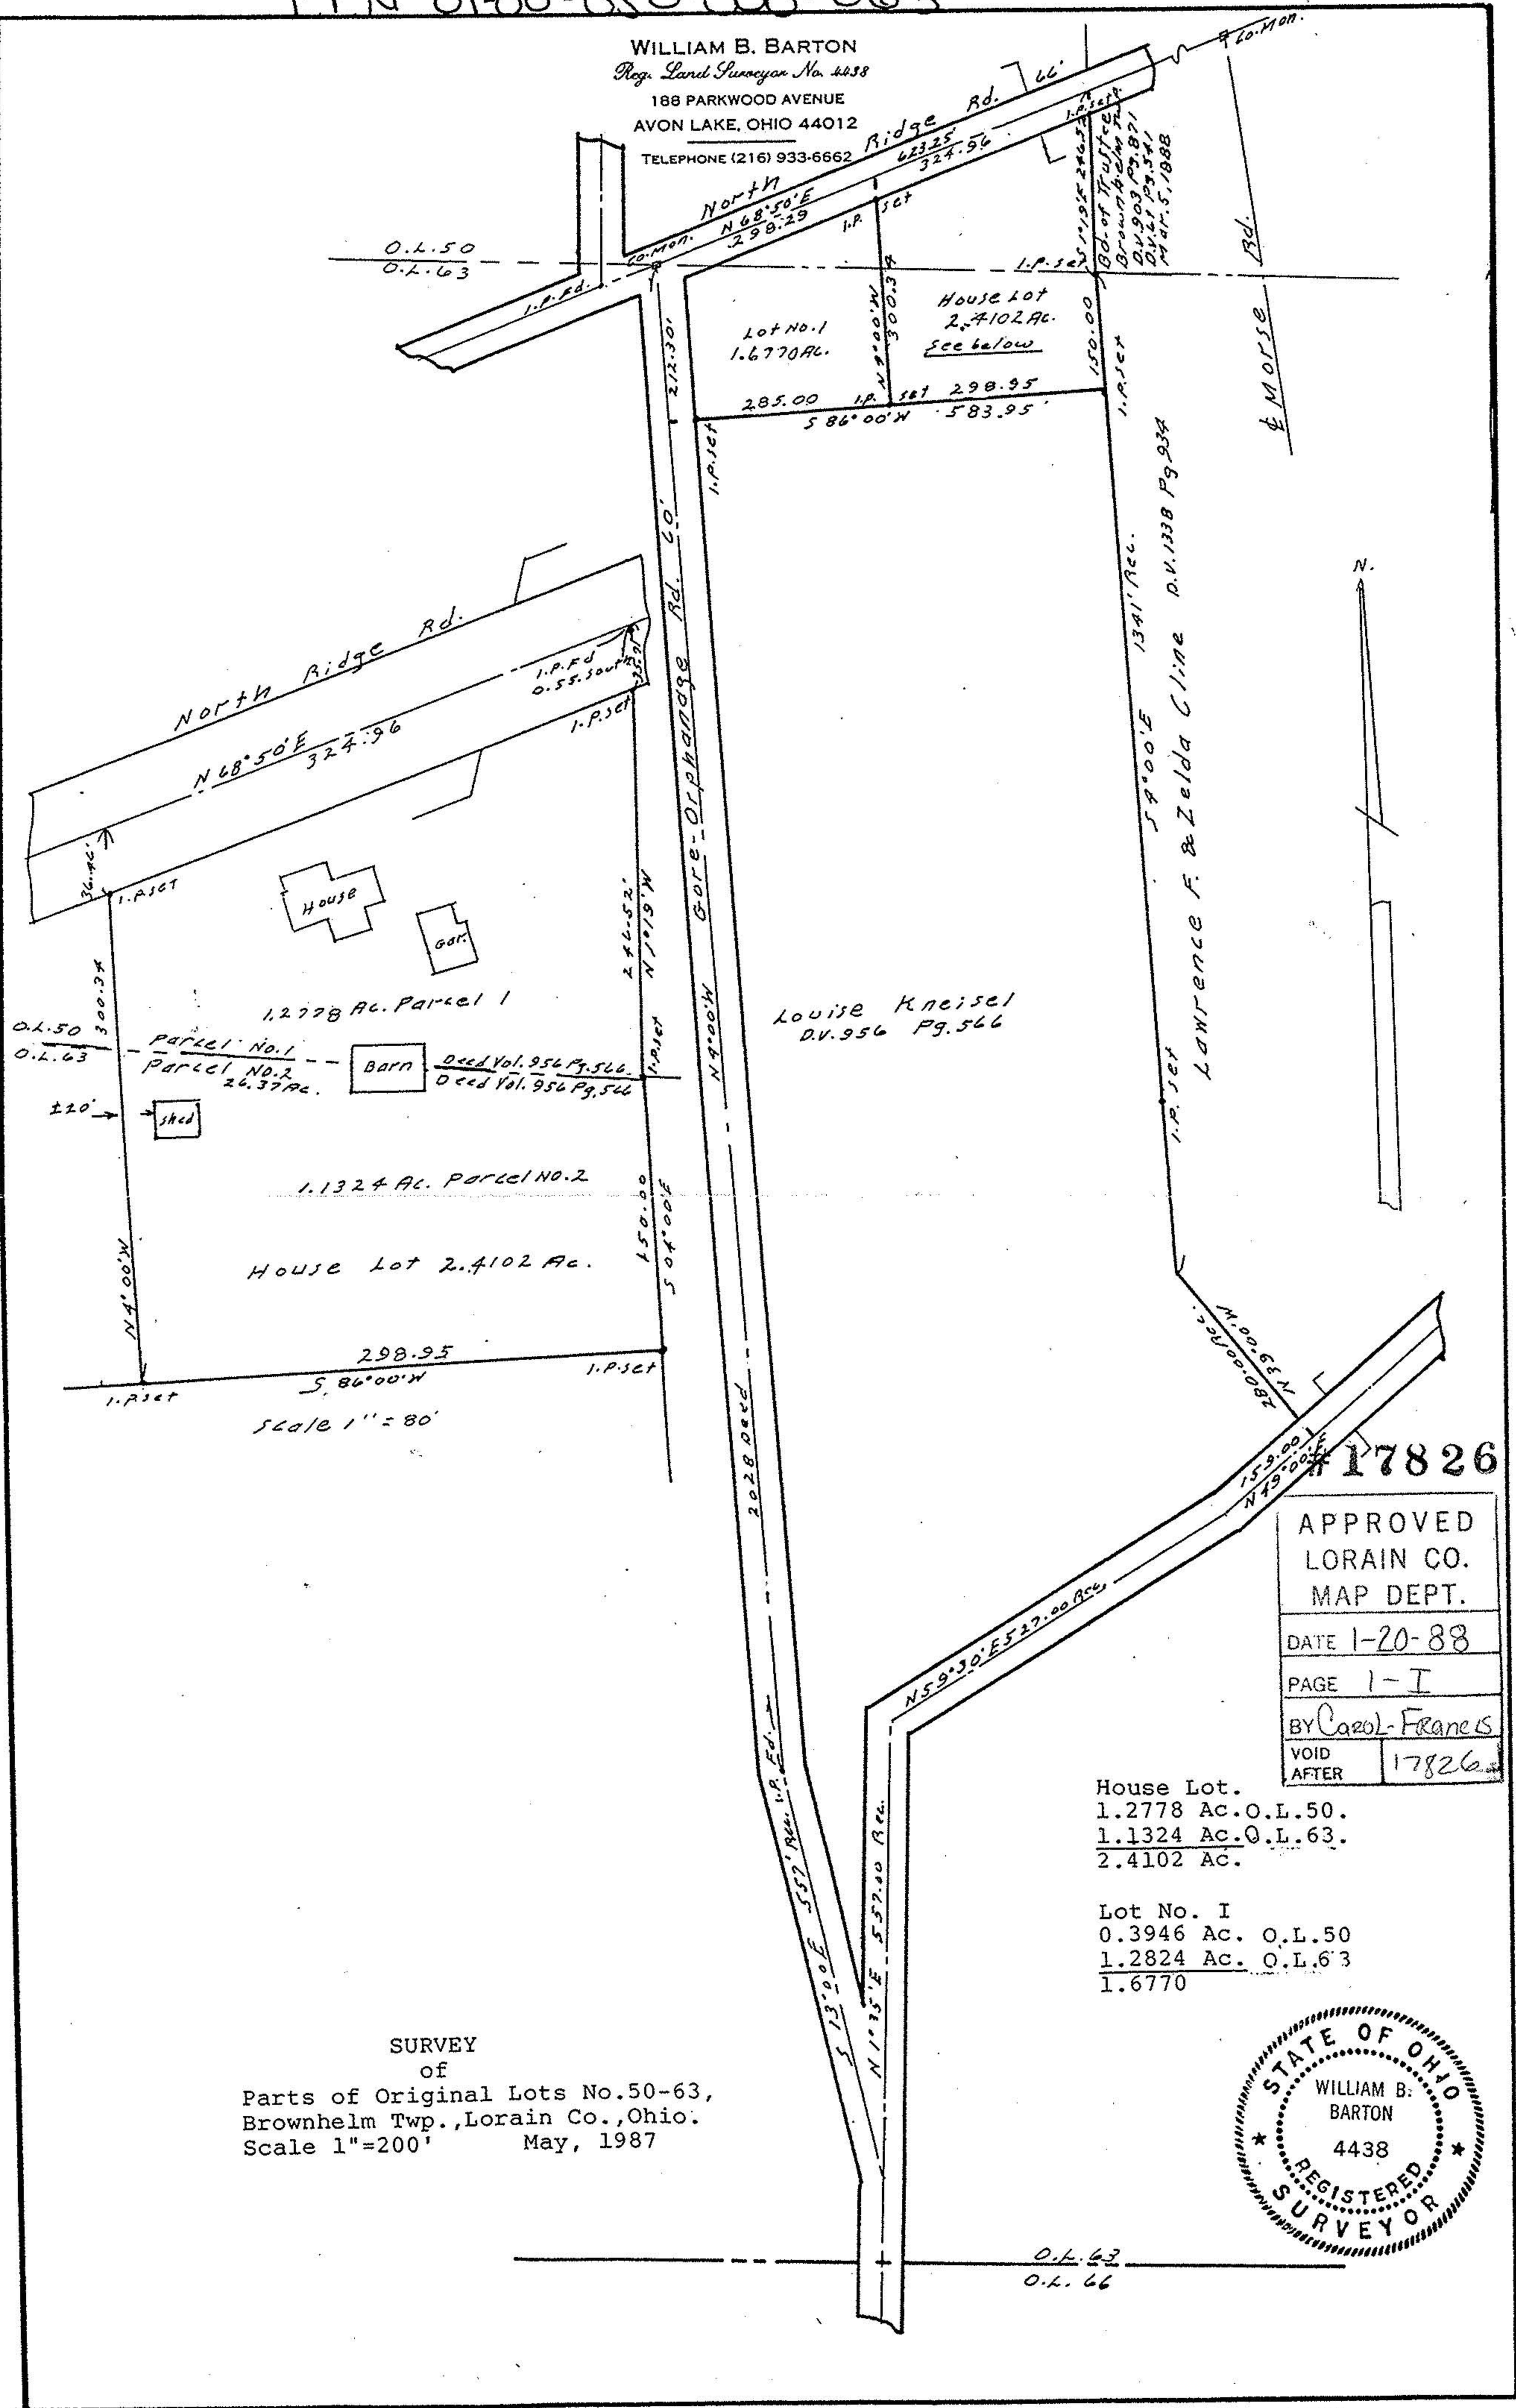

SURVEY
of
Parts of Original Lots No. 50-63,
Brownhelm Twp., Lorain Co., Ohio.
Scale 1"=200' May, 1987

Louise Kneisel
D.V. 956 Pg. 566

APPROVED
LORAIN CO.
MAP DEPT.
DATE 1-20-88
PAGE 1-I
BY Carol Francis
VOID AFTER 17826

House Lot.
1.2778 Ac. O.L. 50.
1.1324 Ac. O.L. 63.
2.4102 Ac.

Lot No. I
0.3946 Ac. O.L. 50
1.2824 Ac. O.L. 63
1.6770



O.L. 63
O.L. 66

