LAUNDON . SIMON . CAHL & ASSOC. INC.
CONSULTING ENGINEERS & SURVEYORS
219 COURT ST. ELYRIA, OHIO 44035

SURVEY FOR:

ZARAGOZA & ELIA H. MARTINEZ

Orig. Lot 55	City of	Date 5-2-88 Scale 1" = 60'
Orig. Sec	Village of	Dwn. by R.G.S. Chkd. by C.J.
Tract	County of LORAIN	Job No. 88-1705 F.B.
Township of BROWNHELM	State of OHIO	Printed

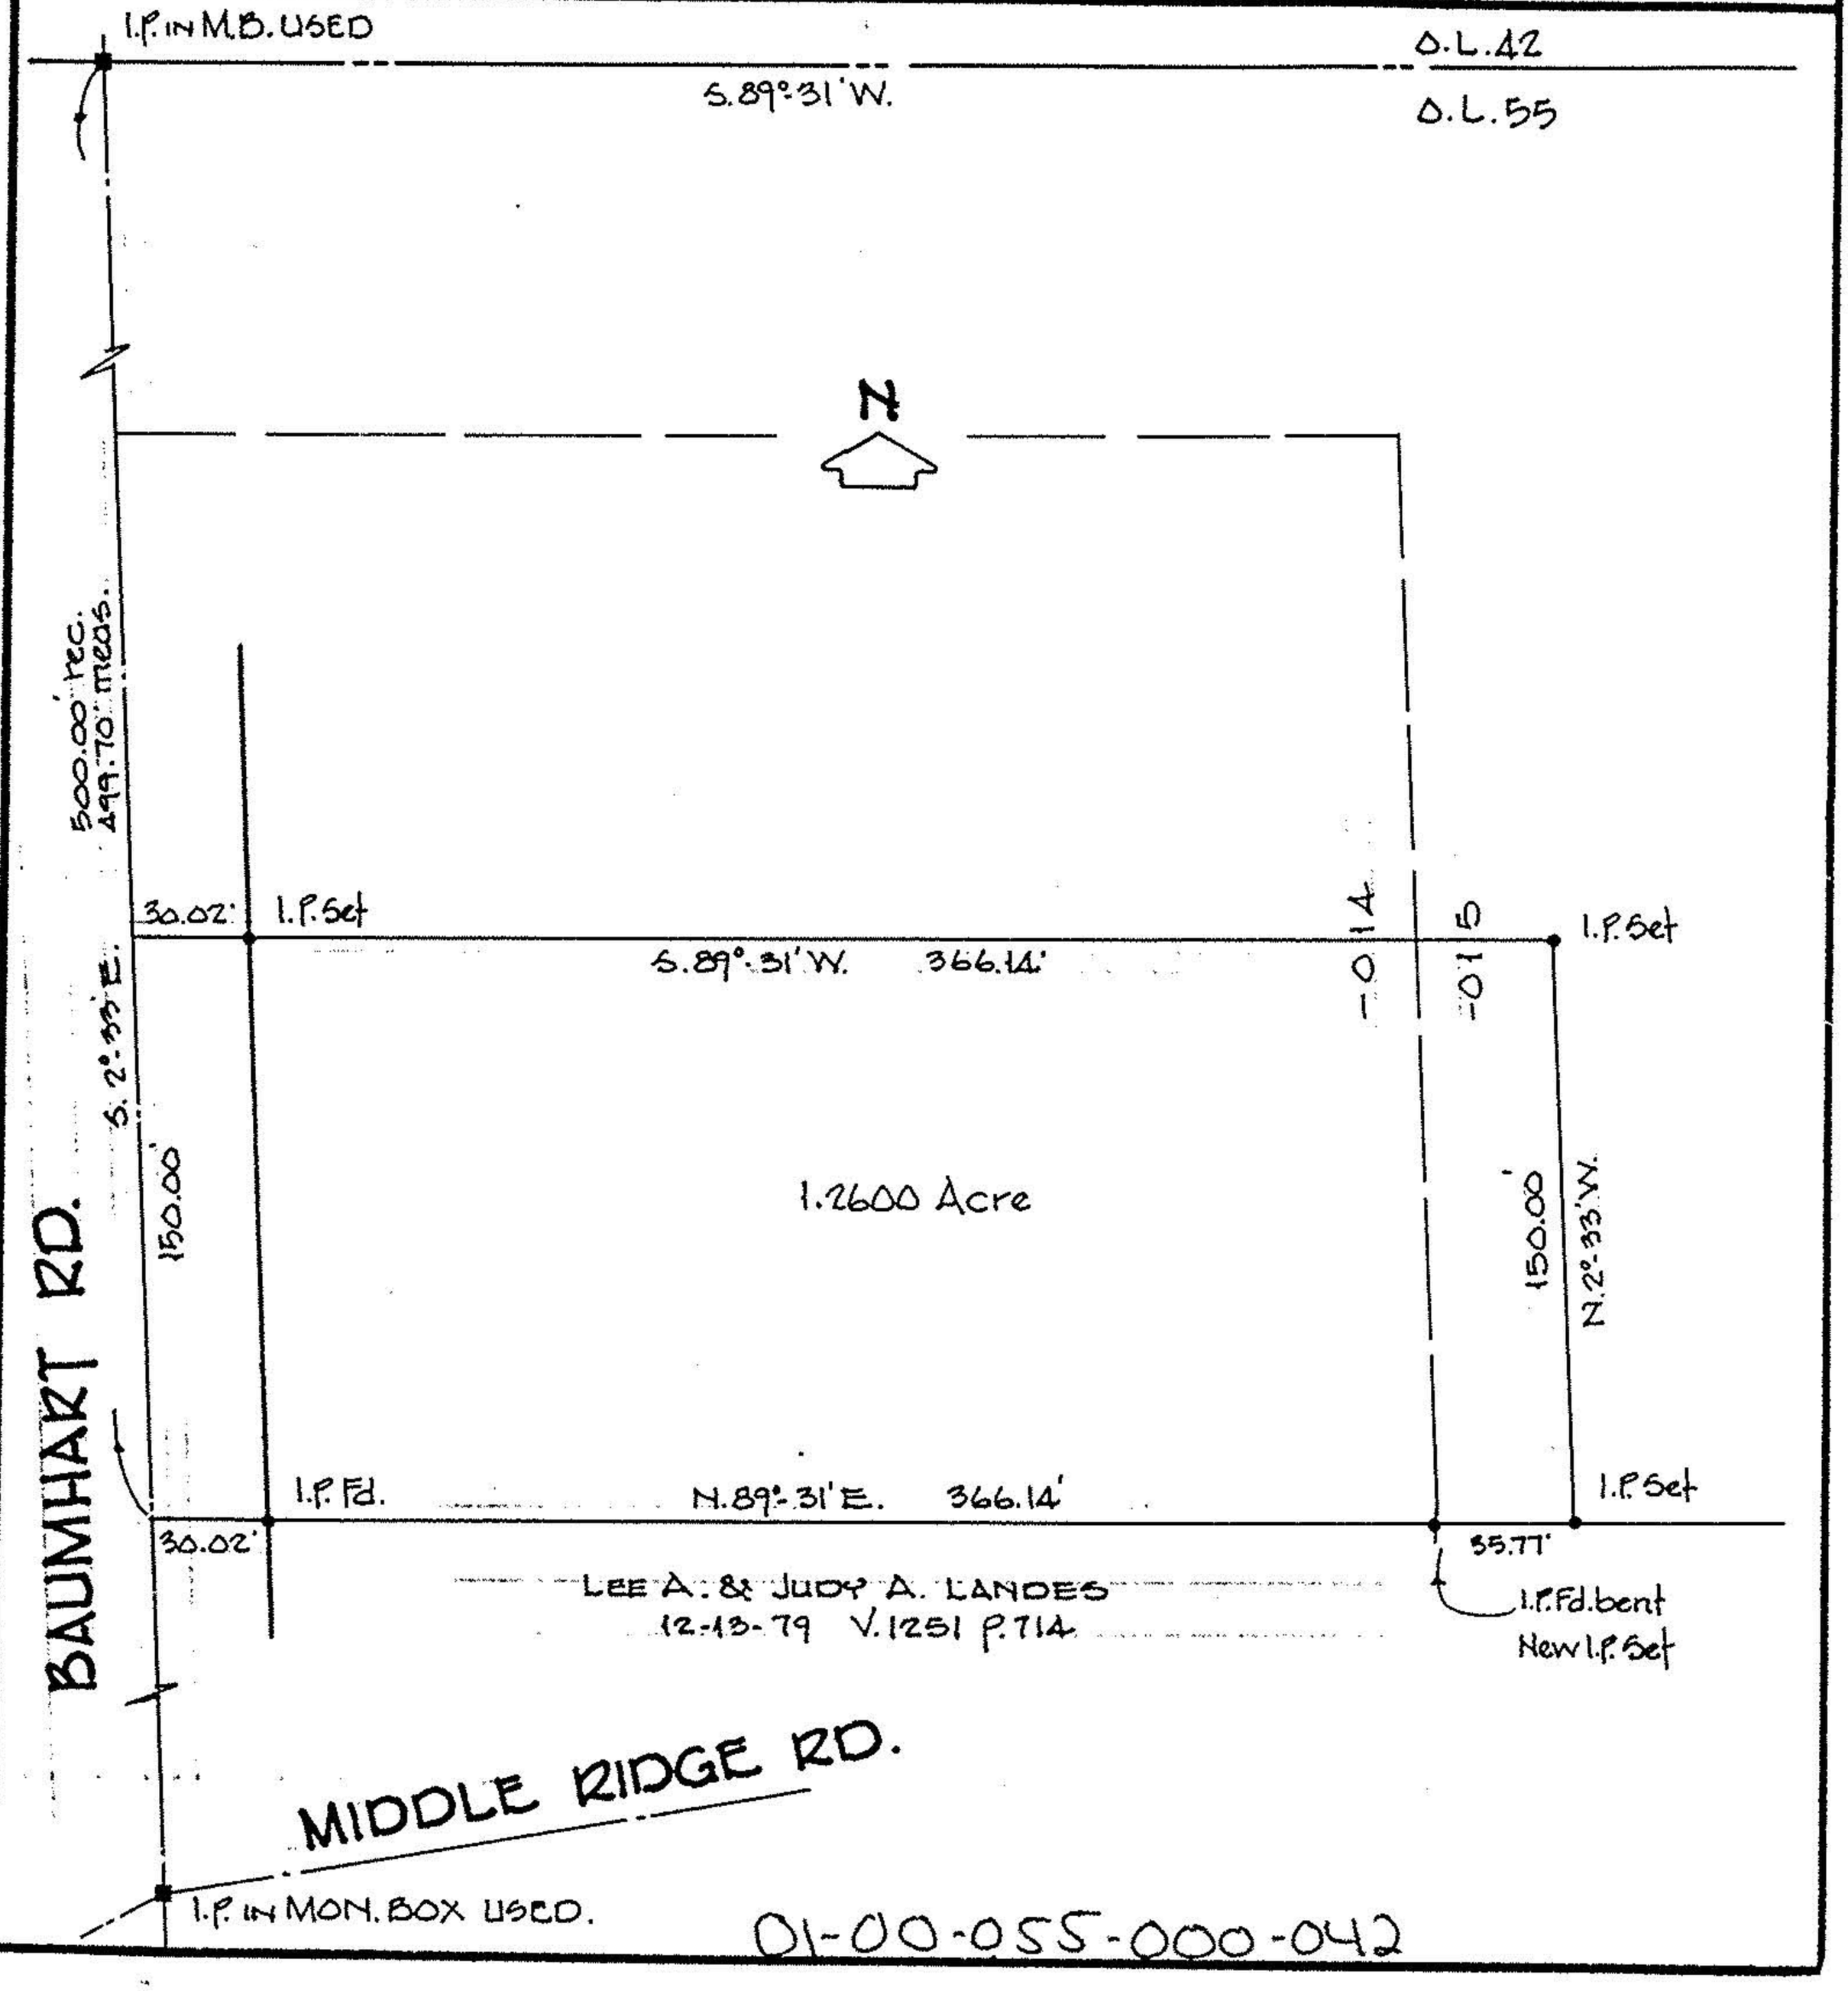

01-00-055-000-042