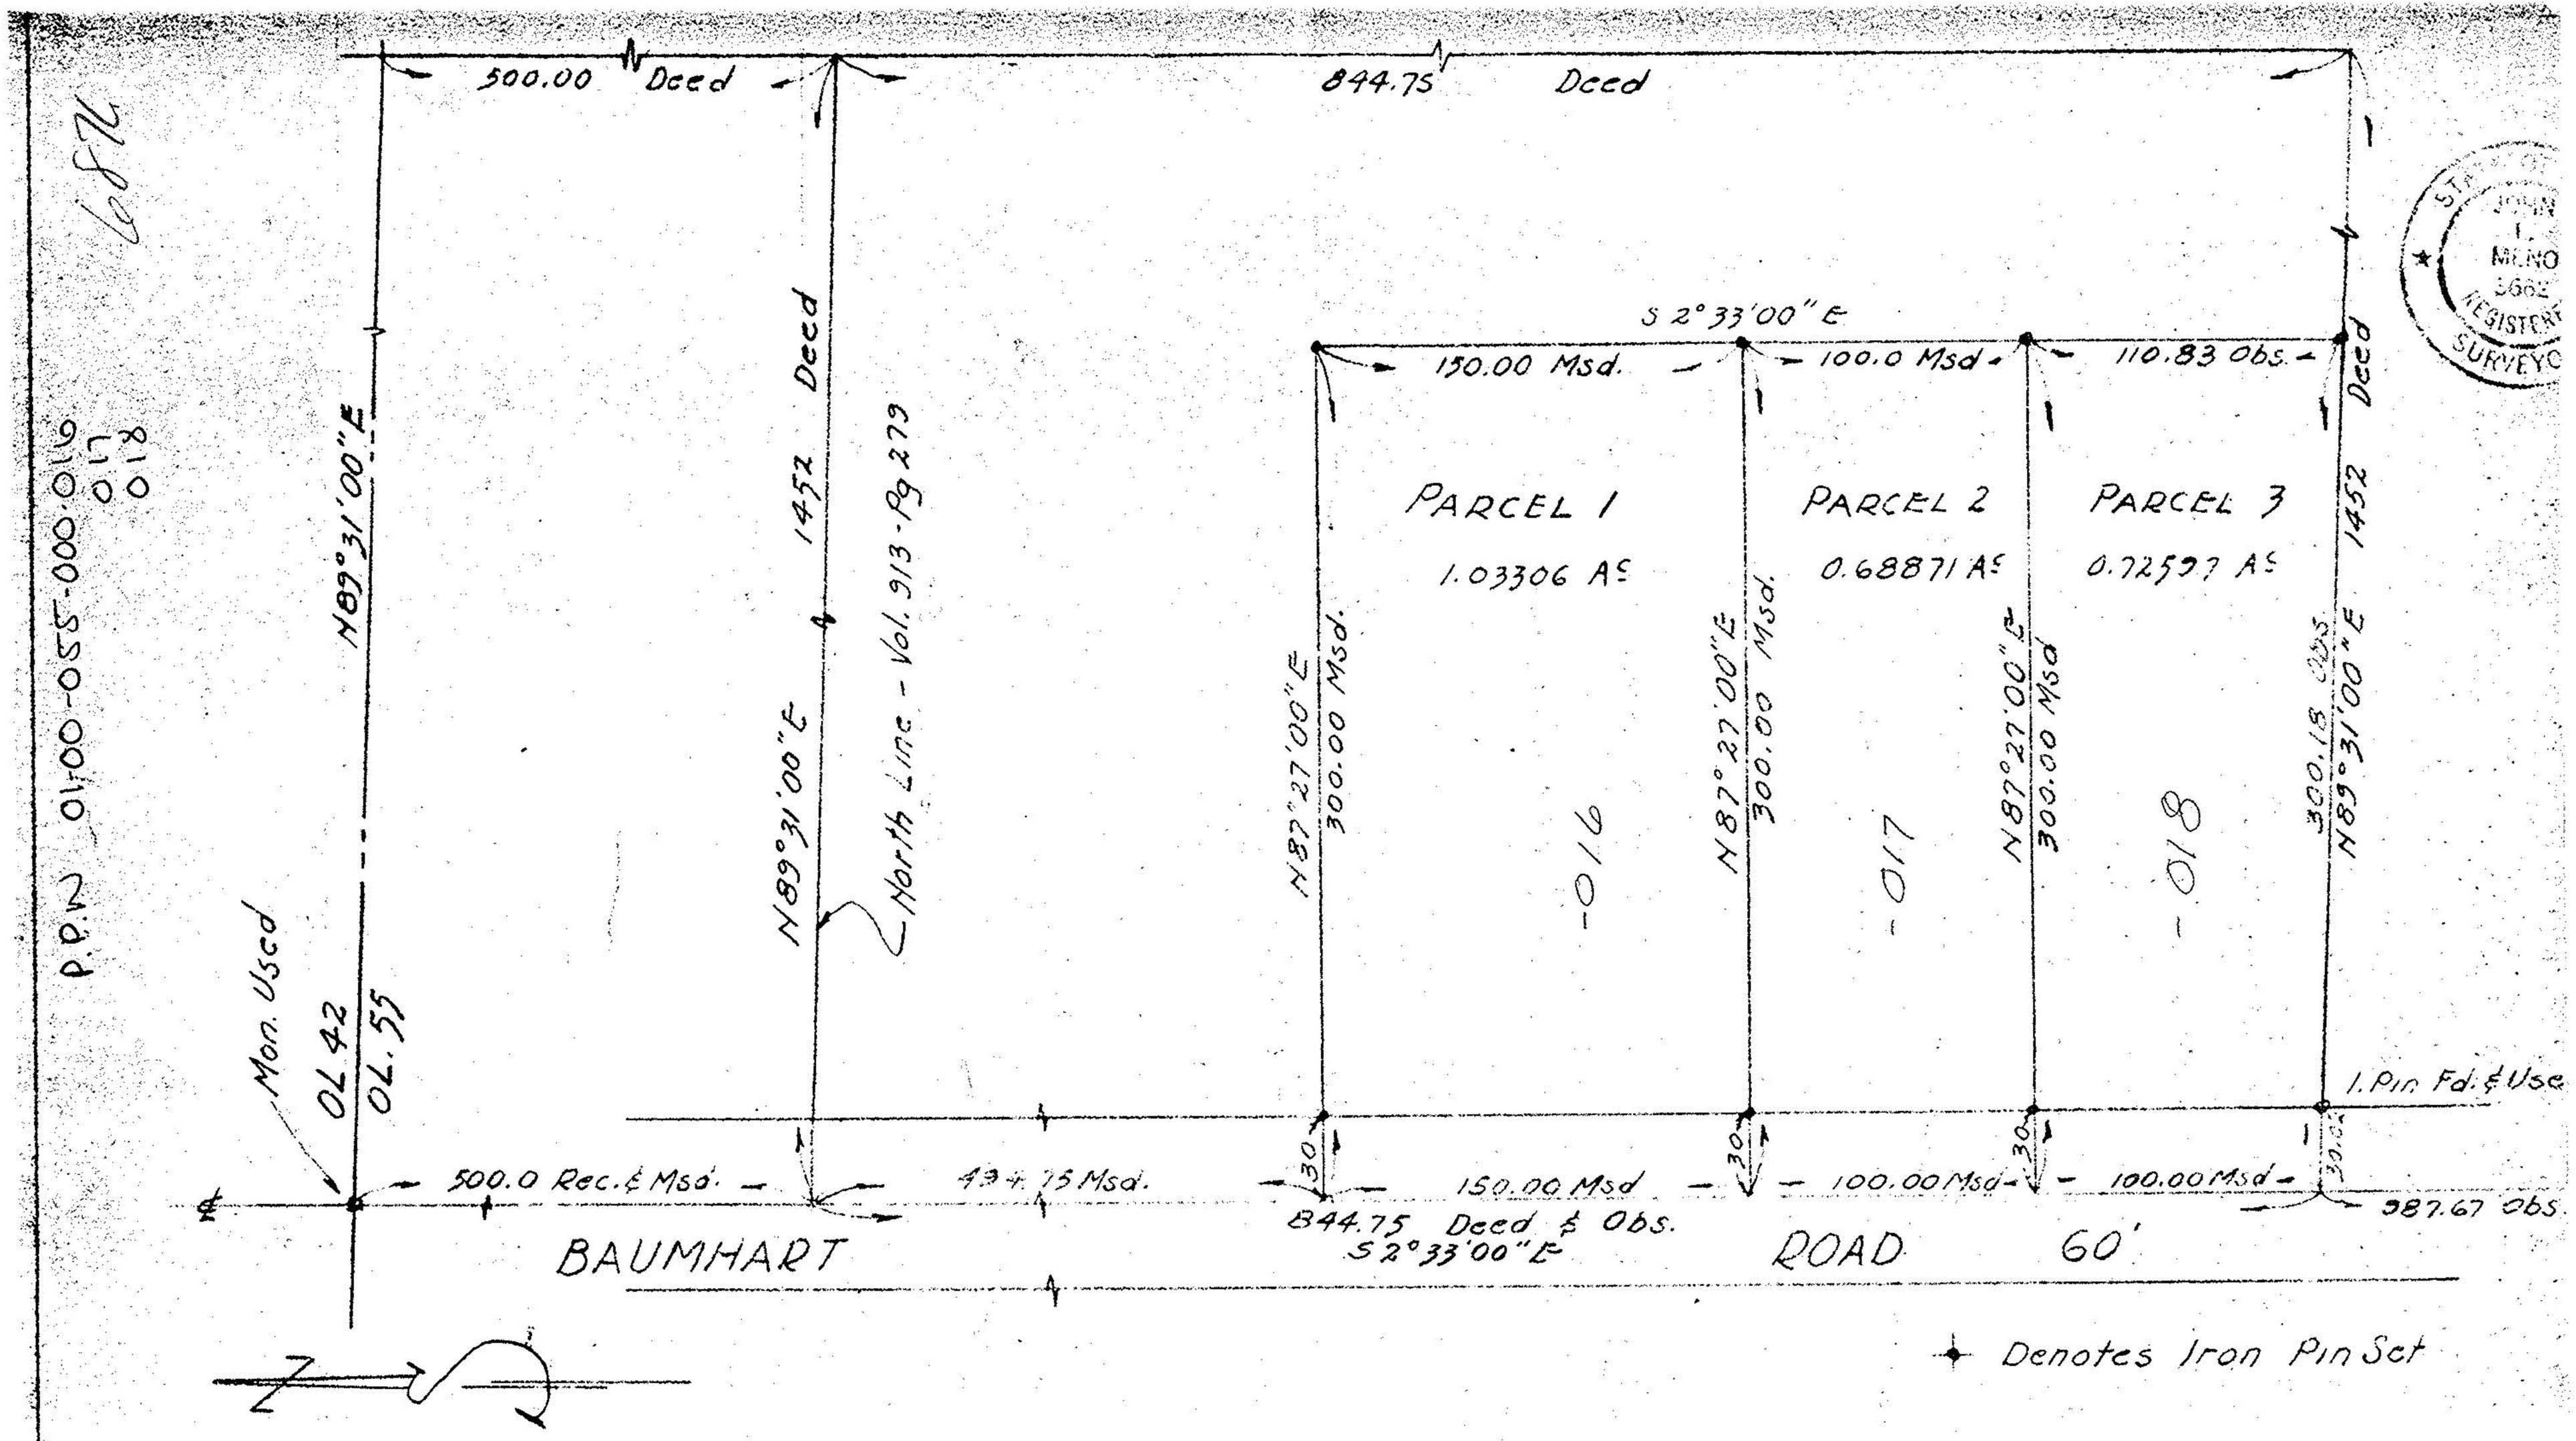

BROWNHELM TWP

ENGINEERS AND SURVEYORS
4370 OBERLIN AVE.
LORAIN, OHIO

ORIGINAL LOT	55	DATE	3-22-73
CITY OF		FIELD BOOK	120 [illegible]
COUNTY OF	Lorain	DRAWN BY	
STATE OF	OHIO	CHECKED BY	JFR
W. O.	1942	FILE NO.	1-55