
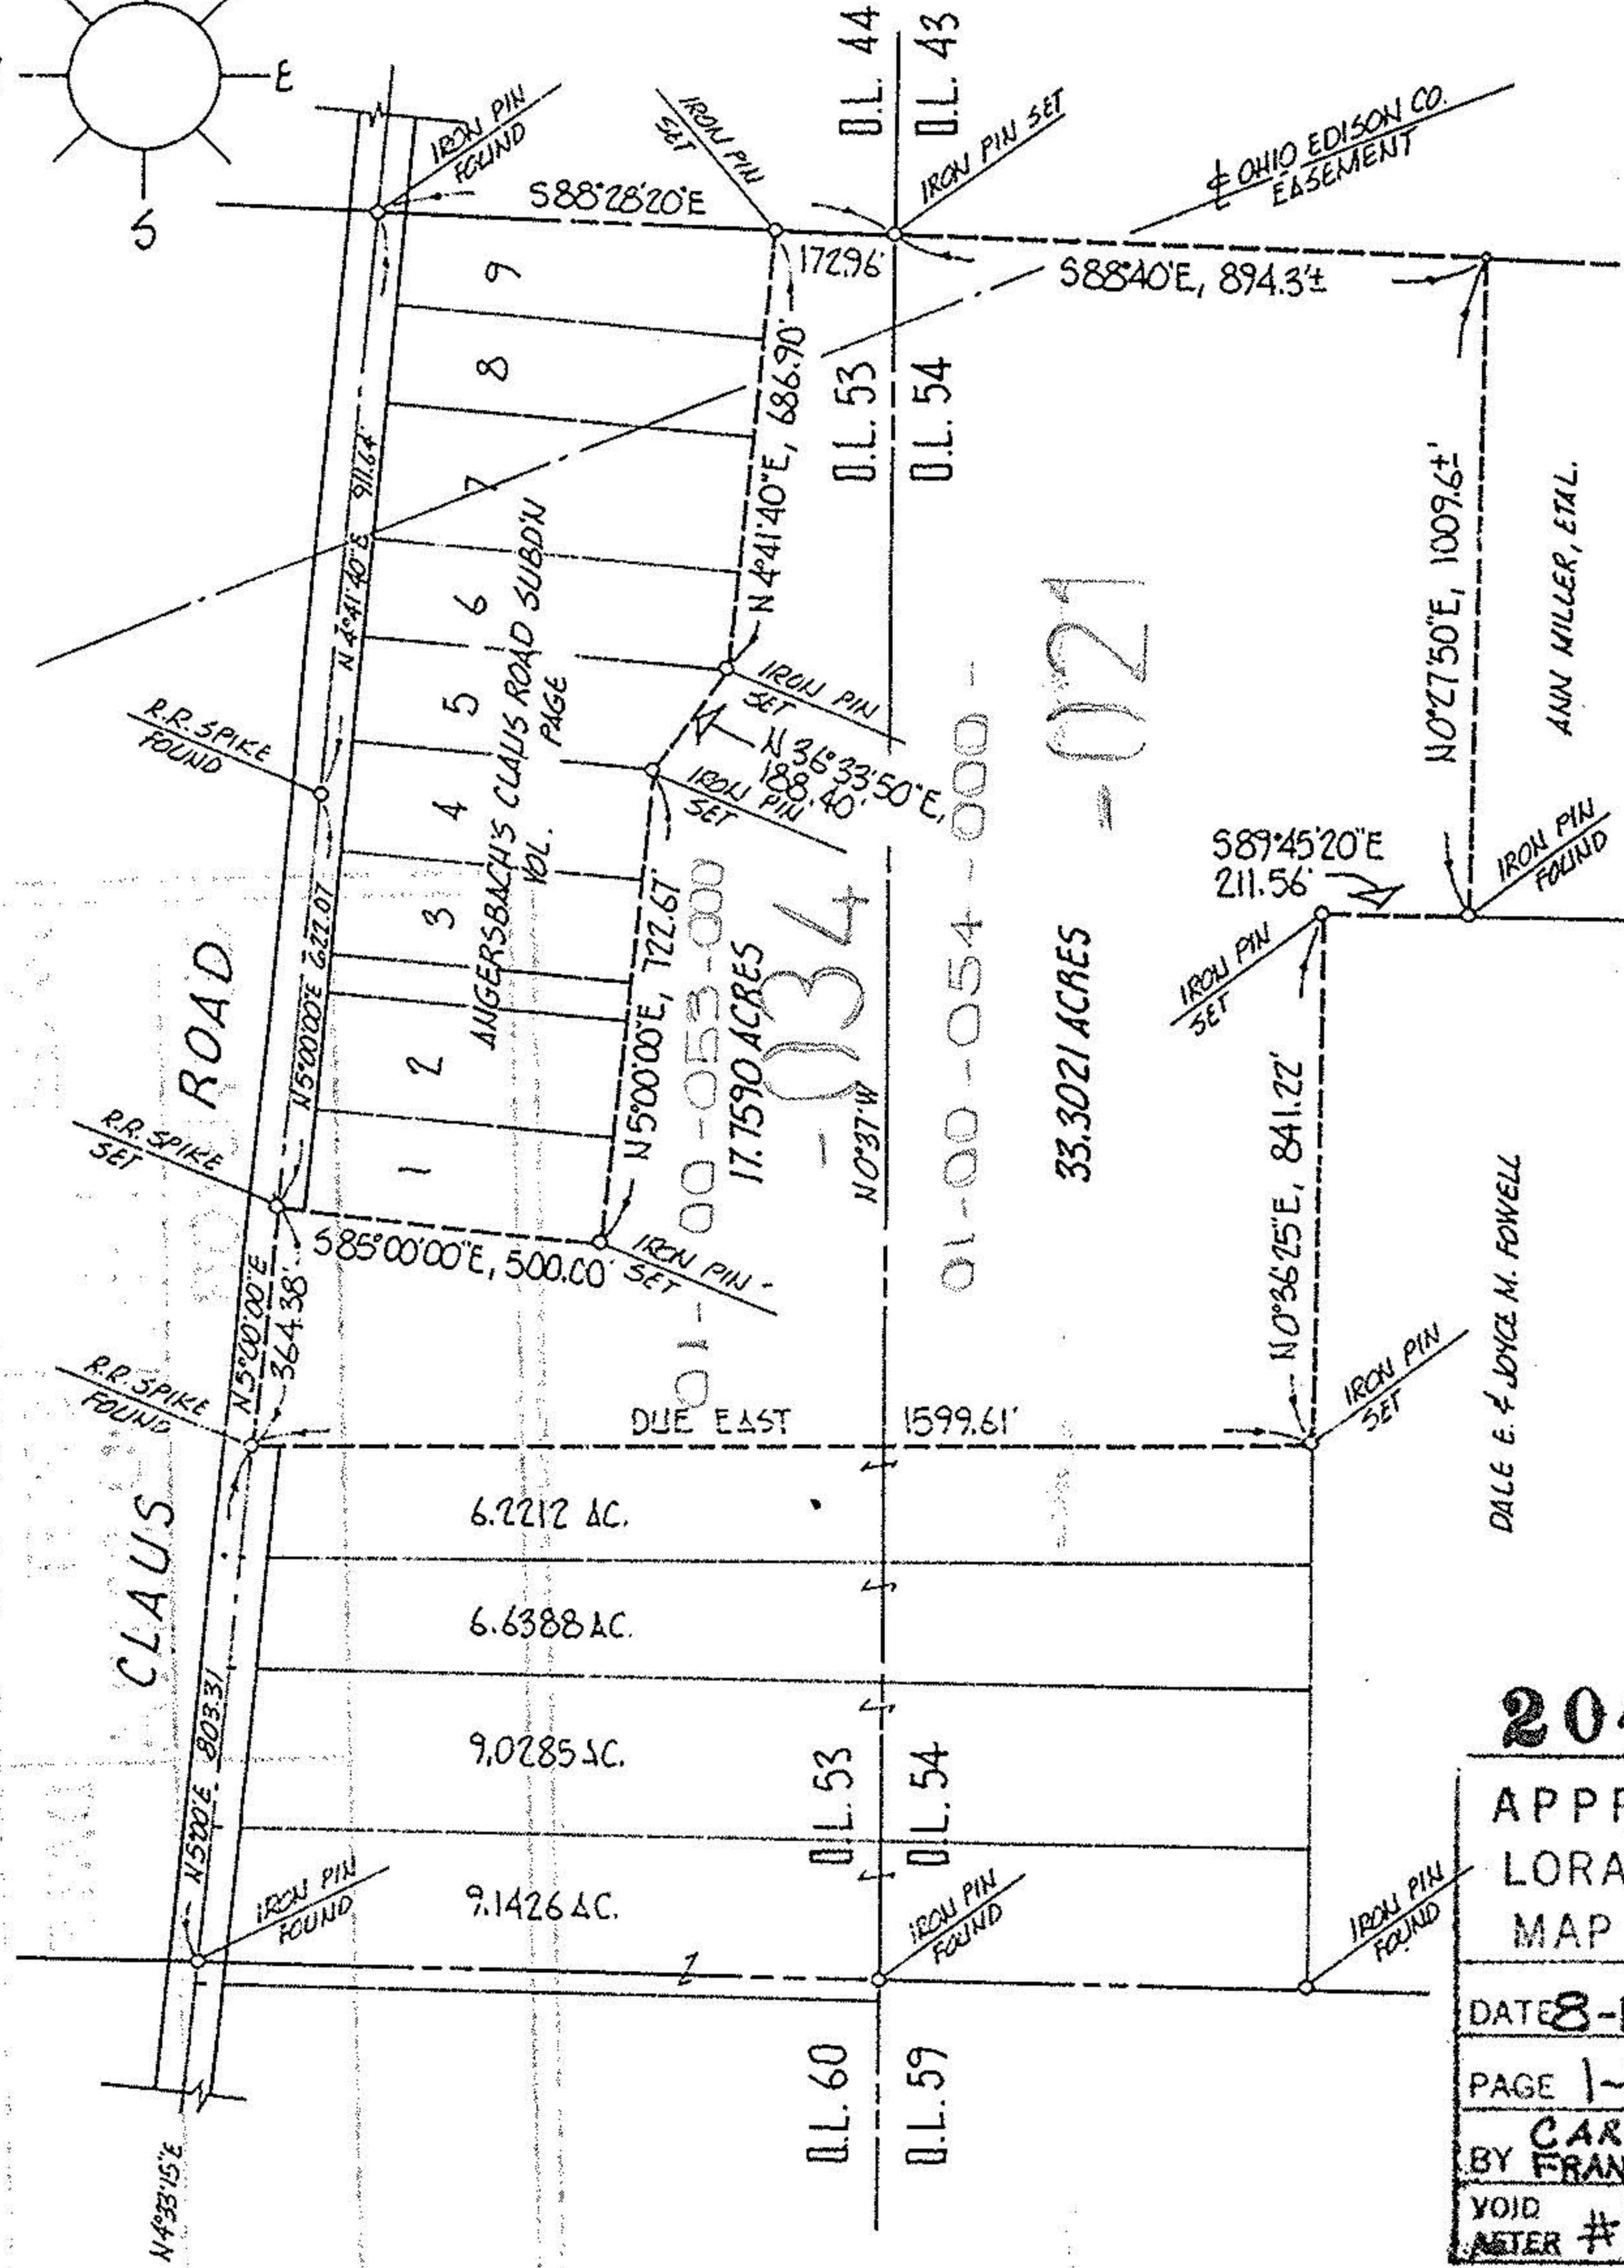


01-00-053-000-034
 P.P.N. 01-00-054-000-021

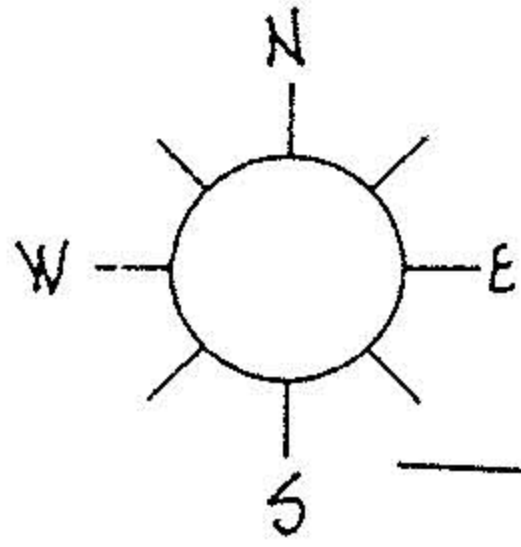

01-00-053-000-034
 17.7590 ACRES
 01-00-054-000-021
 33.3021 ACRES

20417A
 APPROVED
 LORAIN CO.
 MAP DEPT.
 DATE 8-12-93
 PAGE 1-K
 BY CAROLYN FRANCIS
 VOID AFTER # 20417A

acreage 51.0611
 date JUL-93
 drawn MGH
 scale 1"=400'

prepared for ANGERSBACH / COURY

MICHAEL G. HURA, REGISTERED SURVEYOR
 12706 Mason Road, Vermilion Ohio (216)965-4040



PERIMETER SURVEY

SUBLOT(S) _____ OF _____
 _____ Volume _____ Page _____ of PLATS
 PART of O.L. 53 & 54 Tract _____ Section _____ of
BROWNHelm TOWNSHIP LORAIN CO., OHIO

City of
 Village of