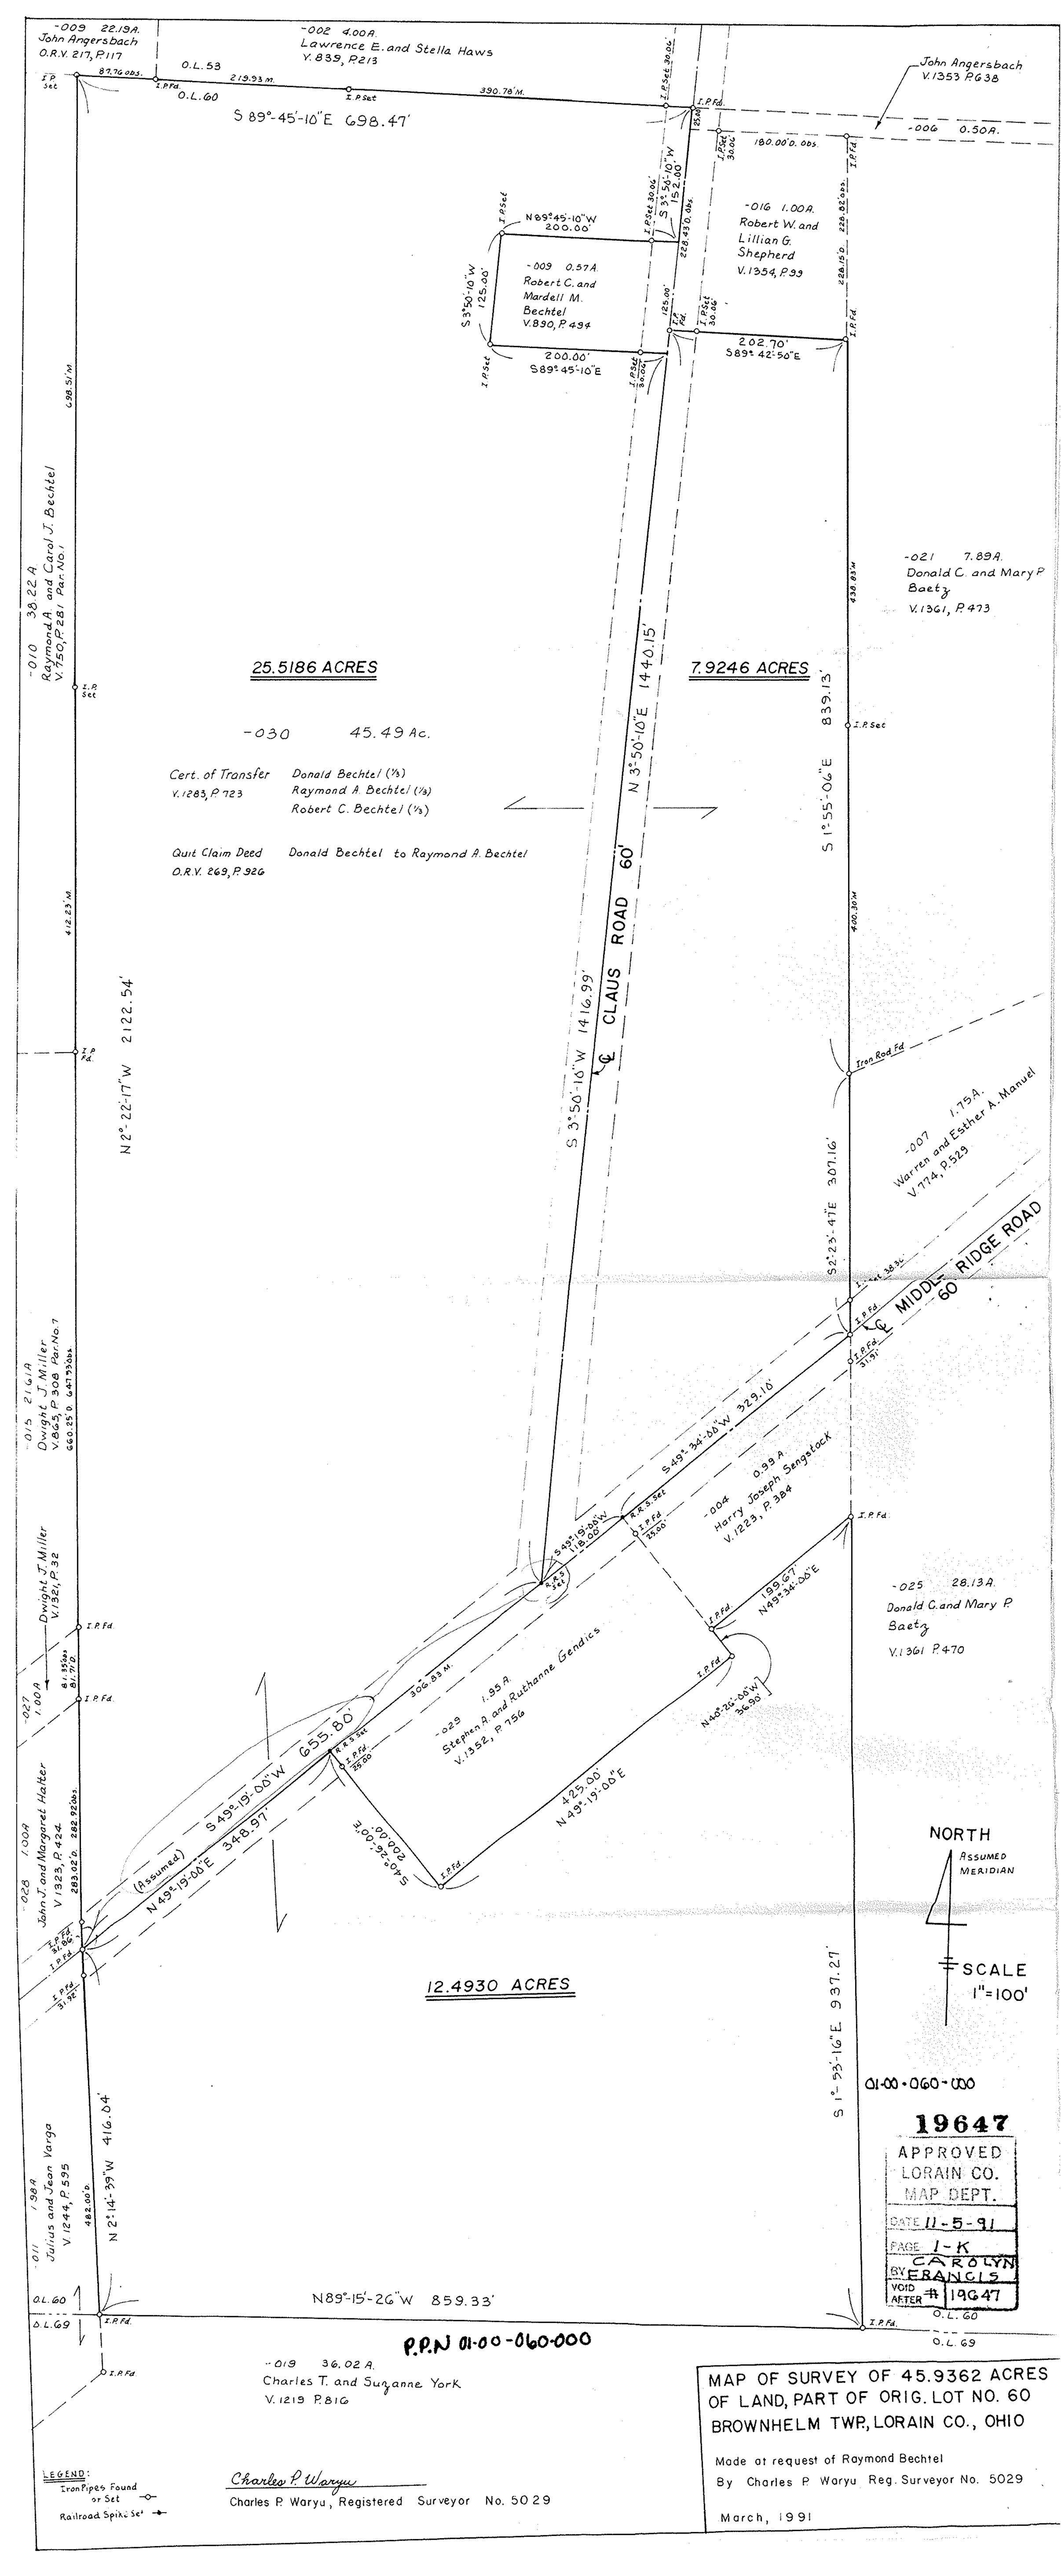

MAP OF SURVEY OF 45.9362 ACRES OF LAND, PART OF ORIG. LOT NO. 60 BROWNHELM TWP., LORAIN CO., OHIO

Made at request of Raymond Bechtel

By Charles P. Waryu Reg. Surveyor No. 5029

March, 1991