


WILLIAM B. BARTON
 Reg. Land Surveyor No. 4438
 188 PARKWOOD AVENUE
 AVON LAKE, OHIO 44012
 TELEPHONE (216) 933-6662

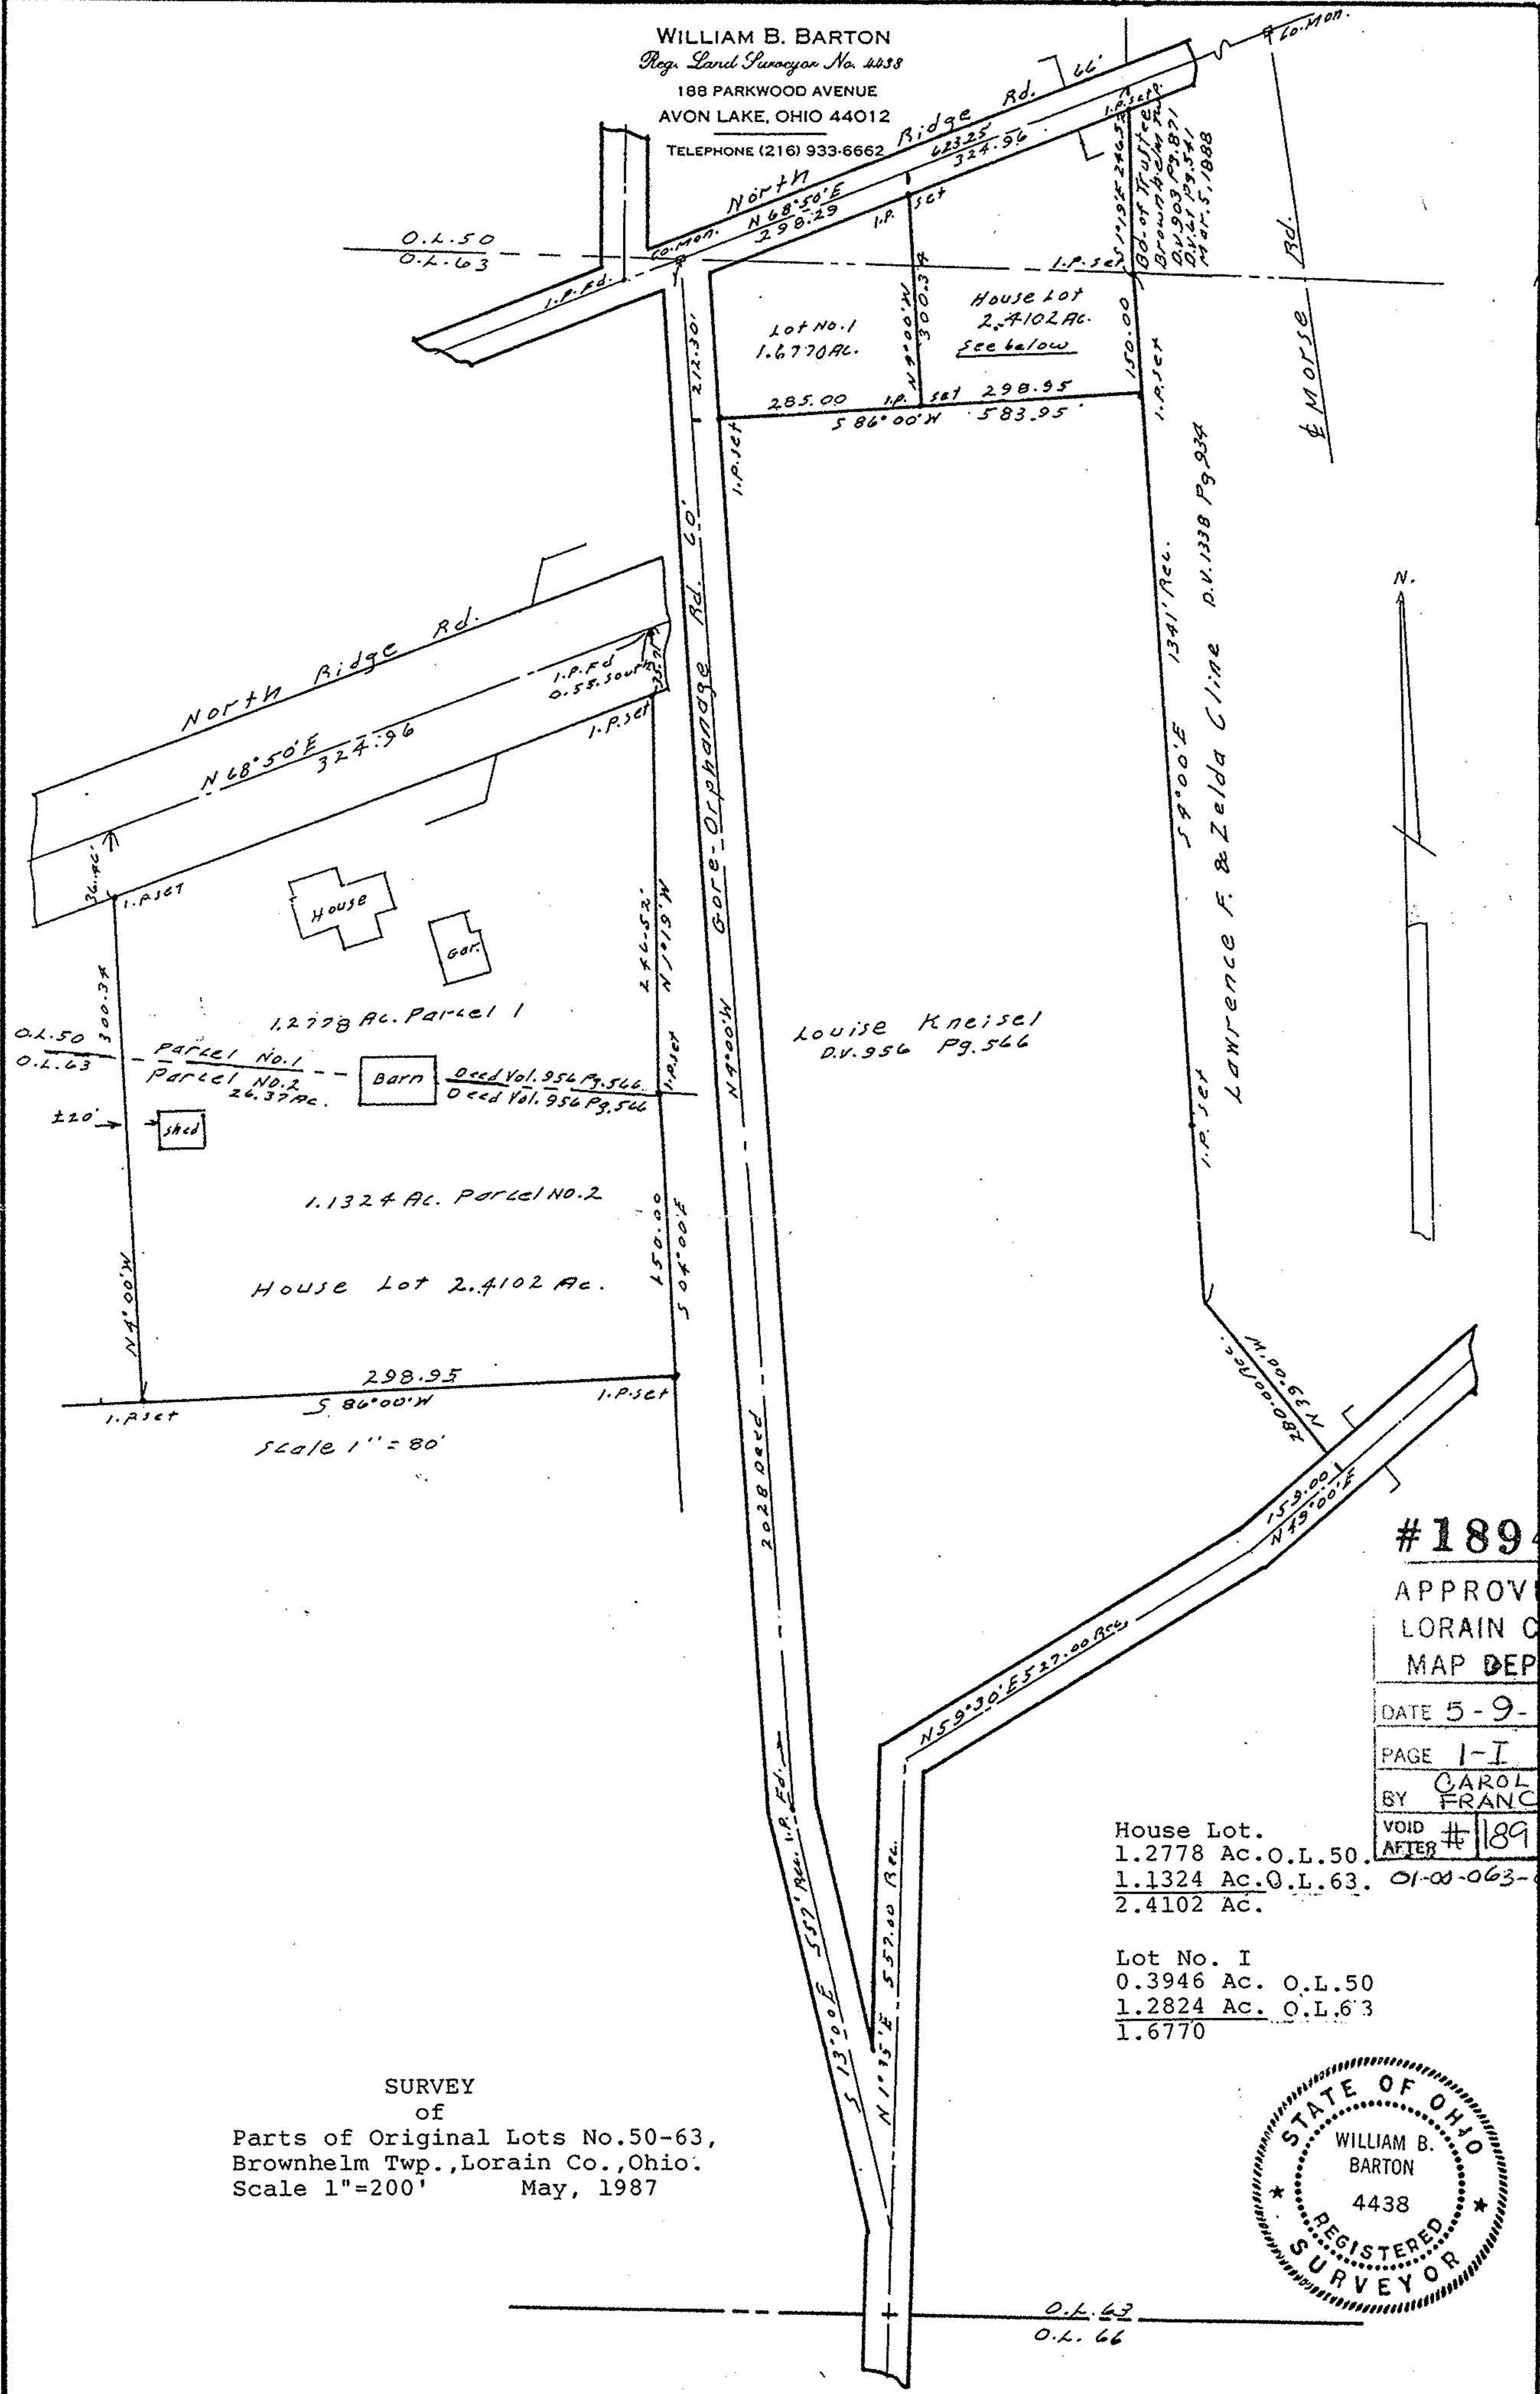

Louise Kneisel
 D.V. 956 Pg. 566

SURVEY
 of
 Parts of Original Lots No. 50-63,
 Brownhelm Twp., Lorain Co., Ohio.
 Scale 1"=200' May, 1987

#18944
 APPROVED
 LORAIN CO.
 MAP DEPT.
 DATE 5-9-90
 PAGE 1-I
 BY CAROLYN
 FRANCIS
 VOID
 AFTER #18944

House Lot.
 1.2778 Ac. O.L. 50.
 1.1324 Ac. O.L. 63.
 2.4102 Ac.

Lot No. I
 0.3946 Ac. O.L. 50
 1.2824 Ac. O.L. 63
 1.6770



O.L. 63
 O.L. 66