

01-00-064-000-042

SP. 24
D.L. 64

JOHN H. JENSEN
MAY 12, 1906
VOL. 93 P. 21

358.5'

100'

150'

115'

FR. SHED

280'

FR. SHED
BLOCK SHED
69'

242'

260'

FR. SHED

24'

140'

680.48'

NORTH RIDGE ROAD

ACRES 11.259 ±

-043 § 042

532.98'

SEE
DETAIL

40'

100'

637.40'


11540



North

649.46'

APPROVED
TERRAIN CO.
MAP DEPT.
DATE 4-10-78
PAGE I-I
BY C. J. [Signature]
VOID AFTER 11540

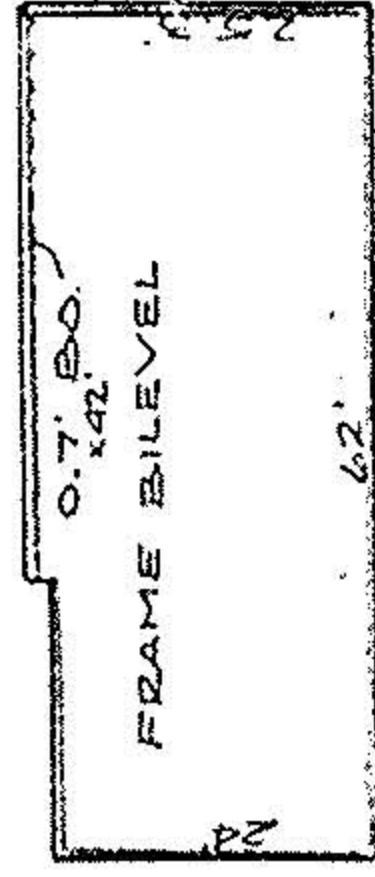

SCALE 1"=30'

100'

0.2
64

NEFF & ASSOCIATES Consulting Engineers and Surveyors CLEVELAND - ELYRIA, O.

SCALE - 1"=100'
DATE - 2-8-78
JOB No. - 42901
TITLE No. - E-10,468

This MORTGAGEE'S INSPECTION was prepared for IDENTIFICATION PURPOSES for the MORTGAGEE in connection with a new mortgage, and is not intended or represented to be a land or property line survey. NO corners were set. Do not use for establishing fence or building line. No responsibility is extended herein to the present or future land owner or occupant.