Map of Part of Surplus Lot No. 26 and O.L. 64 and 65 Brownhelm Twp. Lorain Co. Ohio
Scale 1" = 300' Nov. 16, 1974 By Arnold F. Koepp Registered Surveyor No. 4306
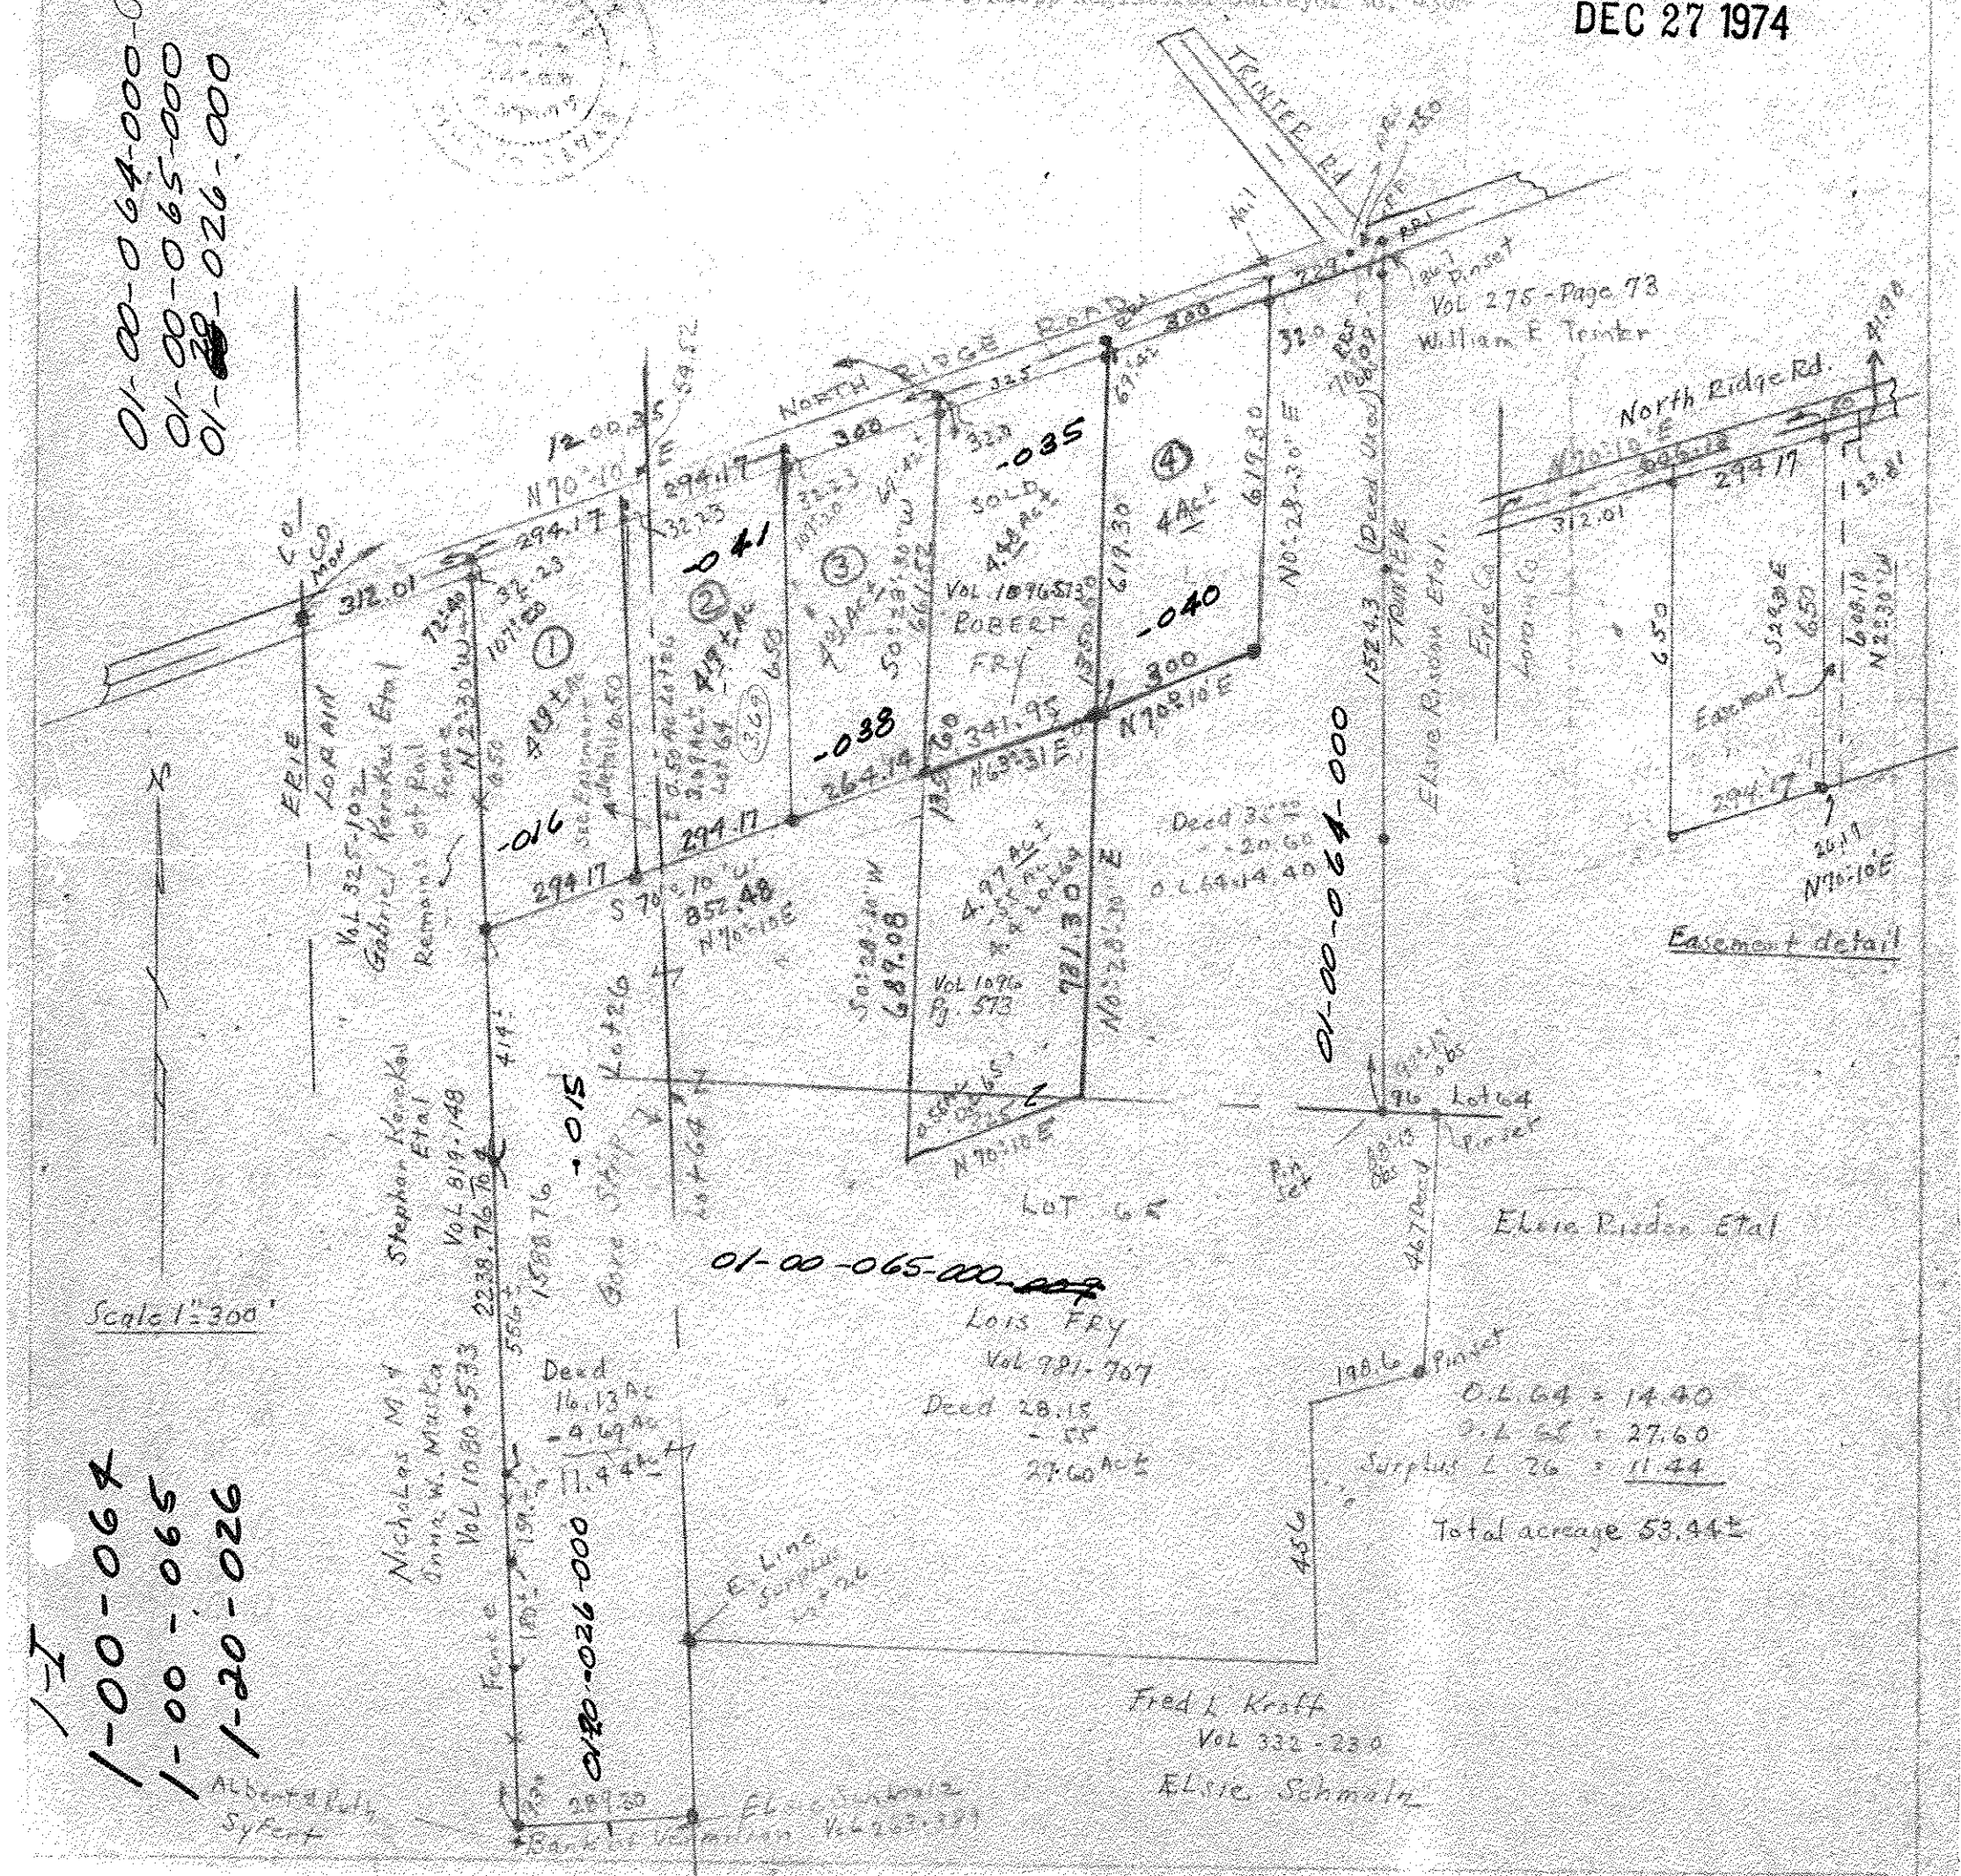
DEC 27 1974