

S88°39'-25"E 1370.55'

-002 20.00 Ac.
Lawrence F. & Zelda
Cline

WOODS

-003 25.00 Ac.
Paul R. Leimbach

-004 37.00 Ac.
Paul R. Leimbach


-005 75.59 Ac.

48.6842 Ac. (by Survey, West Side
of Bank Street)
Paul R. & Patricia N.
Leimbach
V.1000 P.952

-003 82.75 Ac.
Paul R. Leimbach
V. 1134 P.84

006 0.60 Ac.
Russell C. & Loretta L.
Brogan
V. 169, P.571


008 1.00 Ac.
Jeffery D. & Marianne
Penton
V. 1124, P. 219

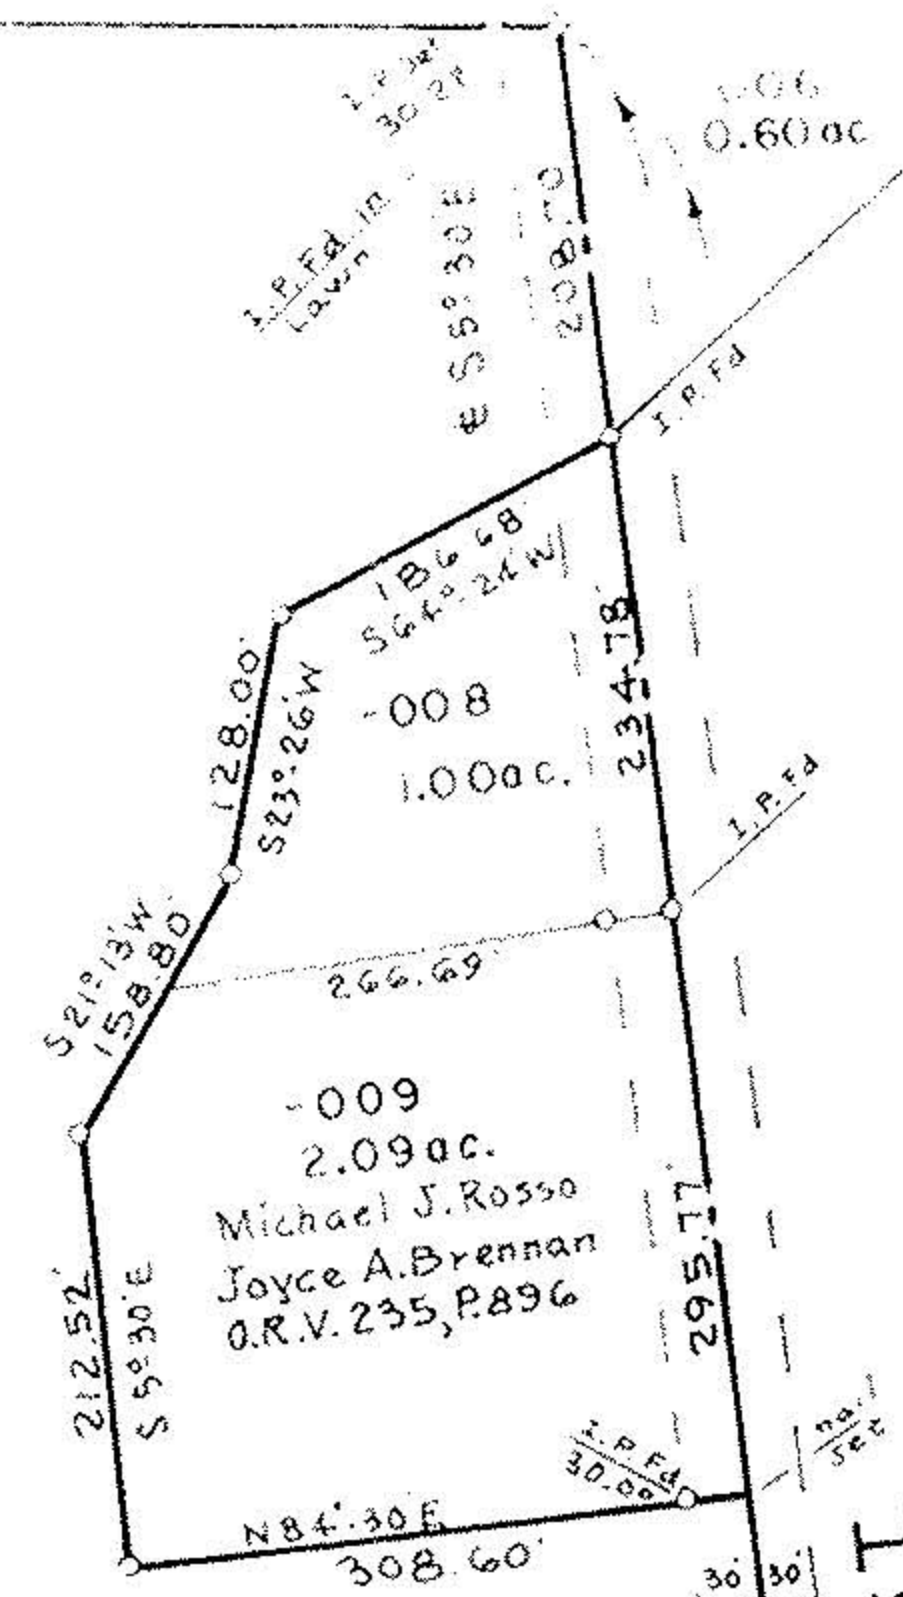

55°30'E
1586.10' from Orig. Lot
Line to end of Public
Road and Property
Line.

NORTH
ASSUMED
MERIDIAN

SCALE
1" = 200'

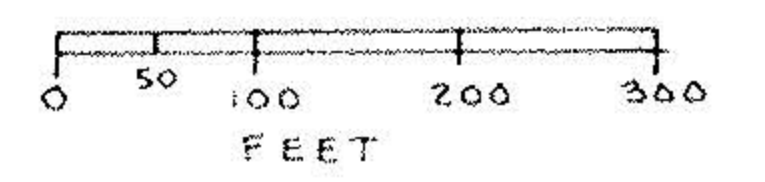

O.L. 66
O.L. 67
N 0°-33'-10"W 1559.25' Rec., M

I.P. FA

N 88°-02'-00"W 1508.04'

f Prop. Line

60'
BANK ST.

55°30'E 846.85'

588°02'E 431.00'
I.P. Set 30.26'
R.R.S.

SPLIT
1.5101 Ac. (North Part)


453.55'
N 88°-02'W
TOTAL = 5.4879 Ac.

3.9778 Ac. (South Part)

N 1°-46'-40"W 65.00'
N 6°-10'-50"E 70.00'
N 8°-06'-15"E 80.00'
N 2°-05'-25"E 128.27'

Centerline of Asphalt Lane

560.04'
N 88°-02'W

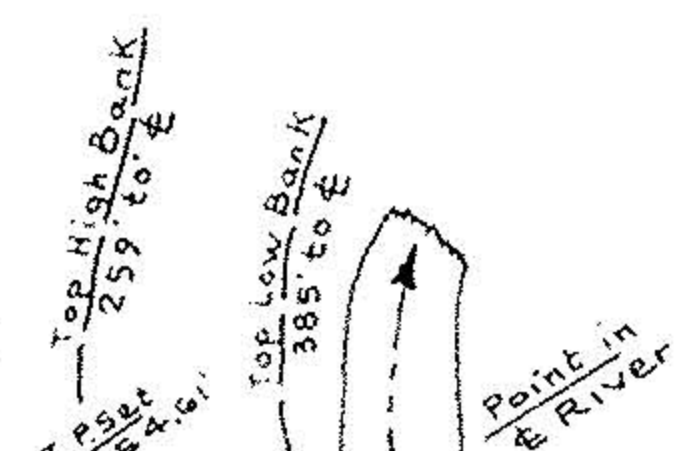

VERMILION RIVER

P.P.N
01-00-067-000-
.003
.005 O.L. 67

MAP OF SURVEY OF 5.4879 ACRES AND
48.6842 ACRES, PART OF ORIGINAL LOT
NO. 67, BROWNHELM TWP, LORAIN CO OHIO.

Made at request of Orrin Leimbach
By Charles P. Waryu Registered Surveyor
No. 5029 July 10, 1993

Charles P. Waryu
REGISTERED SURVEYOR
NO. 5029

Rev. 2/12/94: Split Lot as per Atty. R. Muzilla