P.P.N 01-00-071-000-035

K. E. McCARTNEY & ASSOCIATES, INC

ENGINEERS & SURVEYORS

JOB NO. 985727 MARCH, 1998

#22572-D

APPROVED
LORAIN CO.
MAP DEPT.
DATE 6/23/98
PAGE 1-2
BY TJS
VOID AFTER 22572-D

PART OF BROWNHELM TWP. O.L. 70 & 71
LORAIN COUNTY, OHIO

MAP OF COMBINATION SURVEY FOR:
JUNE BALZER

REF: P.P. NOS. 01-00-071-000-030 & -031
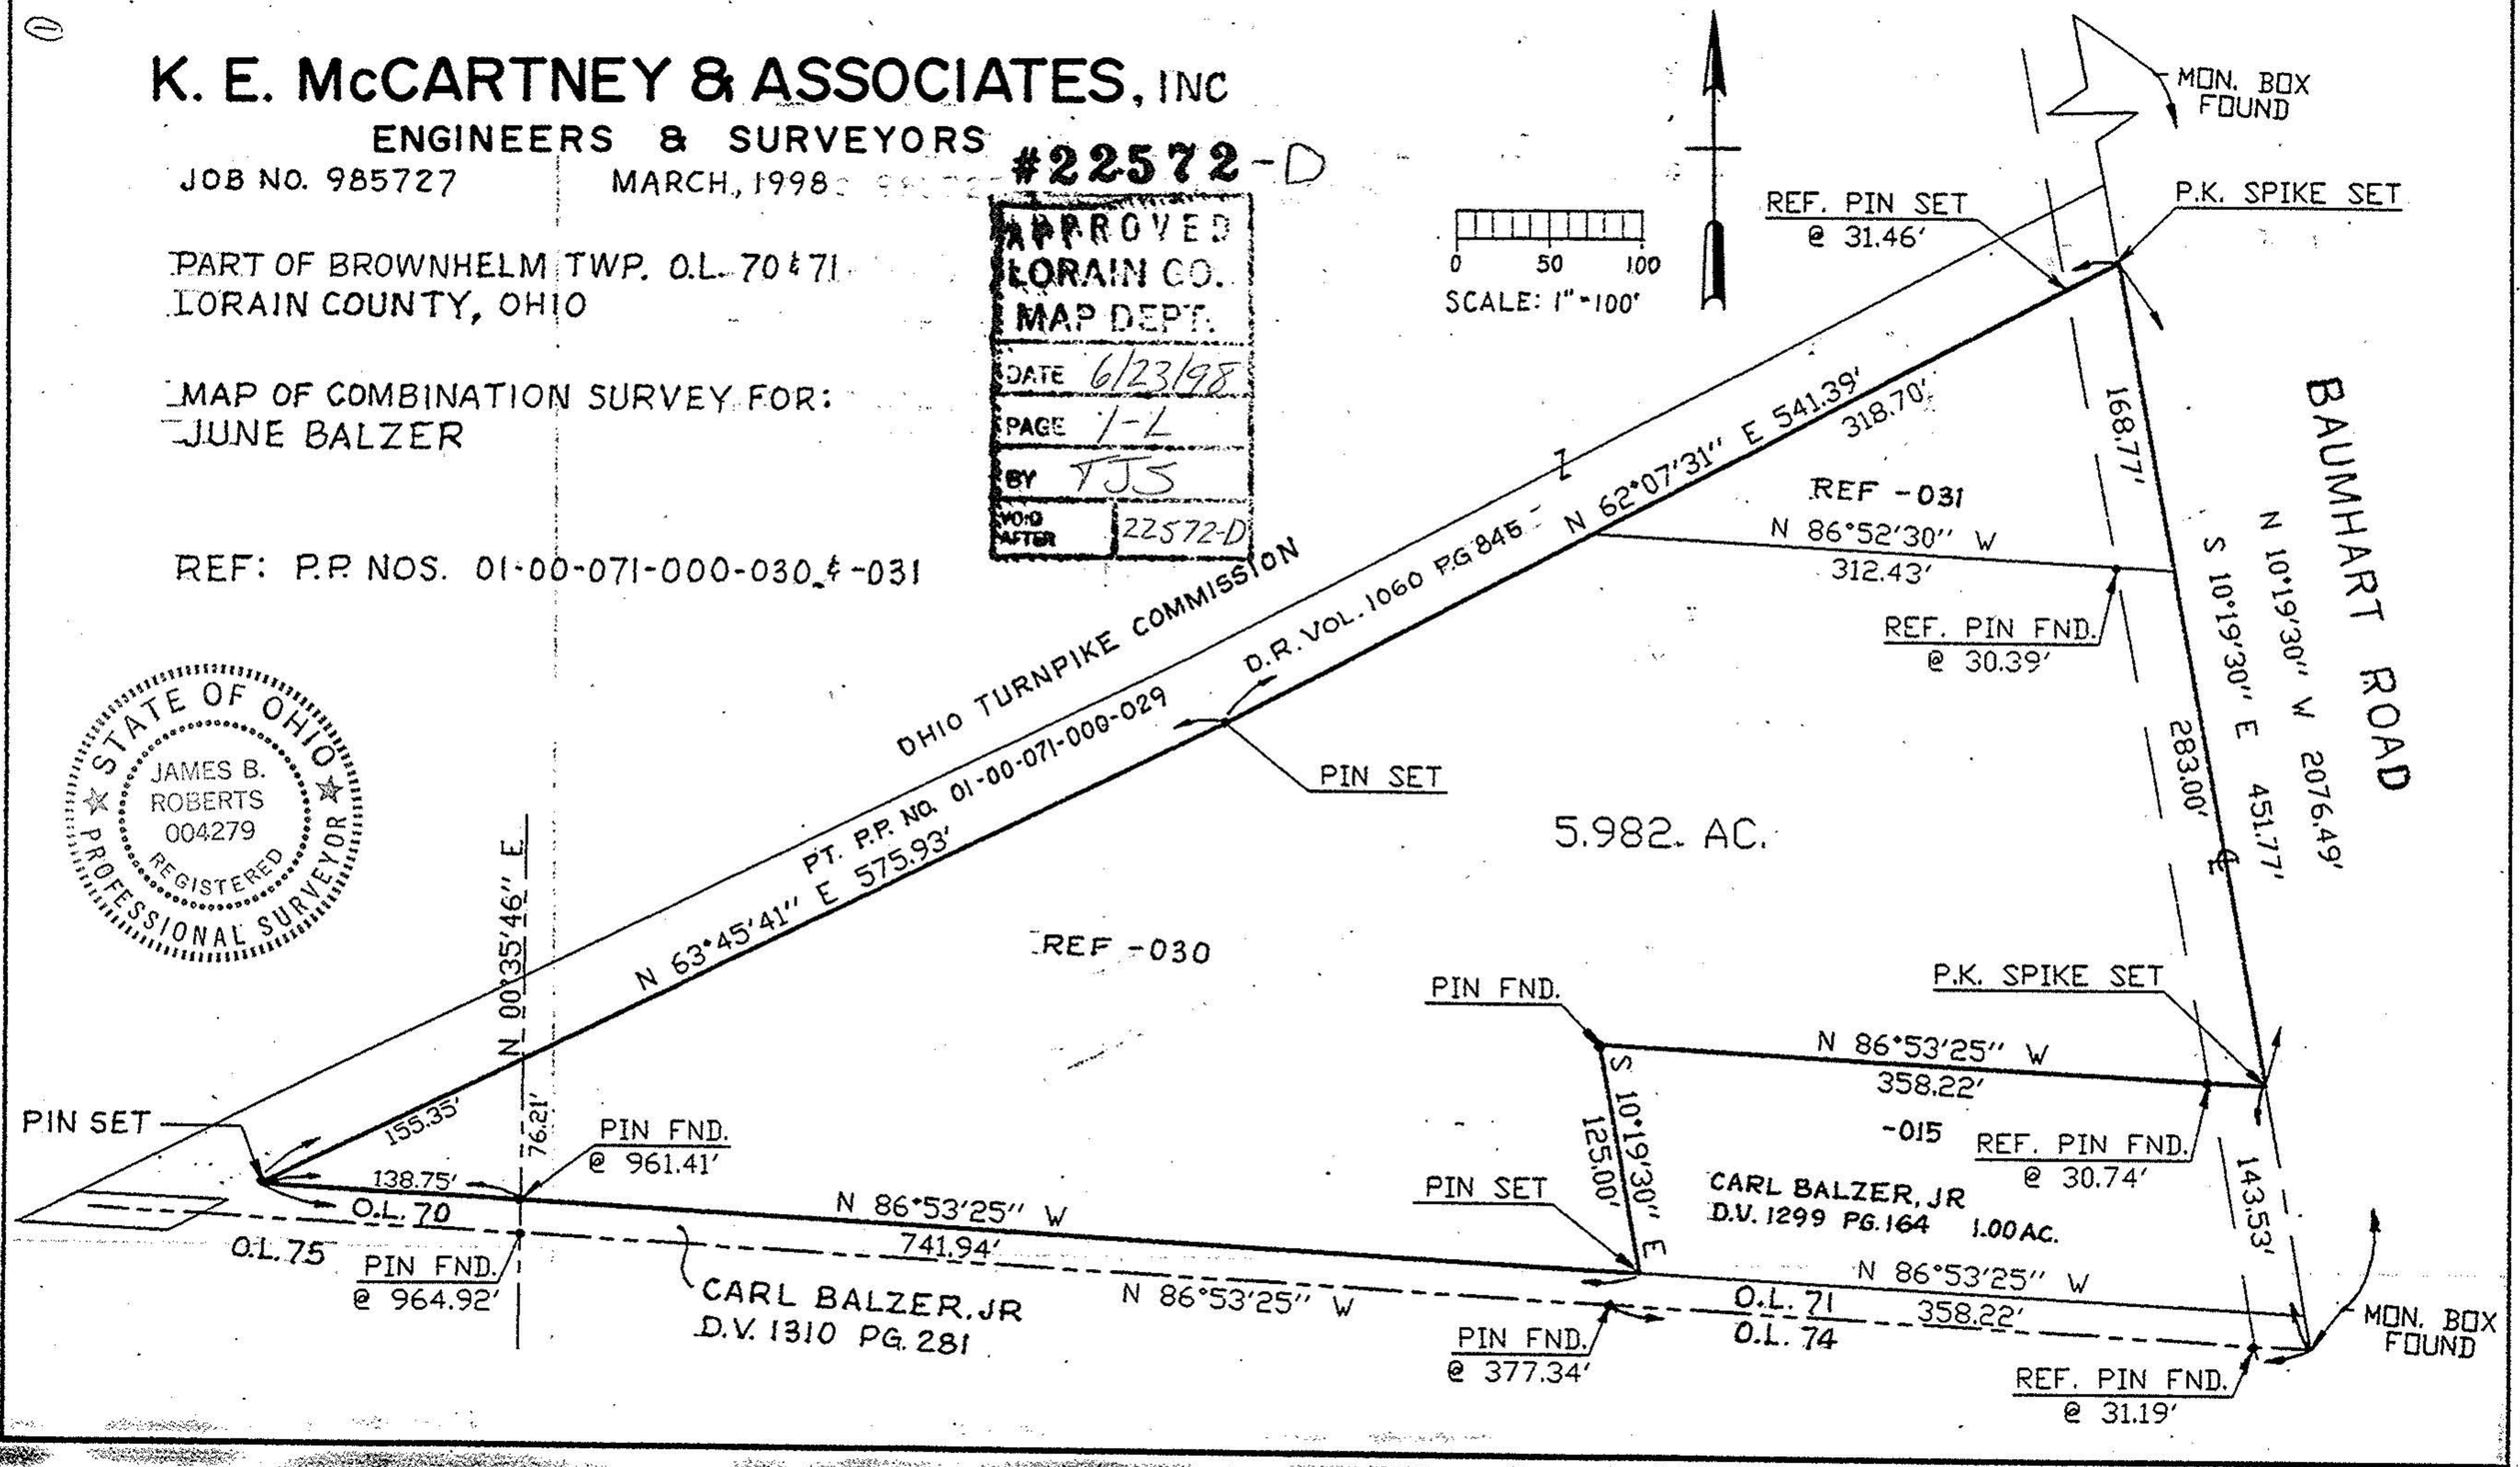
STATE OF OHIO
JAMES B. ROBERTS
004279
REGISTERED
PROFESSIONAL SURVEYOR