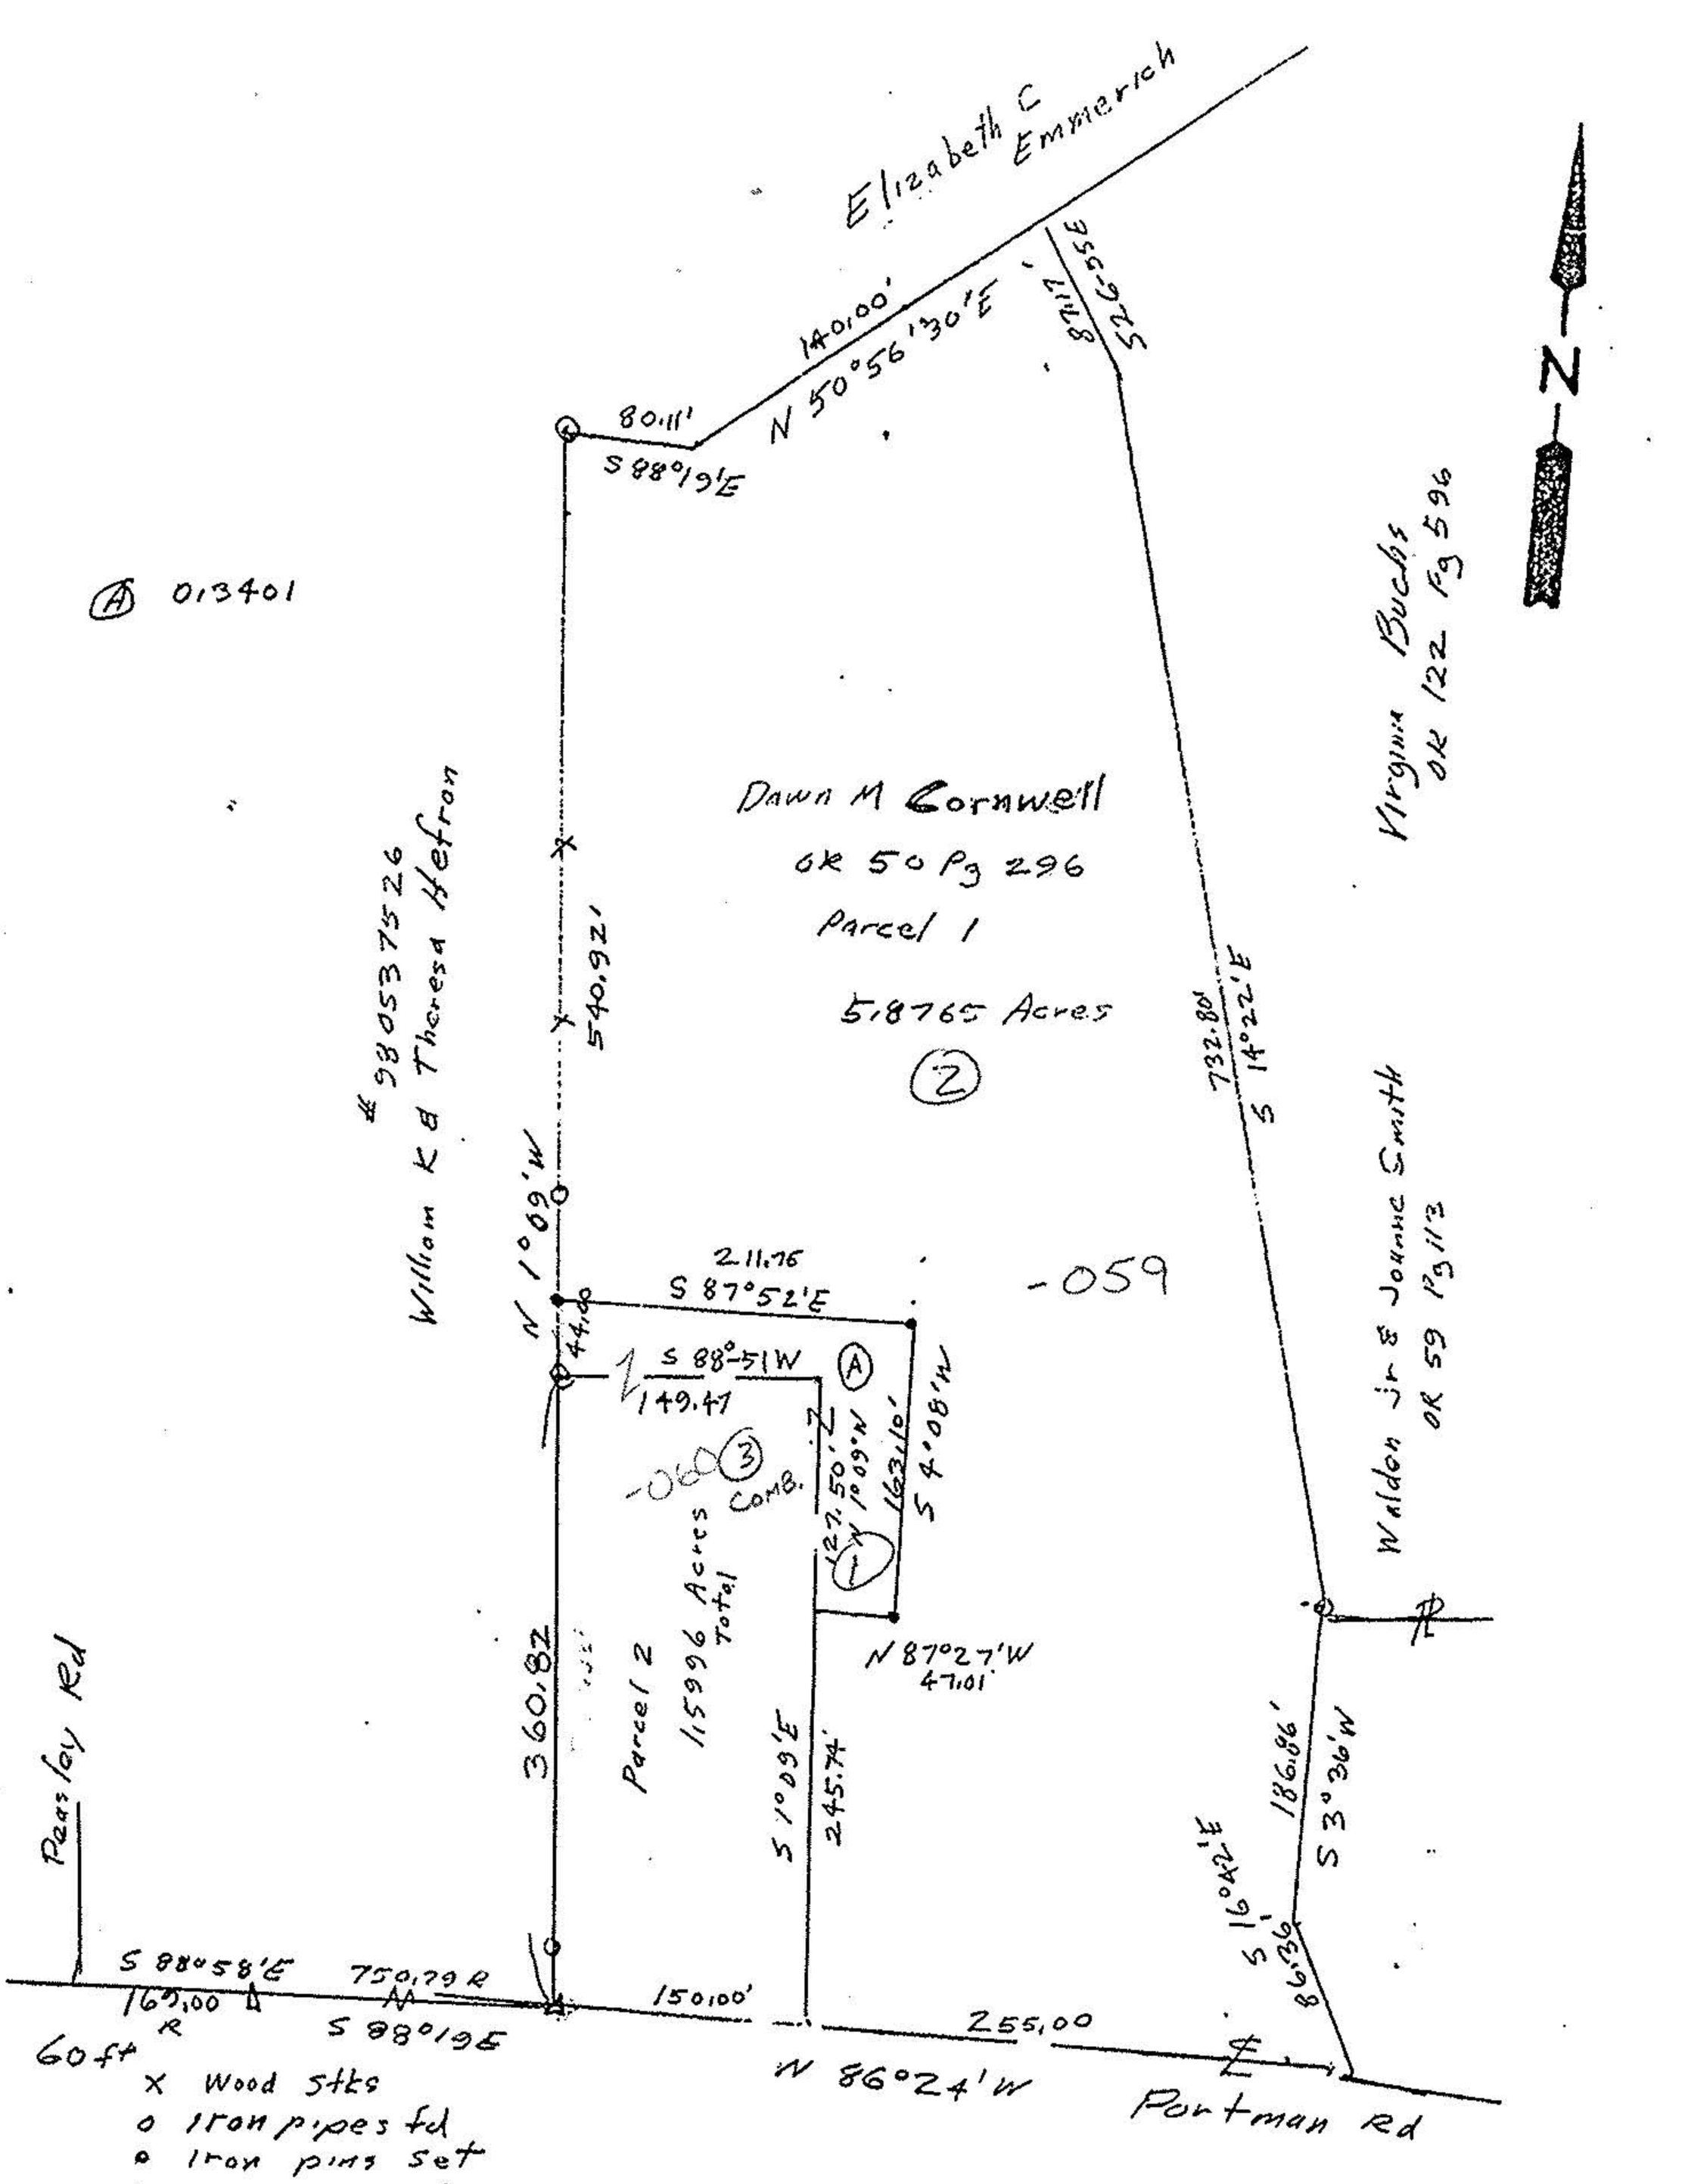


STATE OF OHIO
JOHN POZYWAK
5292
REGISTERED
SURVEYOR

John P. Pozywak

Survey of Parcel Split for
Dawn Cornwell
Original Lot 77
Brownhelm Township
Lorain County Ohio

0 1 feet 2 3

Scale 1" = 100' June 1999

P.P.N
01-00-077-000-018,053

#00184

APPROVED
LORAIN CO.
MAP DEPT.
DATE 8-25-99
DATE 1-J
BY T. Dick
NO. 00184