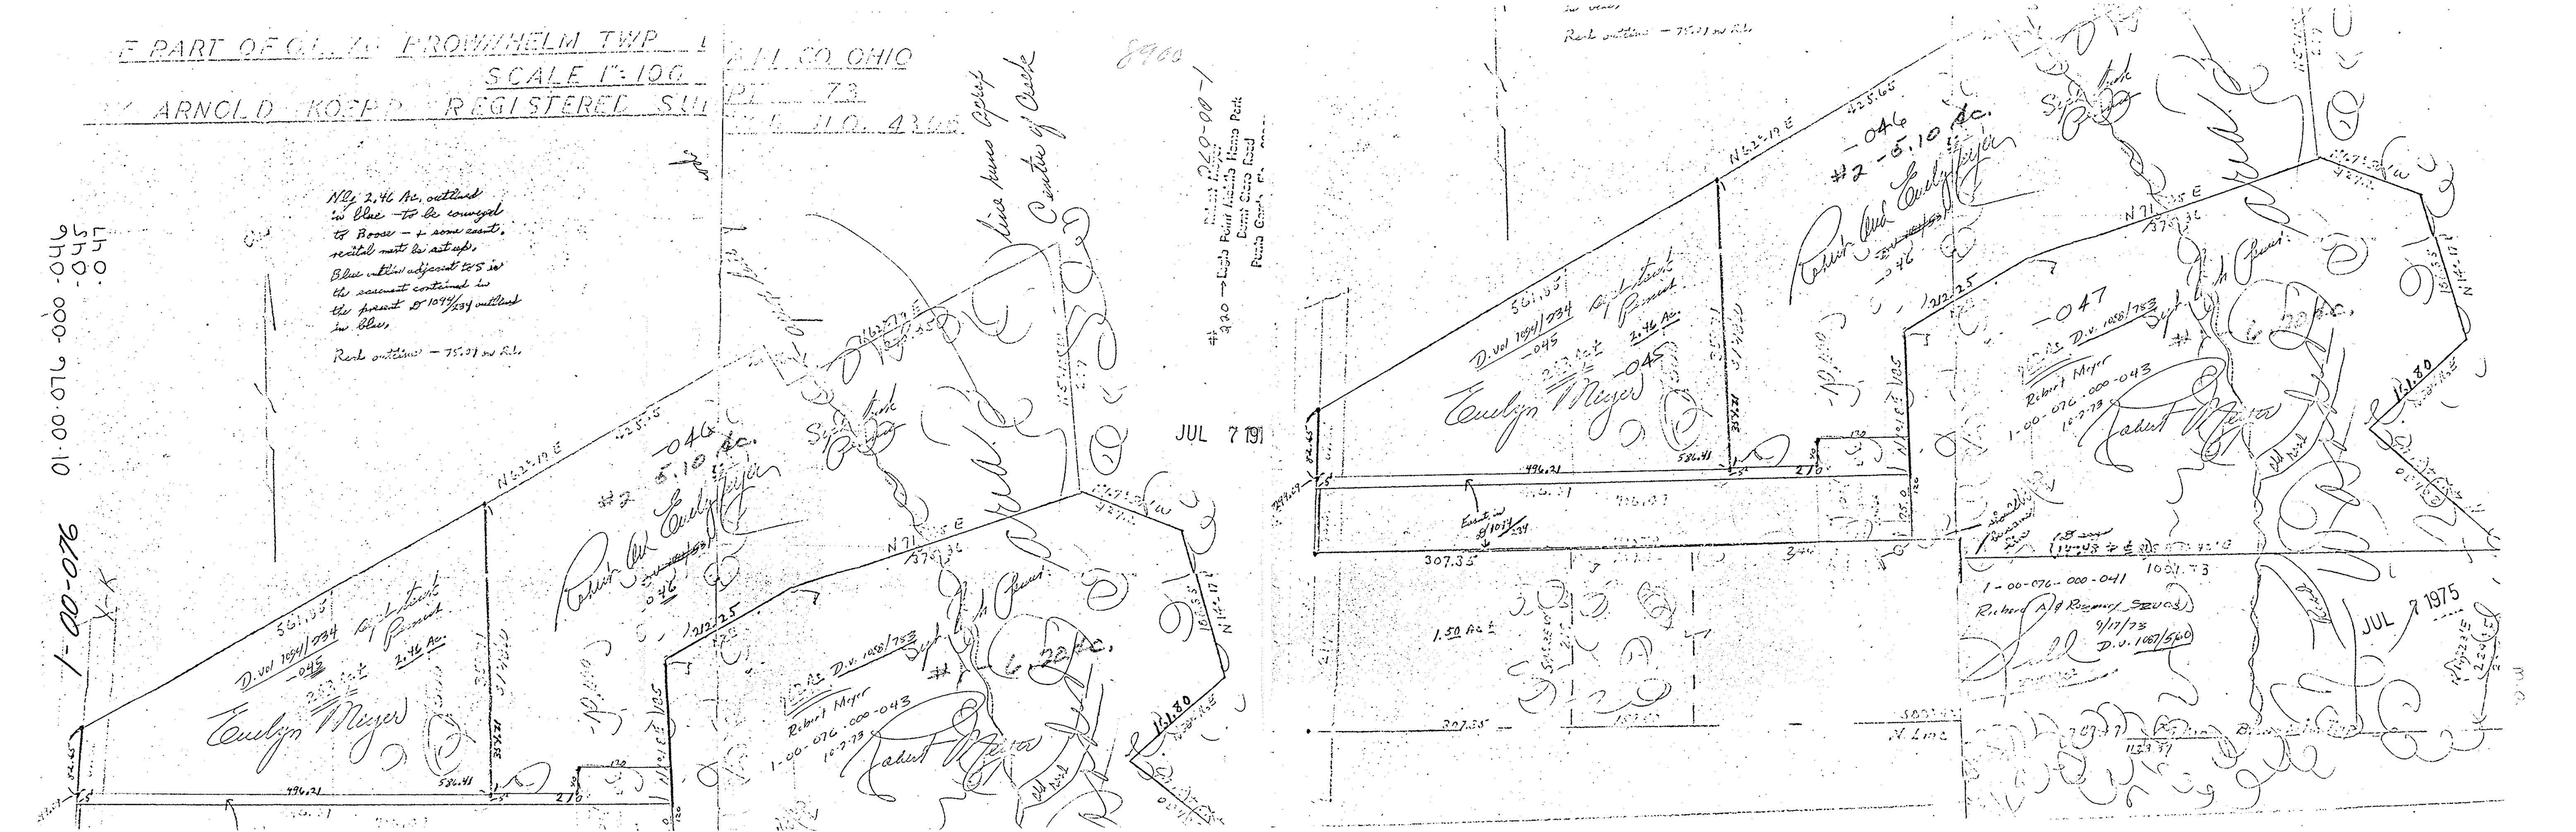

F PART OF O.L. 70 BROWNHELM TWP
SCALE 1"=100
ARNOLD KOEPP REGISTERED SU
Nly 2.46 Ac. outlined in blue - to be conveyed to Boose - + some easmt. recital must be set up.
Blue outline adjacent to S is the easement contained in the present D 1094/234 outlined in blue.
Rock outline - 75.01 on Rd.
1-00-076
01-00-076-000-046
-046
#2 5.10 Ac.
Robert Meyer
Evelyn Meyer
D. Vol 1094/234
-045
2.46 Ac.
Robert Meyer
1-00-076-000-043
10-2-73
Robert Meyer
JUL 7 191
Line runs Approx Center of Creek
Robert Meyer
#220 → Eagle Point Mobile Home Park
Dorm Store Road
Punta Gorda Fla
-046
#2 - 5.10 Ac.
Robert Meyer
Evelyn Meyer
D. Vol 1094/234
-045
2.46 Ac.
-047
Robert Meyer
1-00-076-000-043
10-2-73
Robert Meyer
1-00-076-000-041
Richard A & Rosemary Sruoss
9/17/73
D.V. 1087/560
JUL 7 1975
1.50 Ac.
307.35
496.21
586.41
N 62°19 E
N 71°35 E