Map of Part of O.L. 77 Brownhelm Twp. Lorain Co. Ohio
Scale 1" 400' June 5, 1985
By Arnold F. Koepp Reg. Surveyor No. 4306

Information Taken
From Deeds -
Corrections MADE
OK By Arnold Koepp
5-1-86

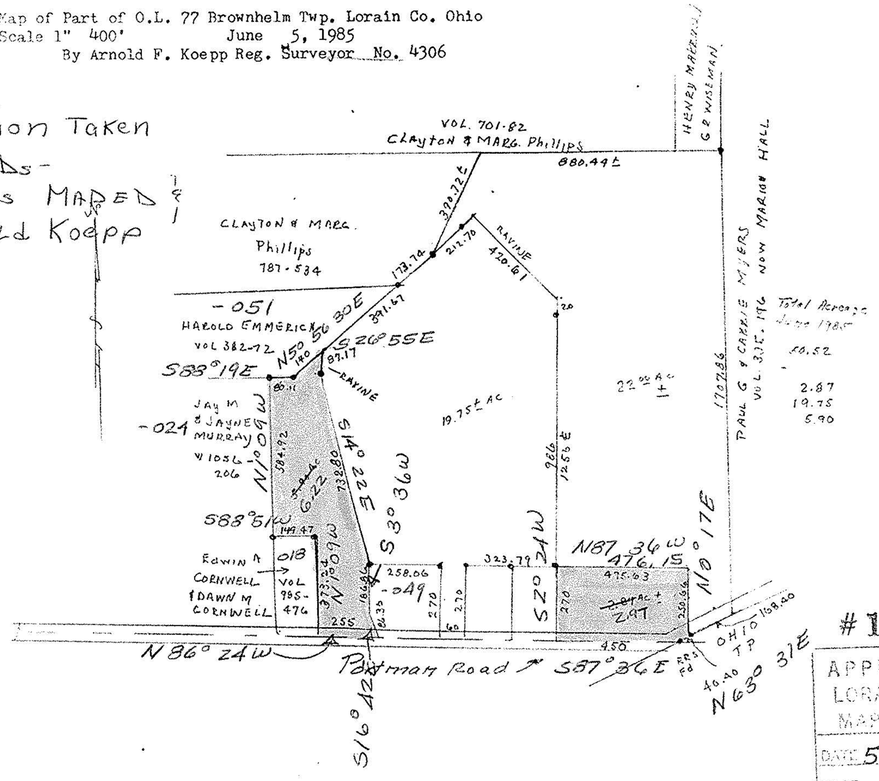

APPROVED
LORAIN CO.
MAP DEPT.
DATE 5-1-86
PAGE 1-J
BY Carolyn Franz
VOID AFTER 16712
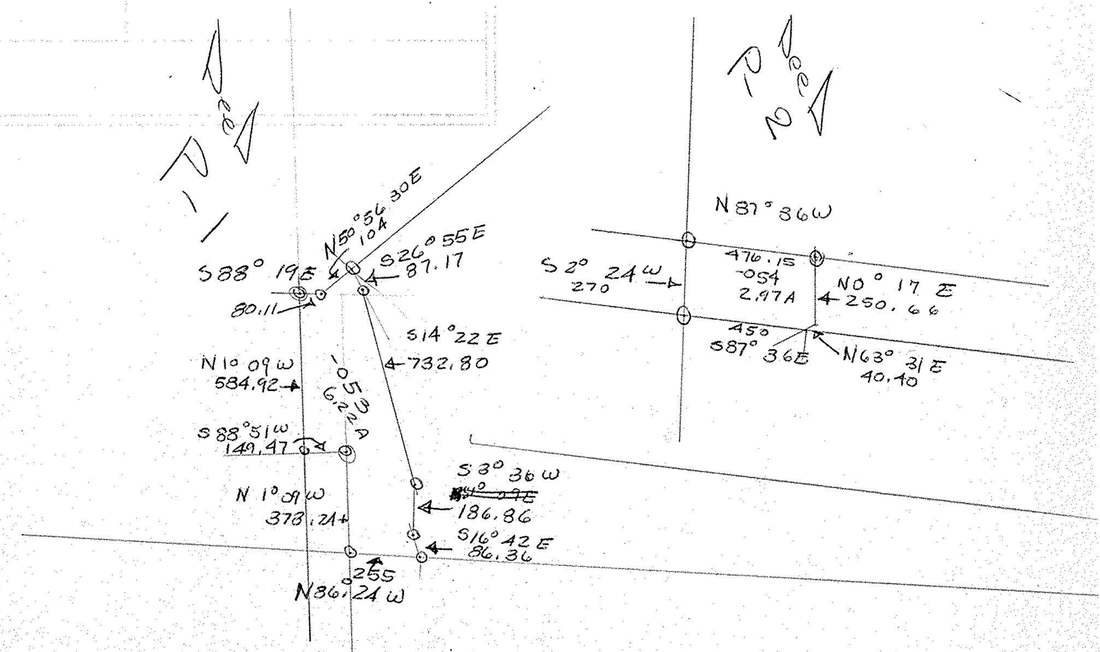
1-J
O.L. 77
#16712