
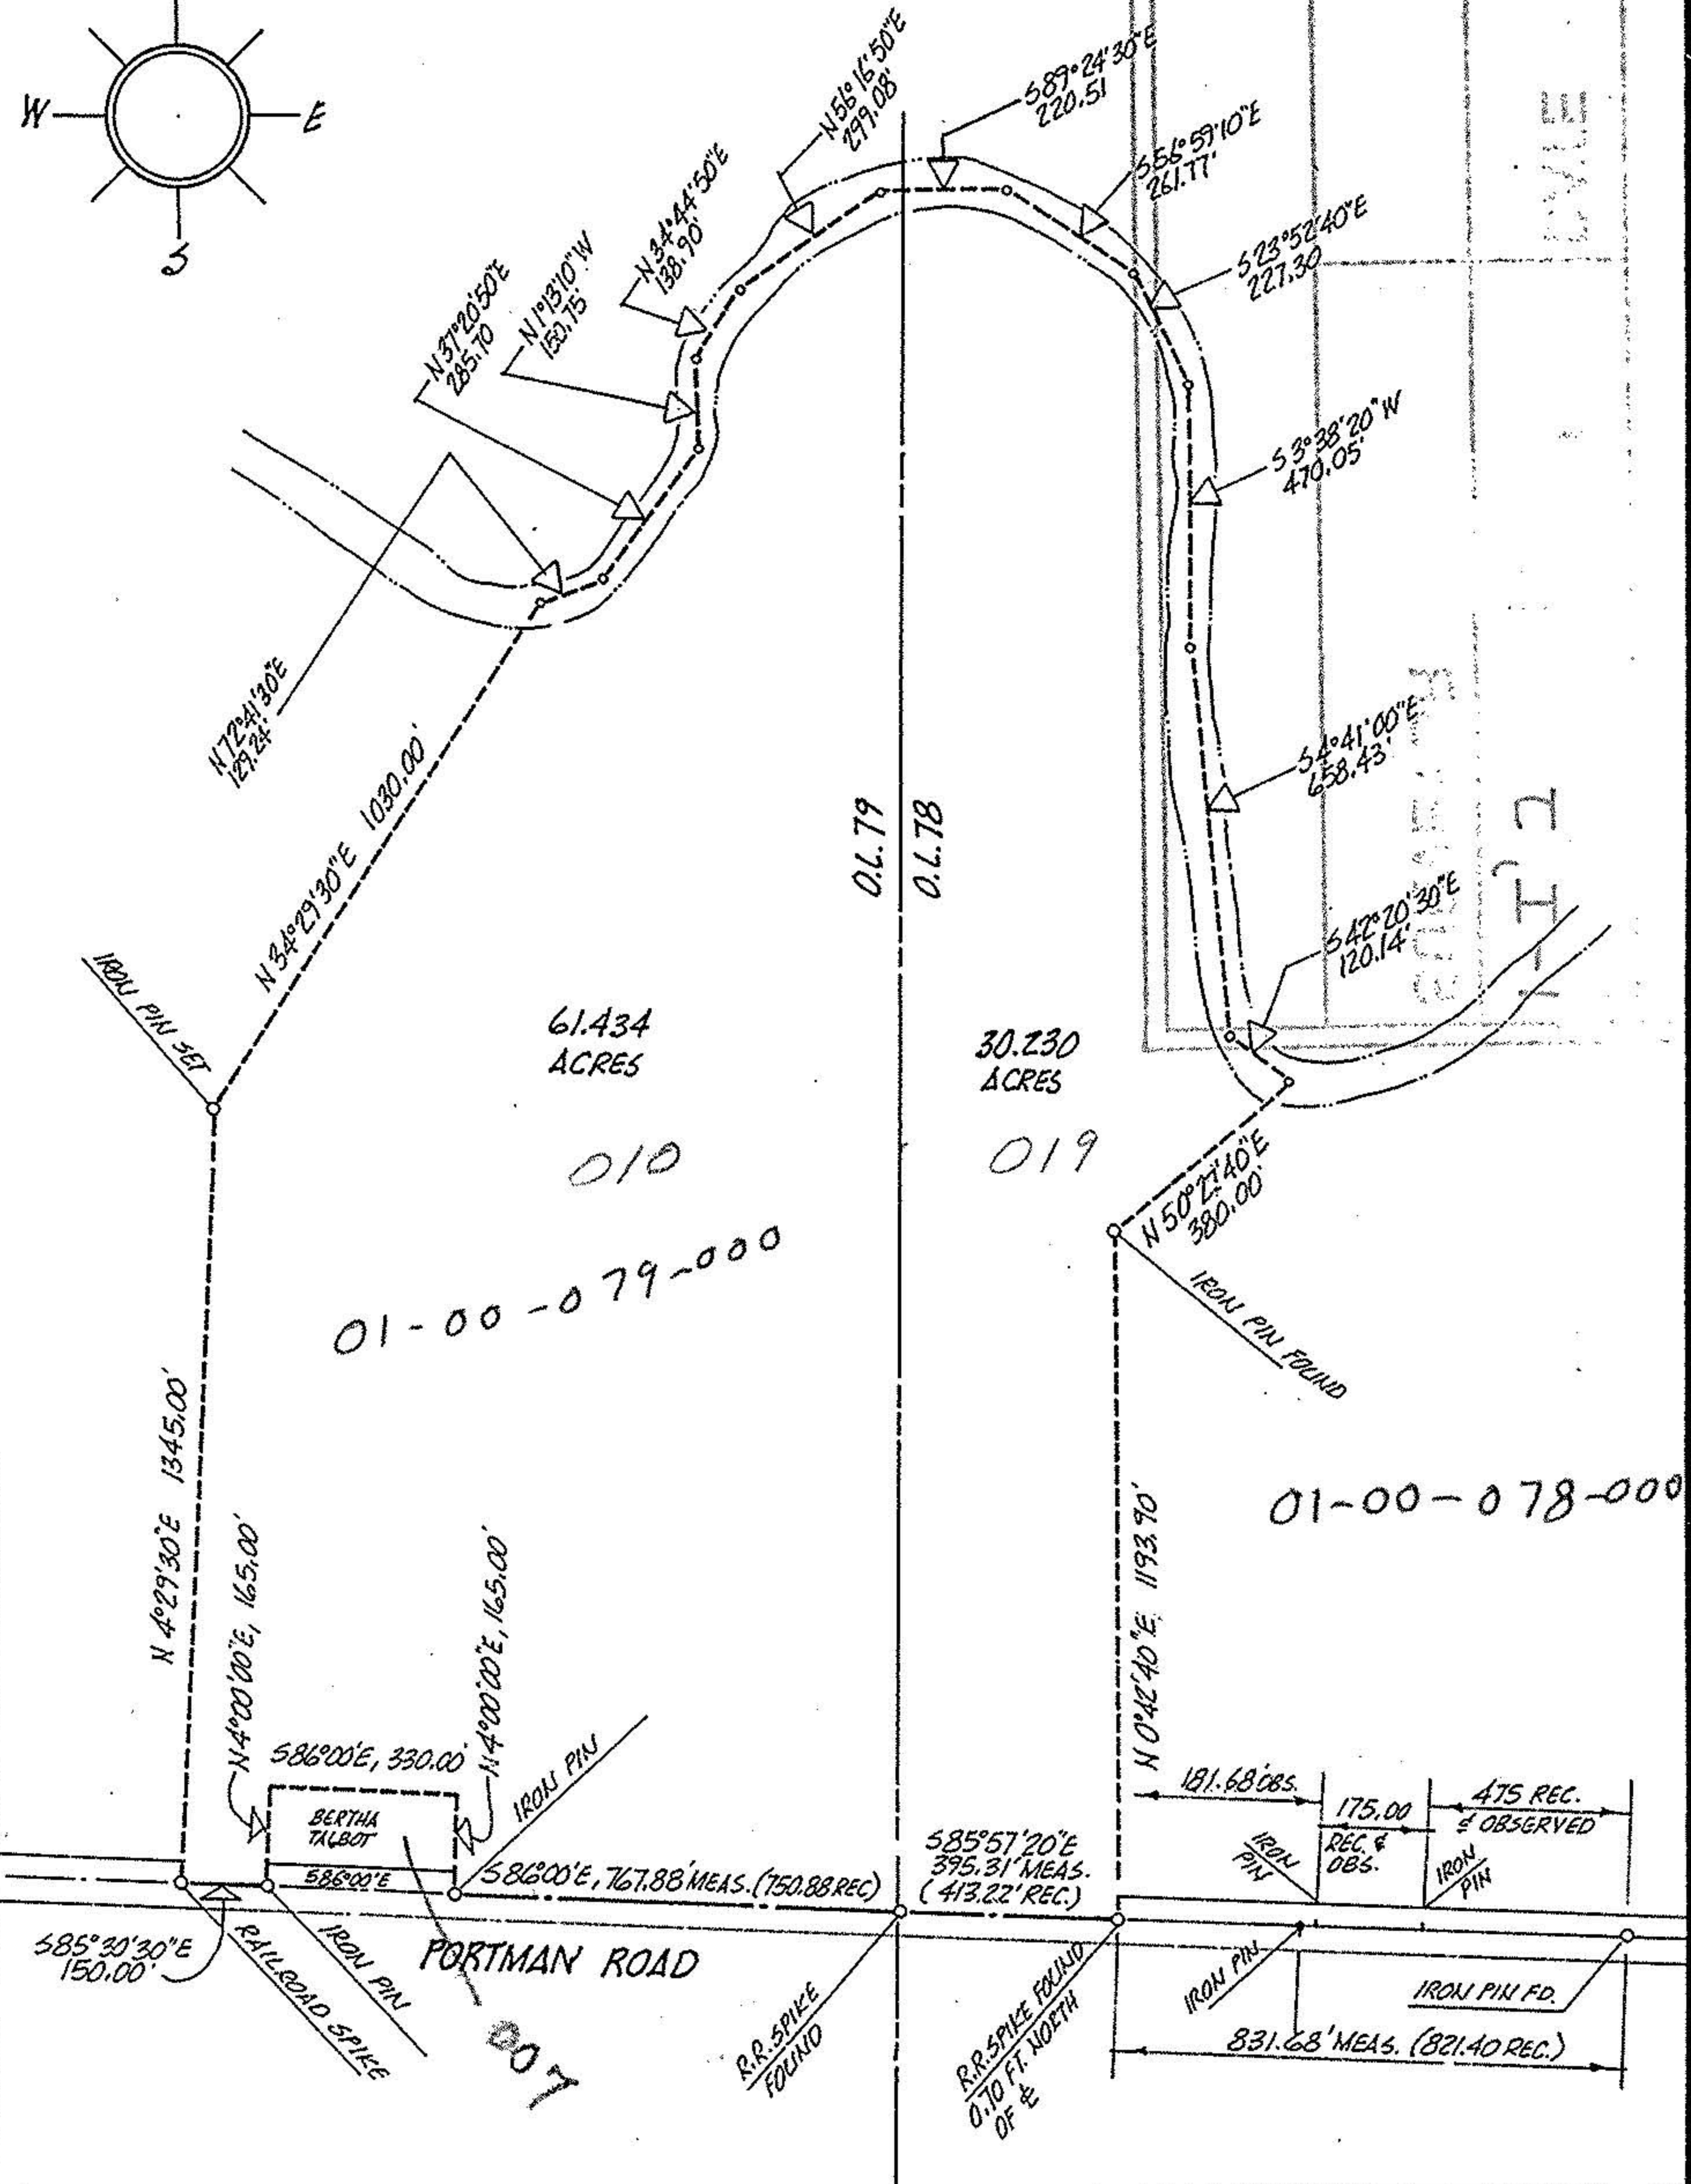


01-00-079-000 010

010-000-870-00-10
010-000-870-00-10

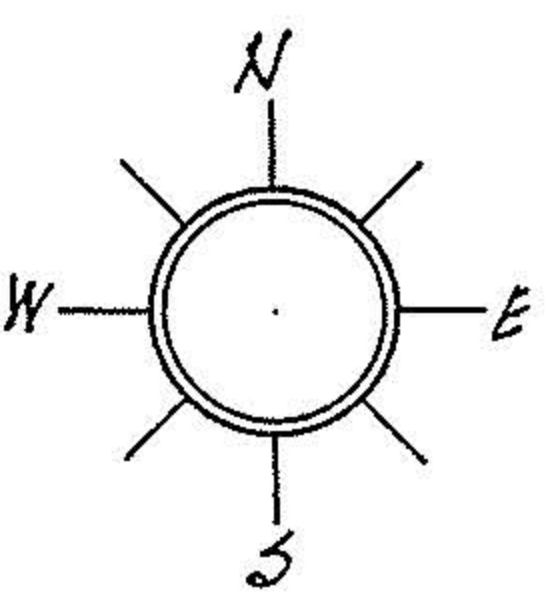

0.L. 79 0.L. 78

ACREAGE 91.664
 DATE 04-09-86
 DRAWN MGH
 SCALE 1" = 400 ft.

PREPARED FOR ROLLAND ANGERSBACH, PORTMAN RD. 965-7141
#51900 PORTMAN ROAD, AMHERST, OHIO

MICHAEL G. HURA, registered surveyor.
 12706 MASON RD., VERMILION, O., Ph (216) 965 4040

CITY OF



PERIMETER SURVEY

SUBLOT(s) _____ of _____
 _____, Volume _____ Page _____ of PLATS
 PART OF O.L.'s 78-79 TRACT _____ SECTION _____ OF
BROWNHELM TOWNSHIP LORAIN CO., OHIO
 PERMANENT PARCEL NO? _____