



NORTH

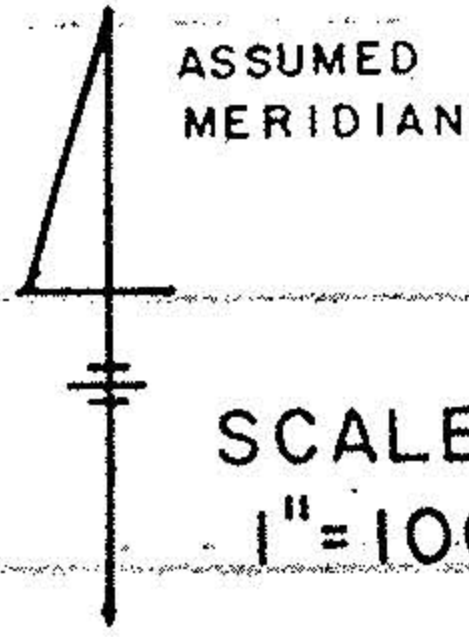

SCALE
1" = 100'

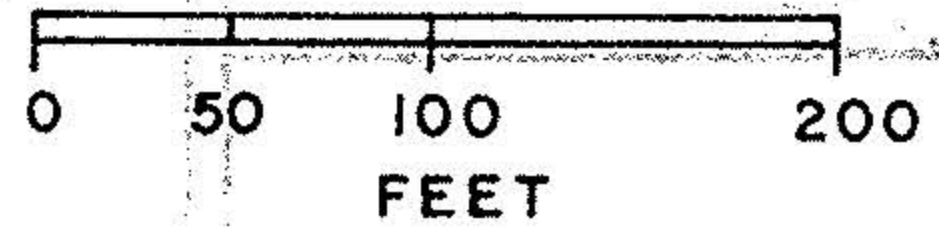

LEGEND: Iron Pipes, Rods, R.R. Spikes
Found \circ
1/2" Iron Rods Set \bullet

①
DATA ON SEGMENT OF CURVE
on South Right of Way Line
Delta = $1^{\circ}57'32''$
D = $1^{\circ}29'18''$ R = 3849.72'
T = 65.82' L = 131.64'
Chord = N $86^{\circ}21'50''$ E, 131.63'


O.Lot No. 73 = 0.1112 Ac.
O.Lot No. 74 = 1.4044 Ac.
TOTAL = 1.5156 Ac.

21779
APPROVED
LORAIN CO.
MAP DEPT
DATE 5-24-96
PAGE 1-00-073A
1-00-074A
BY CAROLYN
FRANLIS
#21779

David D. Miller,
Roger G. Miller
O.R.V. 394, P.334

STICK ROAD DEDICATION PLAT
PLAT VOL. 25, P.4, Oct. 4, 1967
60' ROAD RIGHT OF WAY IN NAME
OF BROWNHELM TOWNSHIP TRUSTEES

Centerline Curve Data
Delta = $3^{\circ}23'13''$
D = $1^{\circ}30'$ R = 3819.72'
T = 112.93' L = 225.80'

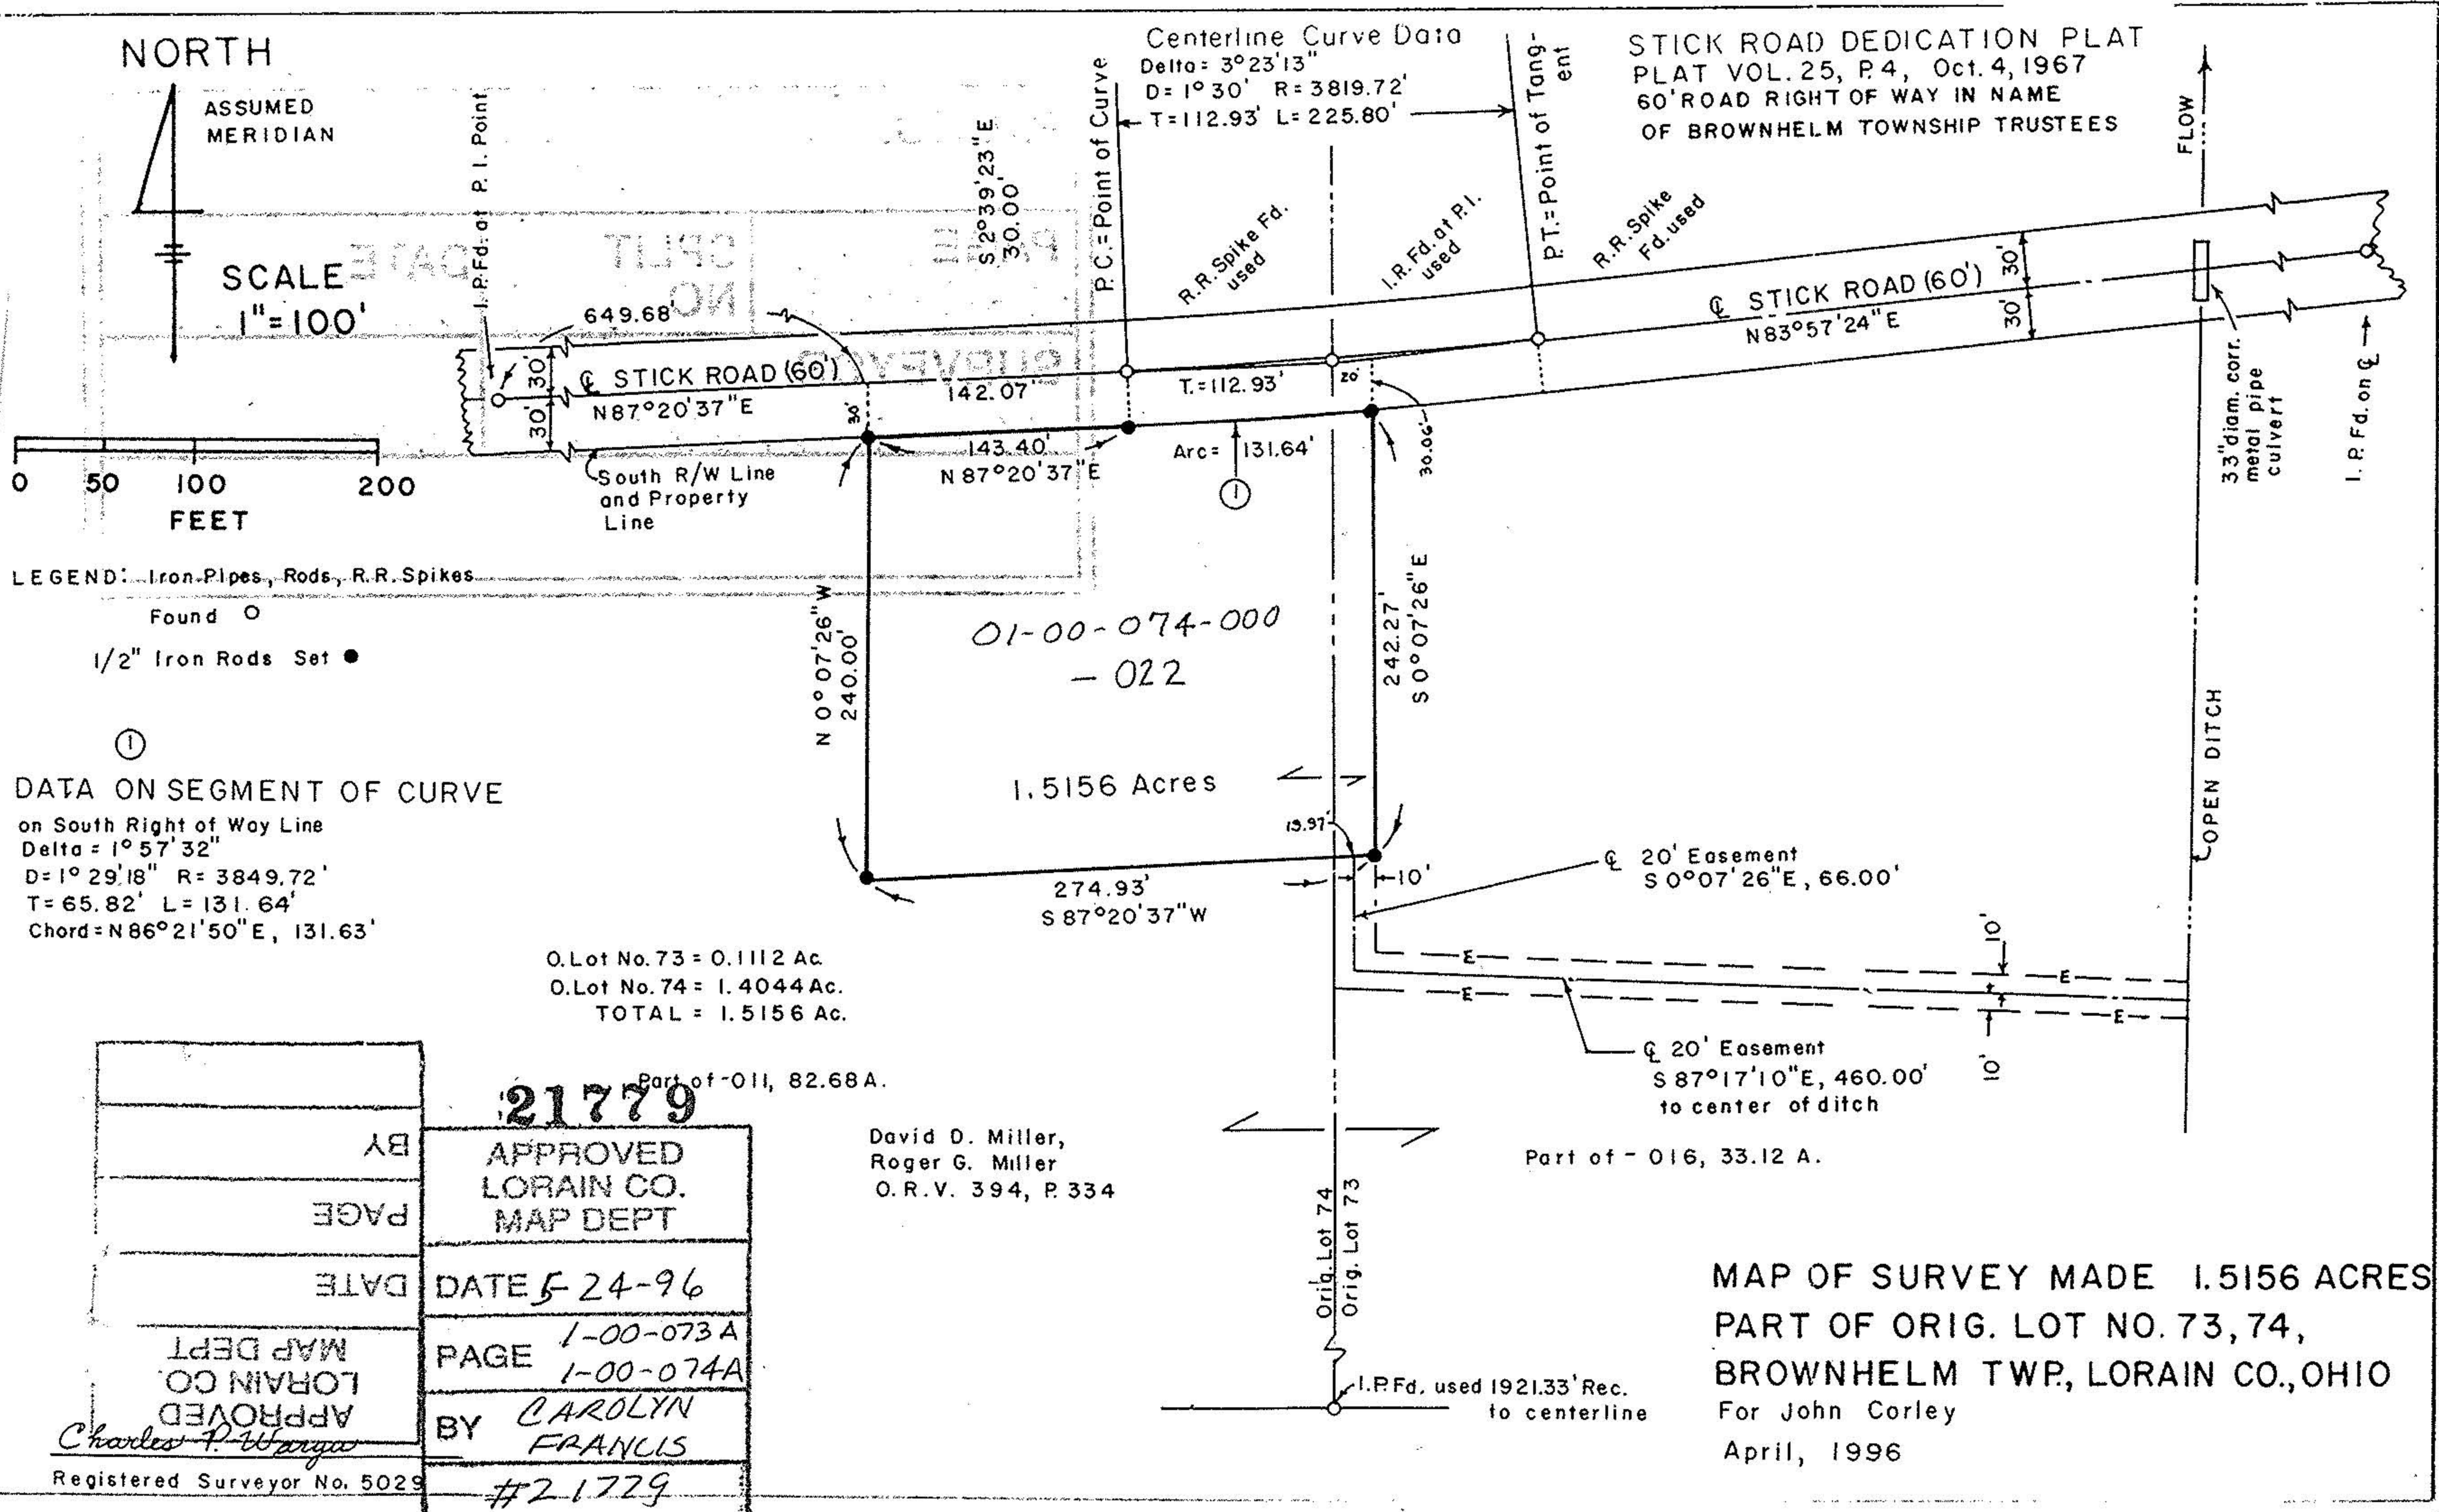

MAP OF SURVEY MADE 1.5156 ACRES
PART OF ORIG. LOT NO. 73, 74,
BROWNHELM TWP, LORAIN CO., OHIO
For John Corley
April, 1996