

NORTH


LEGEND: Iron Rod Found
1/2" Iron Rod Set

SCALE
1" = 100'



~~01-00-074-000-029~~
NEED SURVEY
FILE INFORMATION SHEET

REFERENCE: DEDICATION PLAT OF STICK ROAD (60')
PLAT VOL. 25, P. 4, 10/24/67

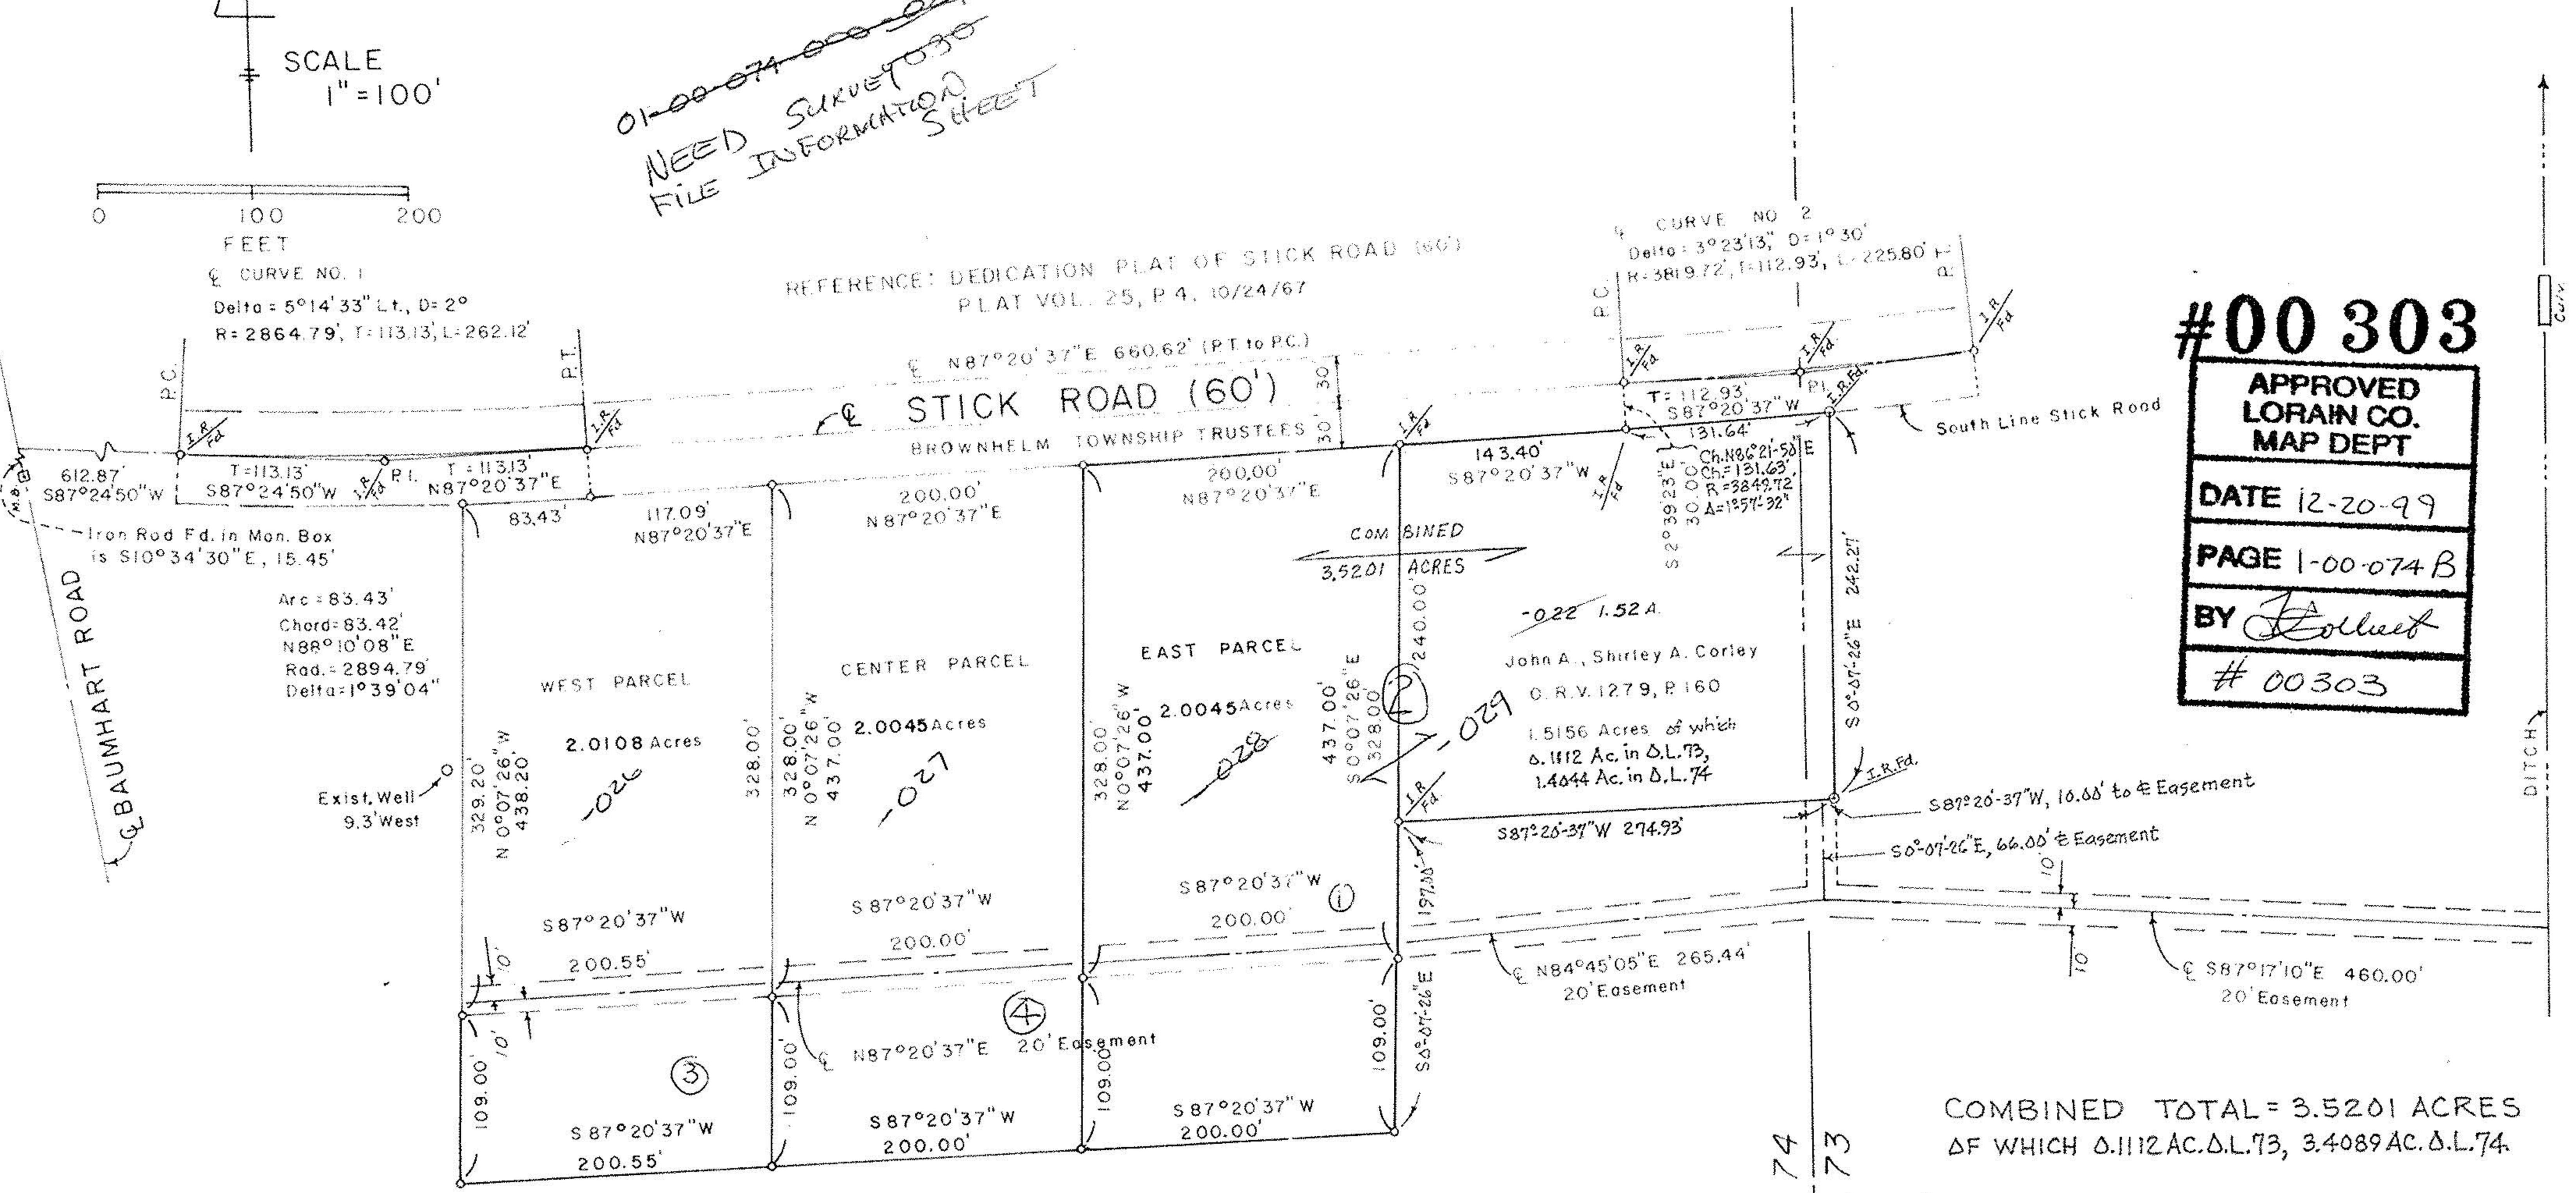

#00303

APPROVED
LORAIN CO.
MAP DEPT

DATE 12-20-99

PAGE 1-00-074 B

BY *J. Tolbert*

#00303

-023 81.27 A.
Dwight J. Miller
V. 865, P. 307
David D. Miller and Roger G. Miller
O.R.V. 394, P. 334

COMBINED TOTAL = 3.5201 ACRES
OF WHICH 0.1112 AC. D.L. 73, 3.4089 AC. D.L. 74

MAP OF SURVEY MADE
PART OF ORIGINAL LOT NO. 74, 73,
BROWNHELM TWP, LORAIN CO., OHIO
FOR D. MILLER
BY CHARLES P. WARYU, REG. SURVEYOR
NO. 5029

Charles P. Waryu
CHARLES P. WARYU, REGISTERED SURVEYOR NO. 5029

AUGUST, 1999
Revised November, 1999 Combined-022 with EAST PARCEL