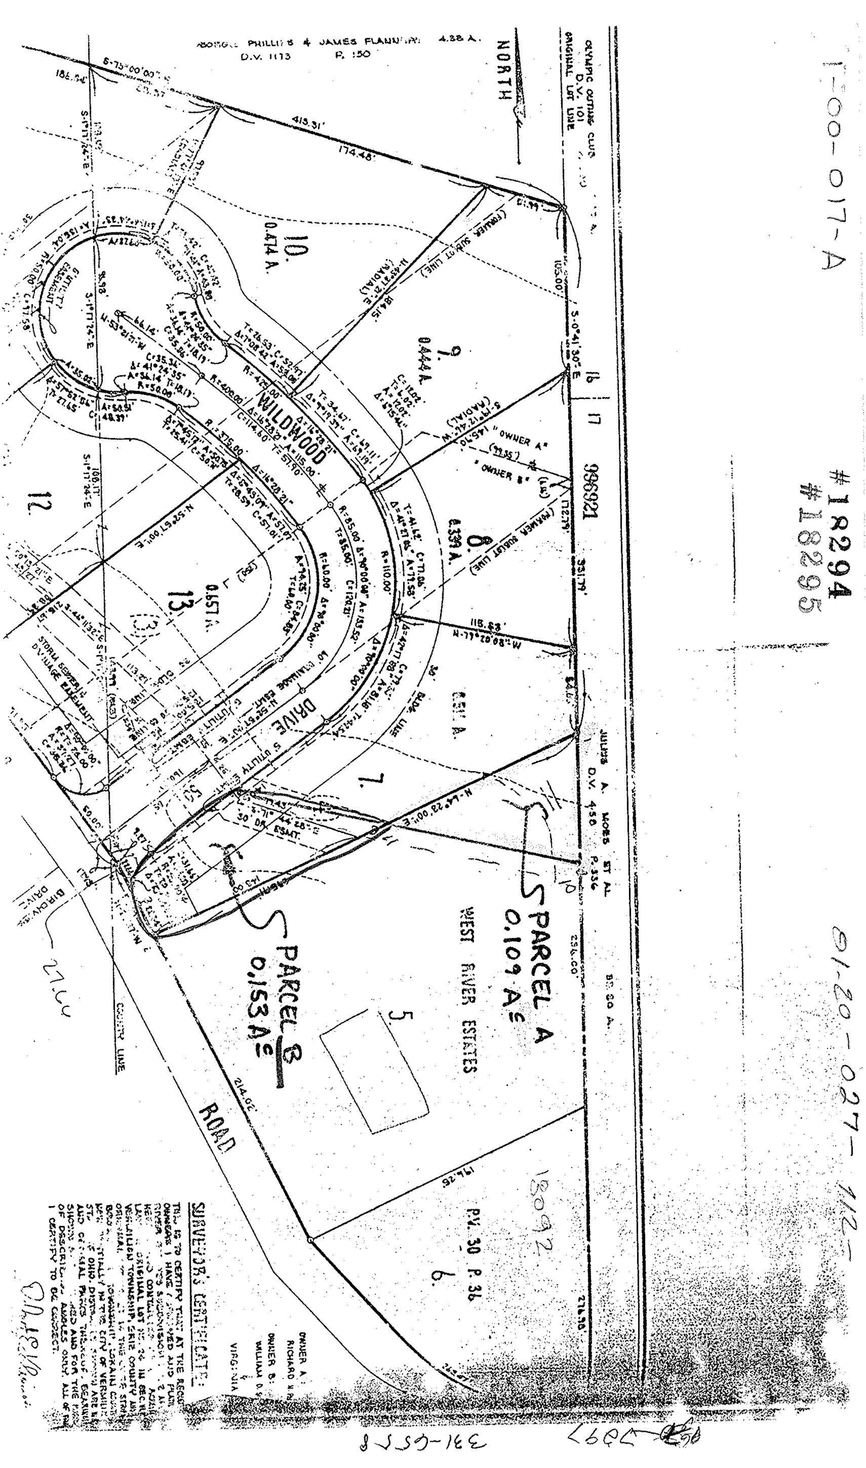

WILLIAM B. BARTON
Reg. Land Surveyor No. 4438
188 PARKWOOD AVENUE
AVON LAKE, OHIO 44012
TELEPHONE (216) 933-6662

01-20-027-112-

#18294
#18295 VOID

APPROVED LORAIN CO. MAP DEPT.	
DATE 10-11-88	
PAGE 1-00-017-A	
BY T. McMain	
VOID AFTER	1809S

1-19-89 dd

SCALE: 1"=40'

NORTH

WILDWOOD DRIVE 50'

WEST RIVER ESTATES No. 2
P.V. 34 P. 6

S/L 7

I.P. FOUND

I.P. SET

I.P. SET

I.P. SET

I.P. FOUND

100.10'
S-78° 50' 55"-E

130.81'
N-64° 23' 00"-E

PCL. A
0.109 AC.

PCL. B
0.153 AC.

65.98'
N-52° 57'-E

65.45

122.60'

121.20'
N-78° 50' 55"-W

S-0° 41' 30"-E
100.08'

163.17'
N-64° 23' 00"-E
164.90'

S/L 5

WEST RIVER ESTATES
P.V. 30 P. 36

R= 25.00'
A= 34.28'
Δ= 78° 34'
C= 31.66'
N-13° 40'-E

S-13° 57'-W

WEST RIVER ROAD

STATE OF OHIO
WILLIAM B. BARTON
4438
REGISTERED SURVEYOR

SURVEY MAP

SUBLOT No. 5
WEST RIVER ESTATES
SUBLOT No. 7
WEST RIVER ESTATES No. 2
CITY OF VERMILION
COUNTY OF LORAIN
STATE OF OHIO

9-16-88